


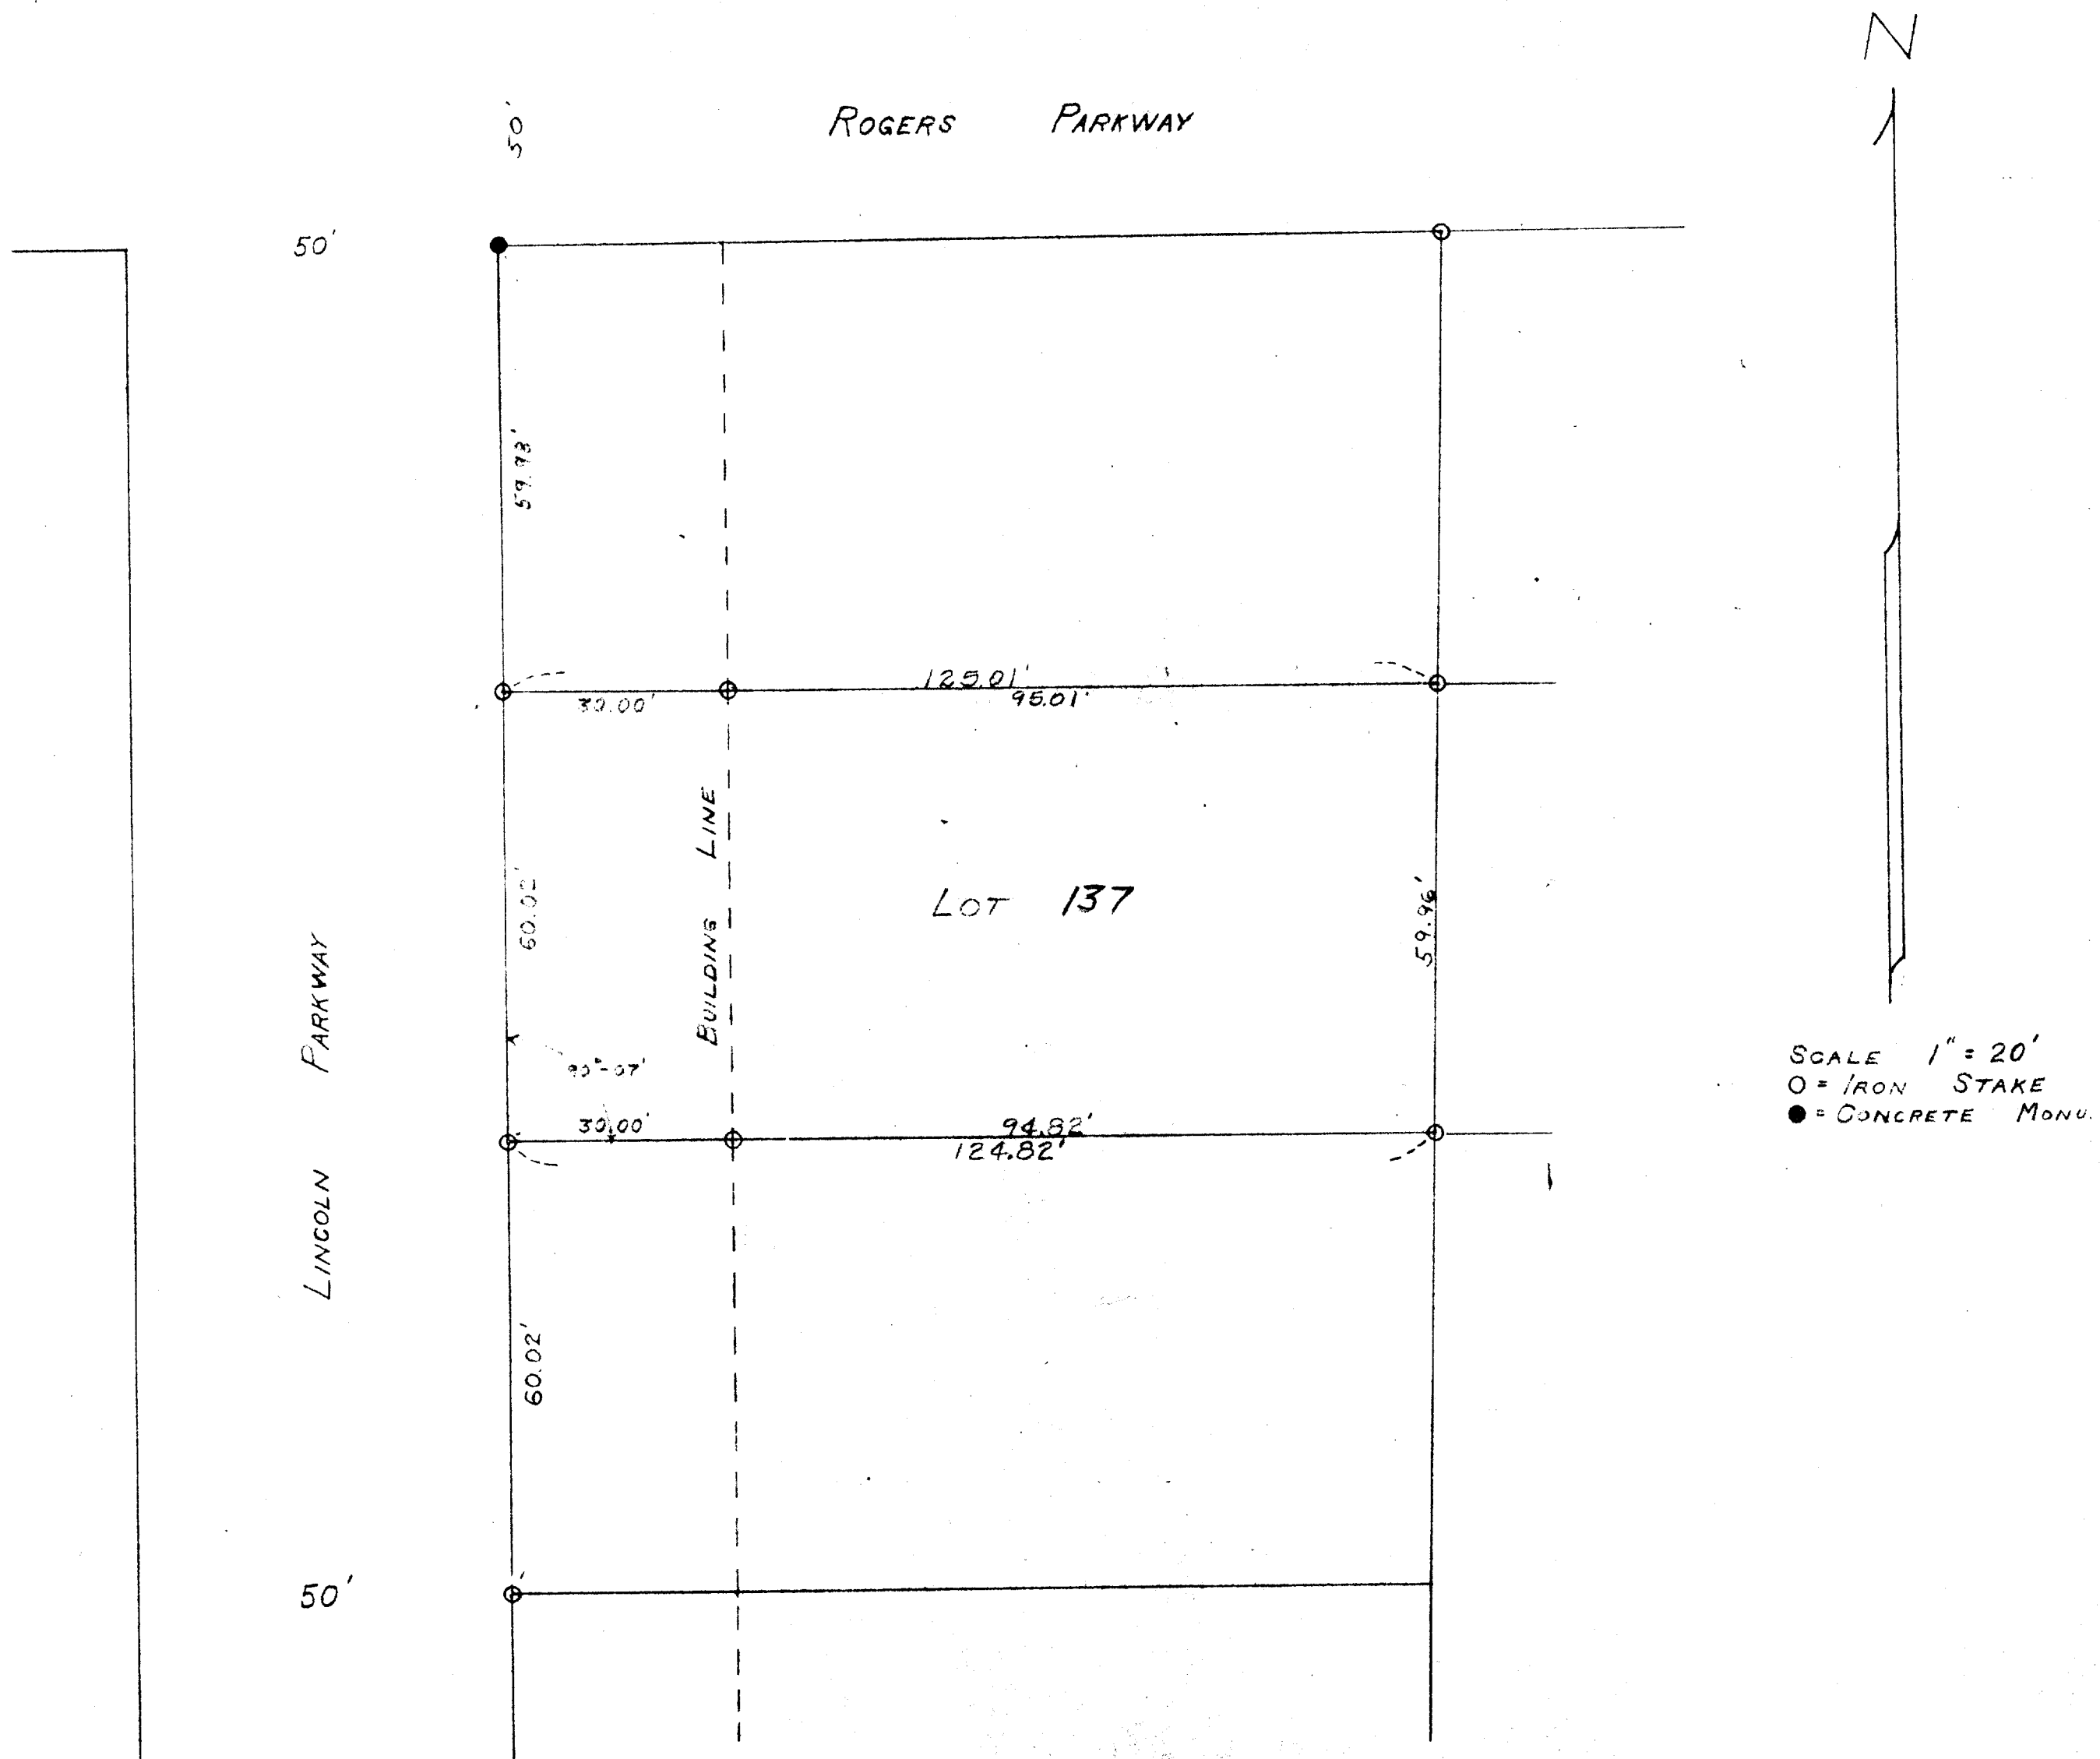

PLAT OF SURVEY OF LOT 137 OF THE ORIGINAL
 PLAT OF CEDAR POINT PARK, LOCATED IN THE
 VILLAGE OF WILLIAMS BAY, WALWORTH COUNTY,
 WISCONSIN.
 MAY 25, 1951

Lloyd L. Jensen
 SURVEYOR

11-102 J