


I HEREBY CERTIFY THAT I HAVE VIEWED THE LAST MENTIONED ABOVE AND THAT THE PLAT DRAWN HEREIN IS A CORRECT REPRESENTATION OF SAID SURVEY. I FURTHER CERTIFY THAT THE BUILDINGS ON SAID LAND ARE LOCATED AS SHOWN ON THIS PLAT.

W. H. DEGEN, LAND SURVEYOR #212
110 N. PINE STREET, BURLINGTON, WISCONSIN.

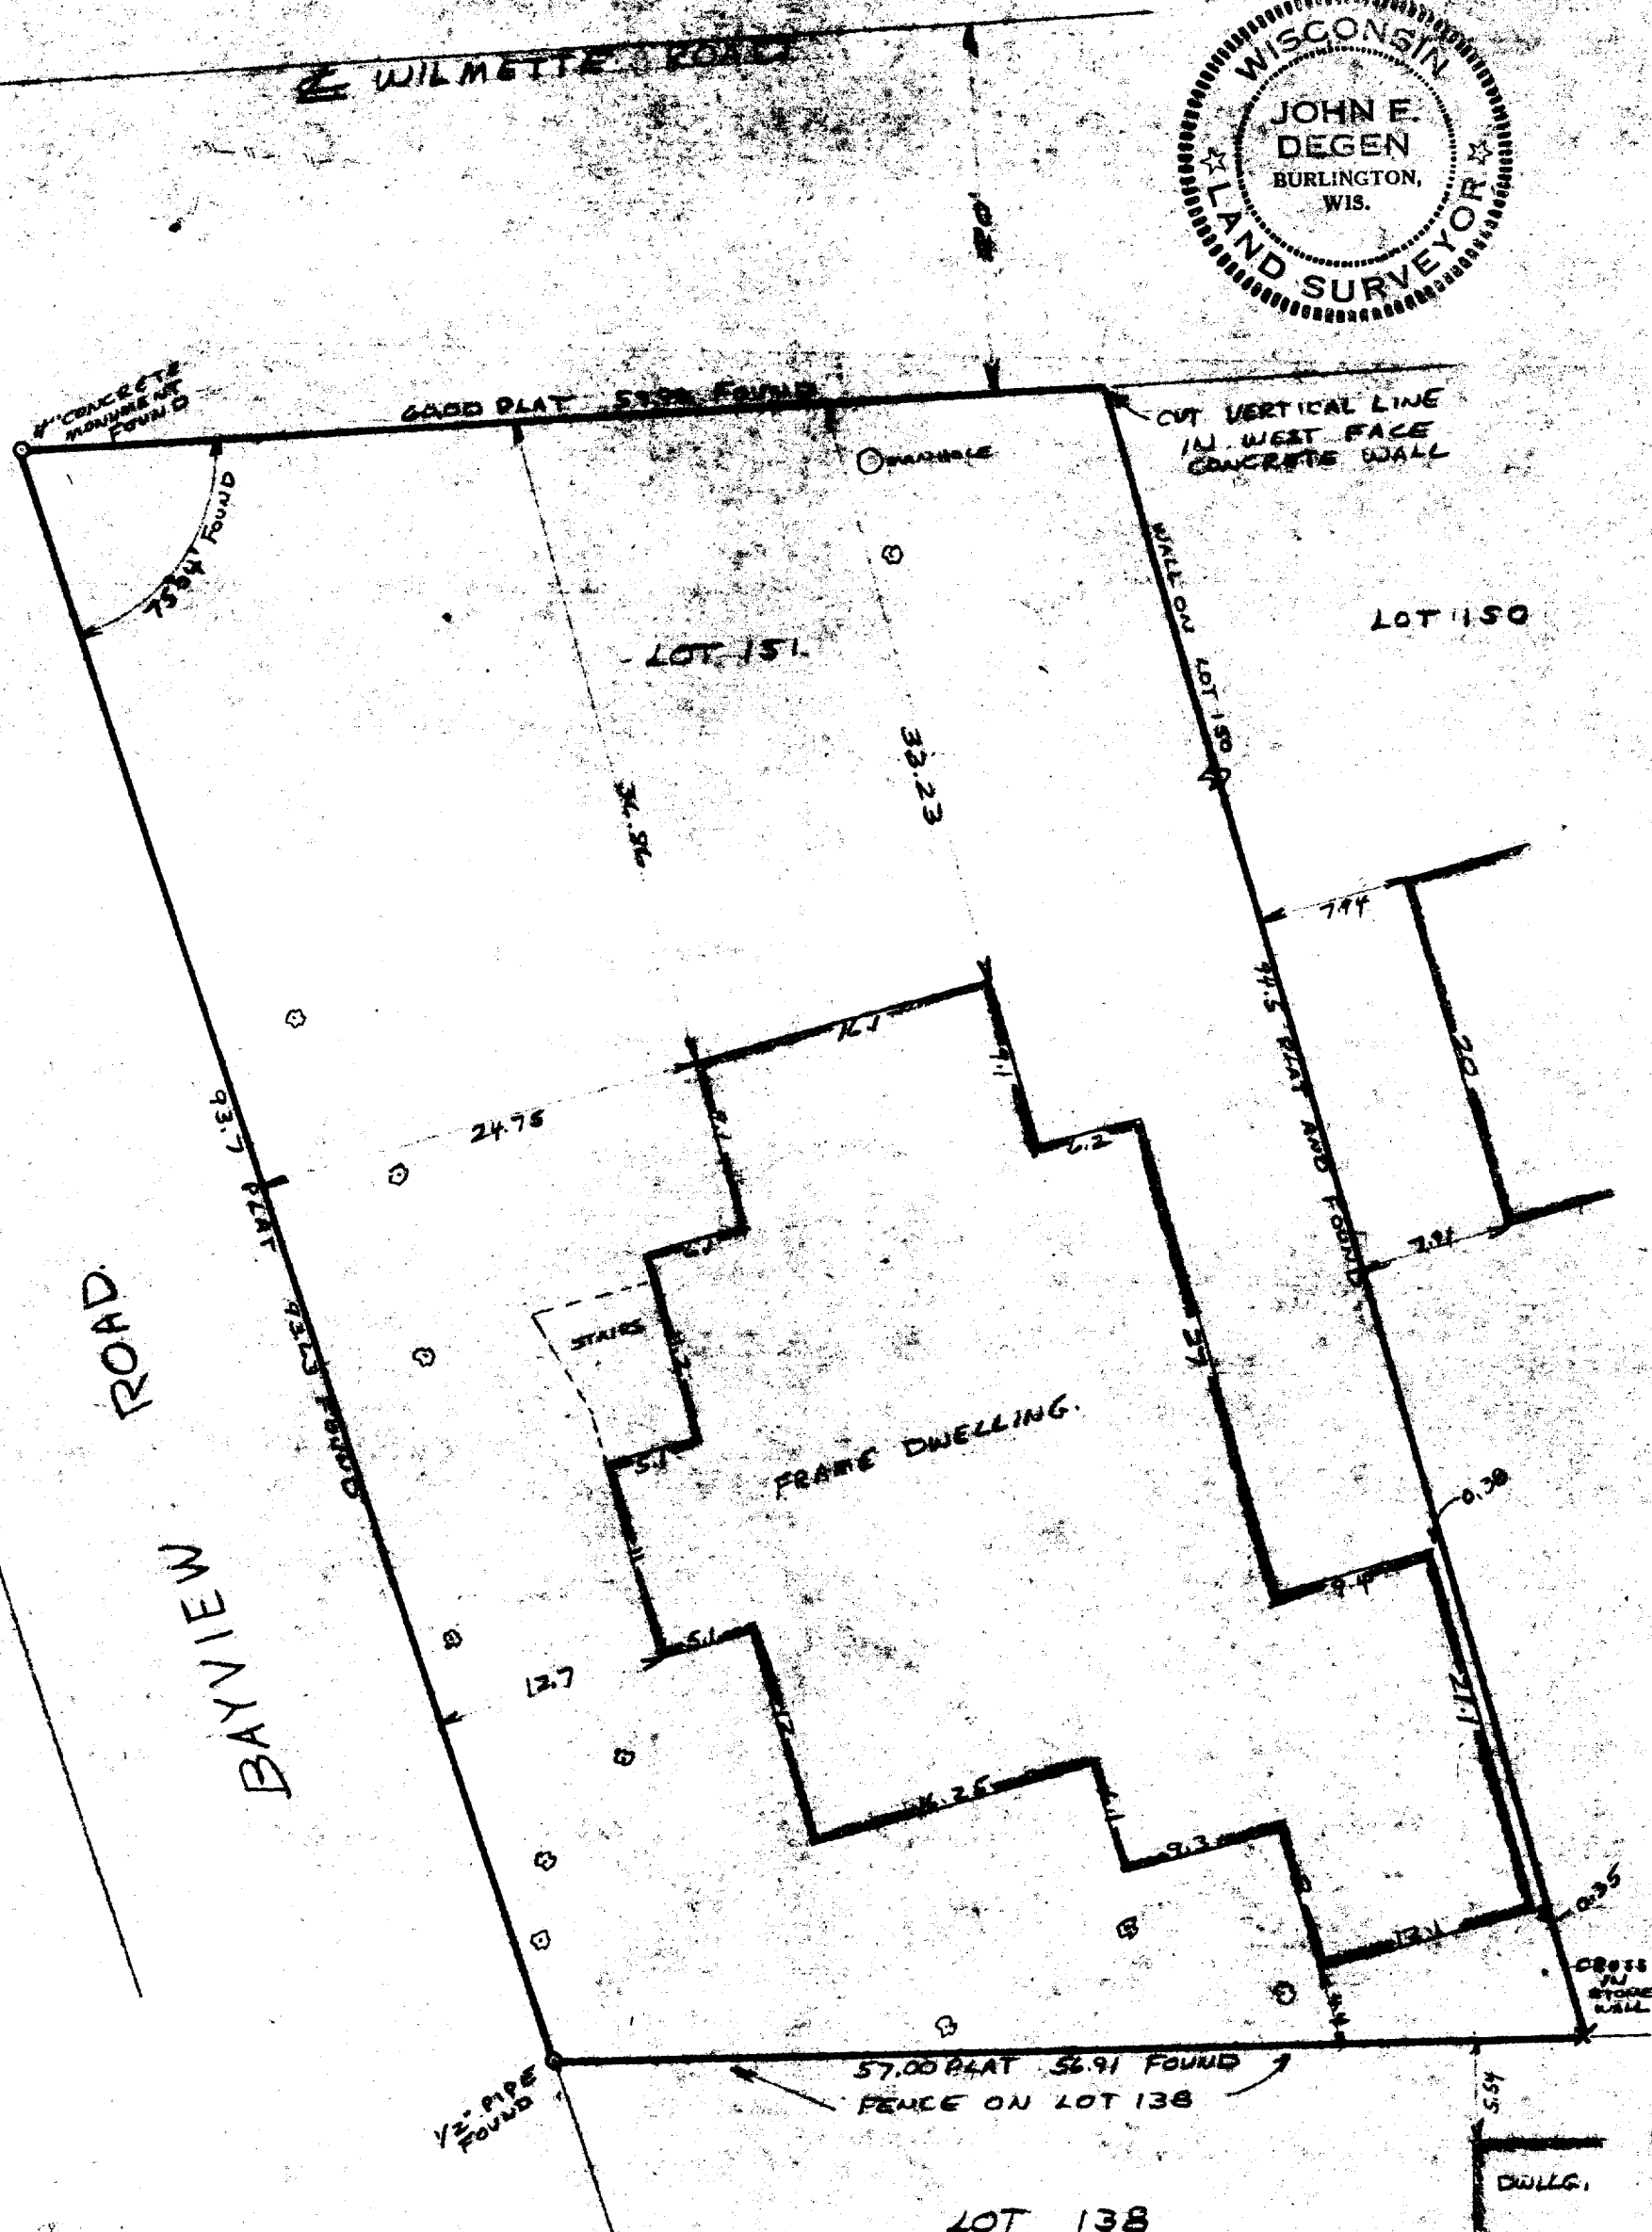

SCALE 1" = 10'
 = TREE.

✓ DRAWER 6-F.
WCP 2-47

11-103
4-8-70