






BAYWOOD HEIGHTS
ADDITION NO. 2
Village of Williams Bay
Walworth County, Wisconsin

PLAT OF SURVEY
of
LOT 74
No. 256 SMYTH DRIVE

FARRIS, HANSEN & ASSOCIATES, INC.
Engineering, Architecture, Surveying
7 Ridgway Court P.O. Box 437
ELKHORN, WISCONSIN 53121
Office: (414) 723-2098
Fax: (414) 723-5886


REVISIONS
ORIG 10/02/90
Proposed Res 8/19/91
AS BUILT 10/11/91

PROJECT NO.
3228
DATE
SHEET NO.
1 of 1

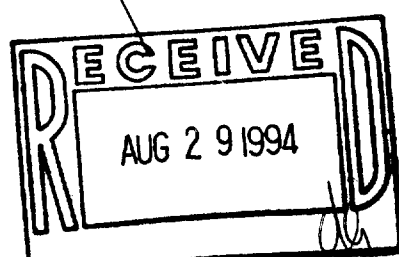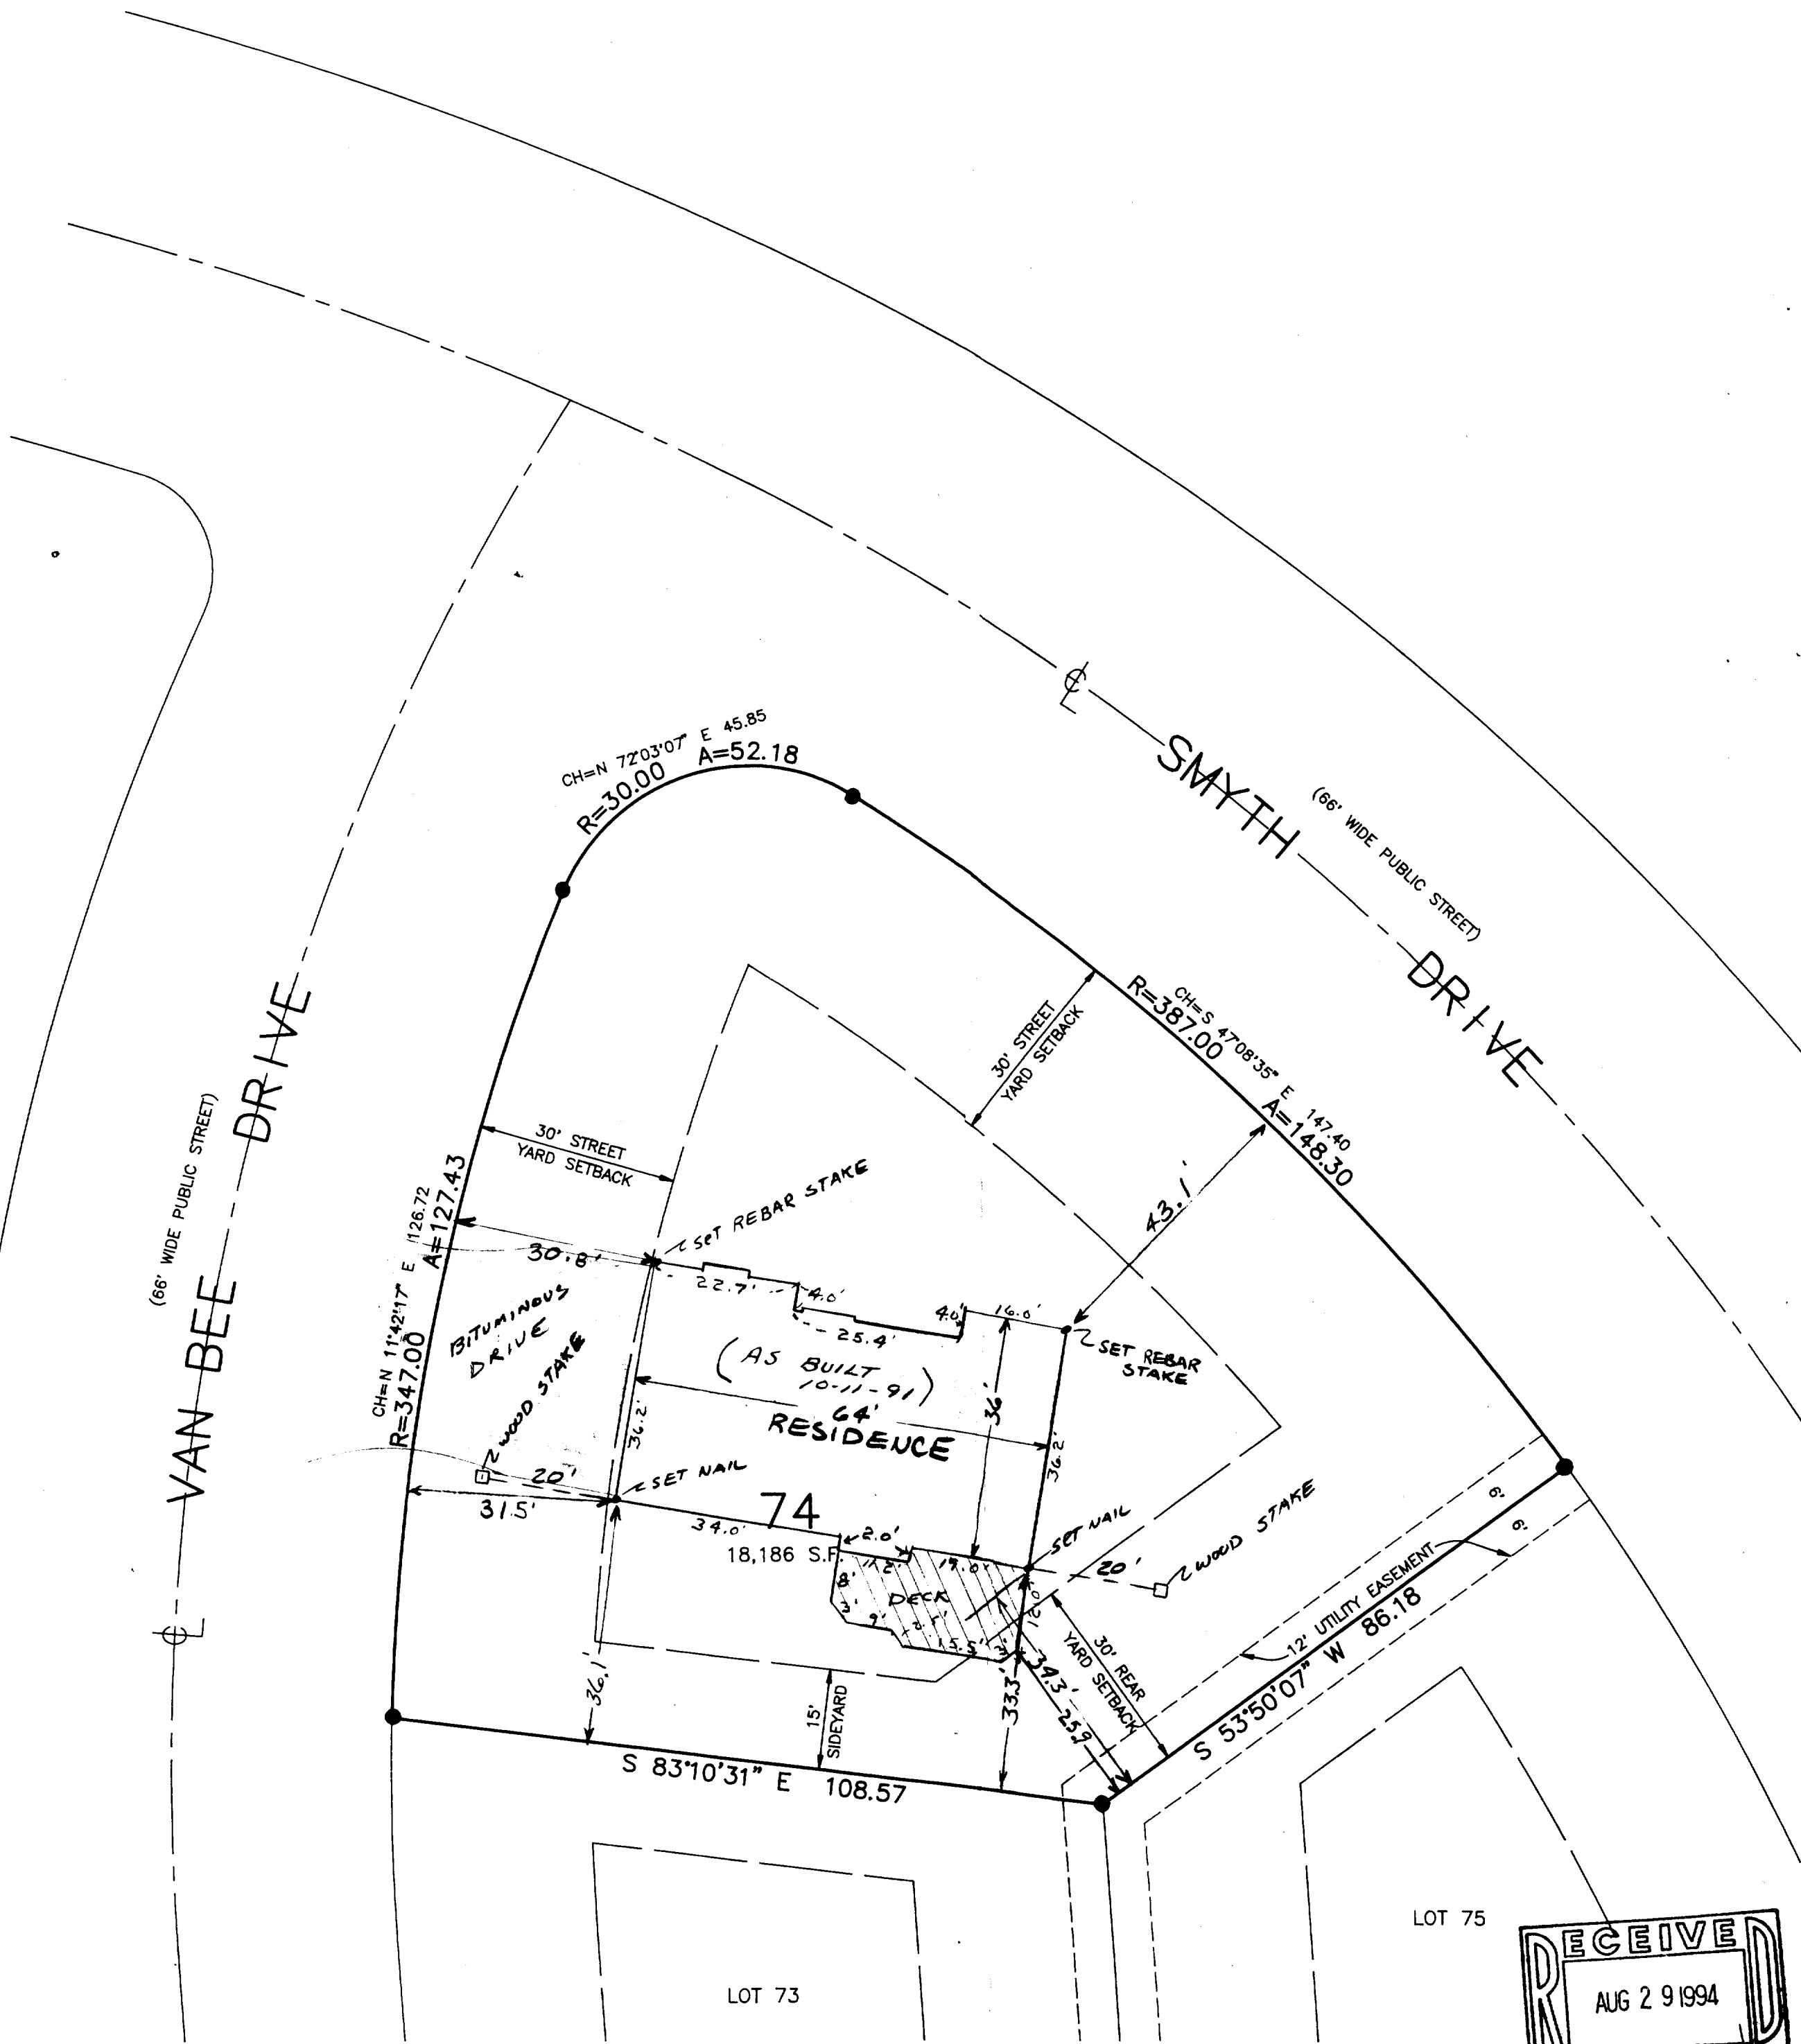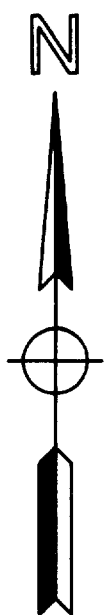

10 5 0 10 20 30 40 50 60 70 80 90
MAP SCALE IN FEET

MAP LEGEND
X = IRON PIPE STAKE FOUND - 1" DIA.
O = IRON PIPE STAKE FOUND - 1.5" DIA.
X = IRON PIPE STAKE FOUND - 2" DIA.
O = IRON REBAR STAKE FOUND - 0.75" DIA.
O = CONCRETE MONUMENT FOUND - 6" DIA.
O = IRON REBAR STAKE SET - 1.2" DIA X 30" X 4.3 LB/FT
ALL OTHER LOT CORNERS - IRON REBAR STAKE SET -
O = SET WOOD STAKE 0.75" DIA. X 24" X 1.3 LB/FT
SETBACKS SHOWN ARE FROM RECORDED SUBDIVISION PLAT.

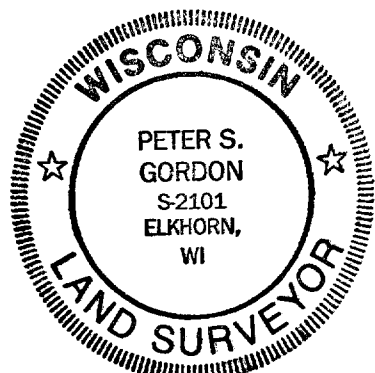

WORK ORDERED BY: LINDA WILLIAMS

LEGAL DESCRIPTION OF LAND SURVEYED:

LOT 74 OF BAYWOOD HEIGHTS ADDITION NO. 2 IN THE VILLAGE OF WILLIAMS BAY, WALWORTH COUNTY, WISCONSIN ACCORDING TO THE PLAT THEREOF RECORDED WITH THE WALWORTH COUNTY REGISTER OF DEEDS IN CABINET B OF PLATS ON SLIDE 97 AS DOCUMENT NO. 197248.

SURVEYOR'S CERTIFICATE

I HEREBY CERTIFY THAT THE PROPERTY DESCRIBED HEREON HAS BEEN SURVEYED UNDER MY DIRECTION AND THAT THIS MAP IS A TRUE REPRESENTATION THEREOF AND SHOWS THE SIZE AND LOCATION OF THE PROPERTY AND ITS EXTERIOR BOUNDARY DIMENSIONS AND MONUMENTS. THIS SURVEY IS MADE FOR THE USE OF THE PRESENT OWNERS OF THE PROPERTY, AND ALSO THOSE WHO PURCHASE, MORTGAGE, OR GUARANTEE THE TITLE THERETO WITHIN ONE YEAR FROM THE DATE HEREOF.

DATED THIS 2ND DAY OF OCT, 1990.

REVISED 8/19/91 TO SHOW PROPOSED RESIDENCE

REVISED 10/11/91 TO SHOW AS BUILT RESIDENCE LOCATION

Peter S. Gordon
SURVEYOR

S-2101
REGISTRATION

RESURVEY 8/6/94
UPDATING + CERTIFYING ALL DETAIL

NOTE: COPIES OF THIS MAP TO WHICH THE ABOVE CERTIFICATE WILL APPLY ARE BLUE LINE PRINTS SHOWING THE SURVEYOR'S ORIGINAL SEAL AND SIGNATURE IN BLACK INK. COPIES BY ANY OTHER MEANS MAY SHOW ALTERATIONS WHICH DO NOT REPRESENT THE SURVEYOR'S WORK PRODUCT.