


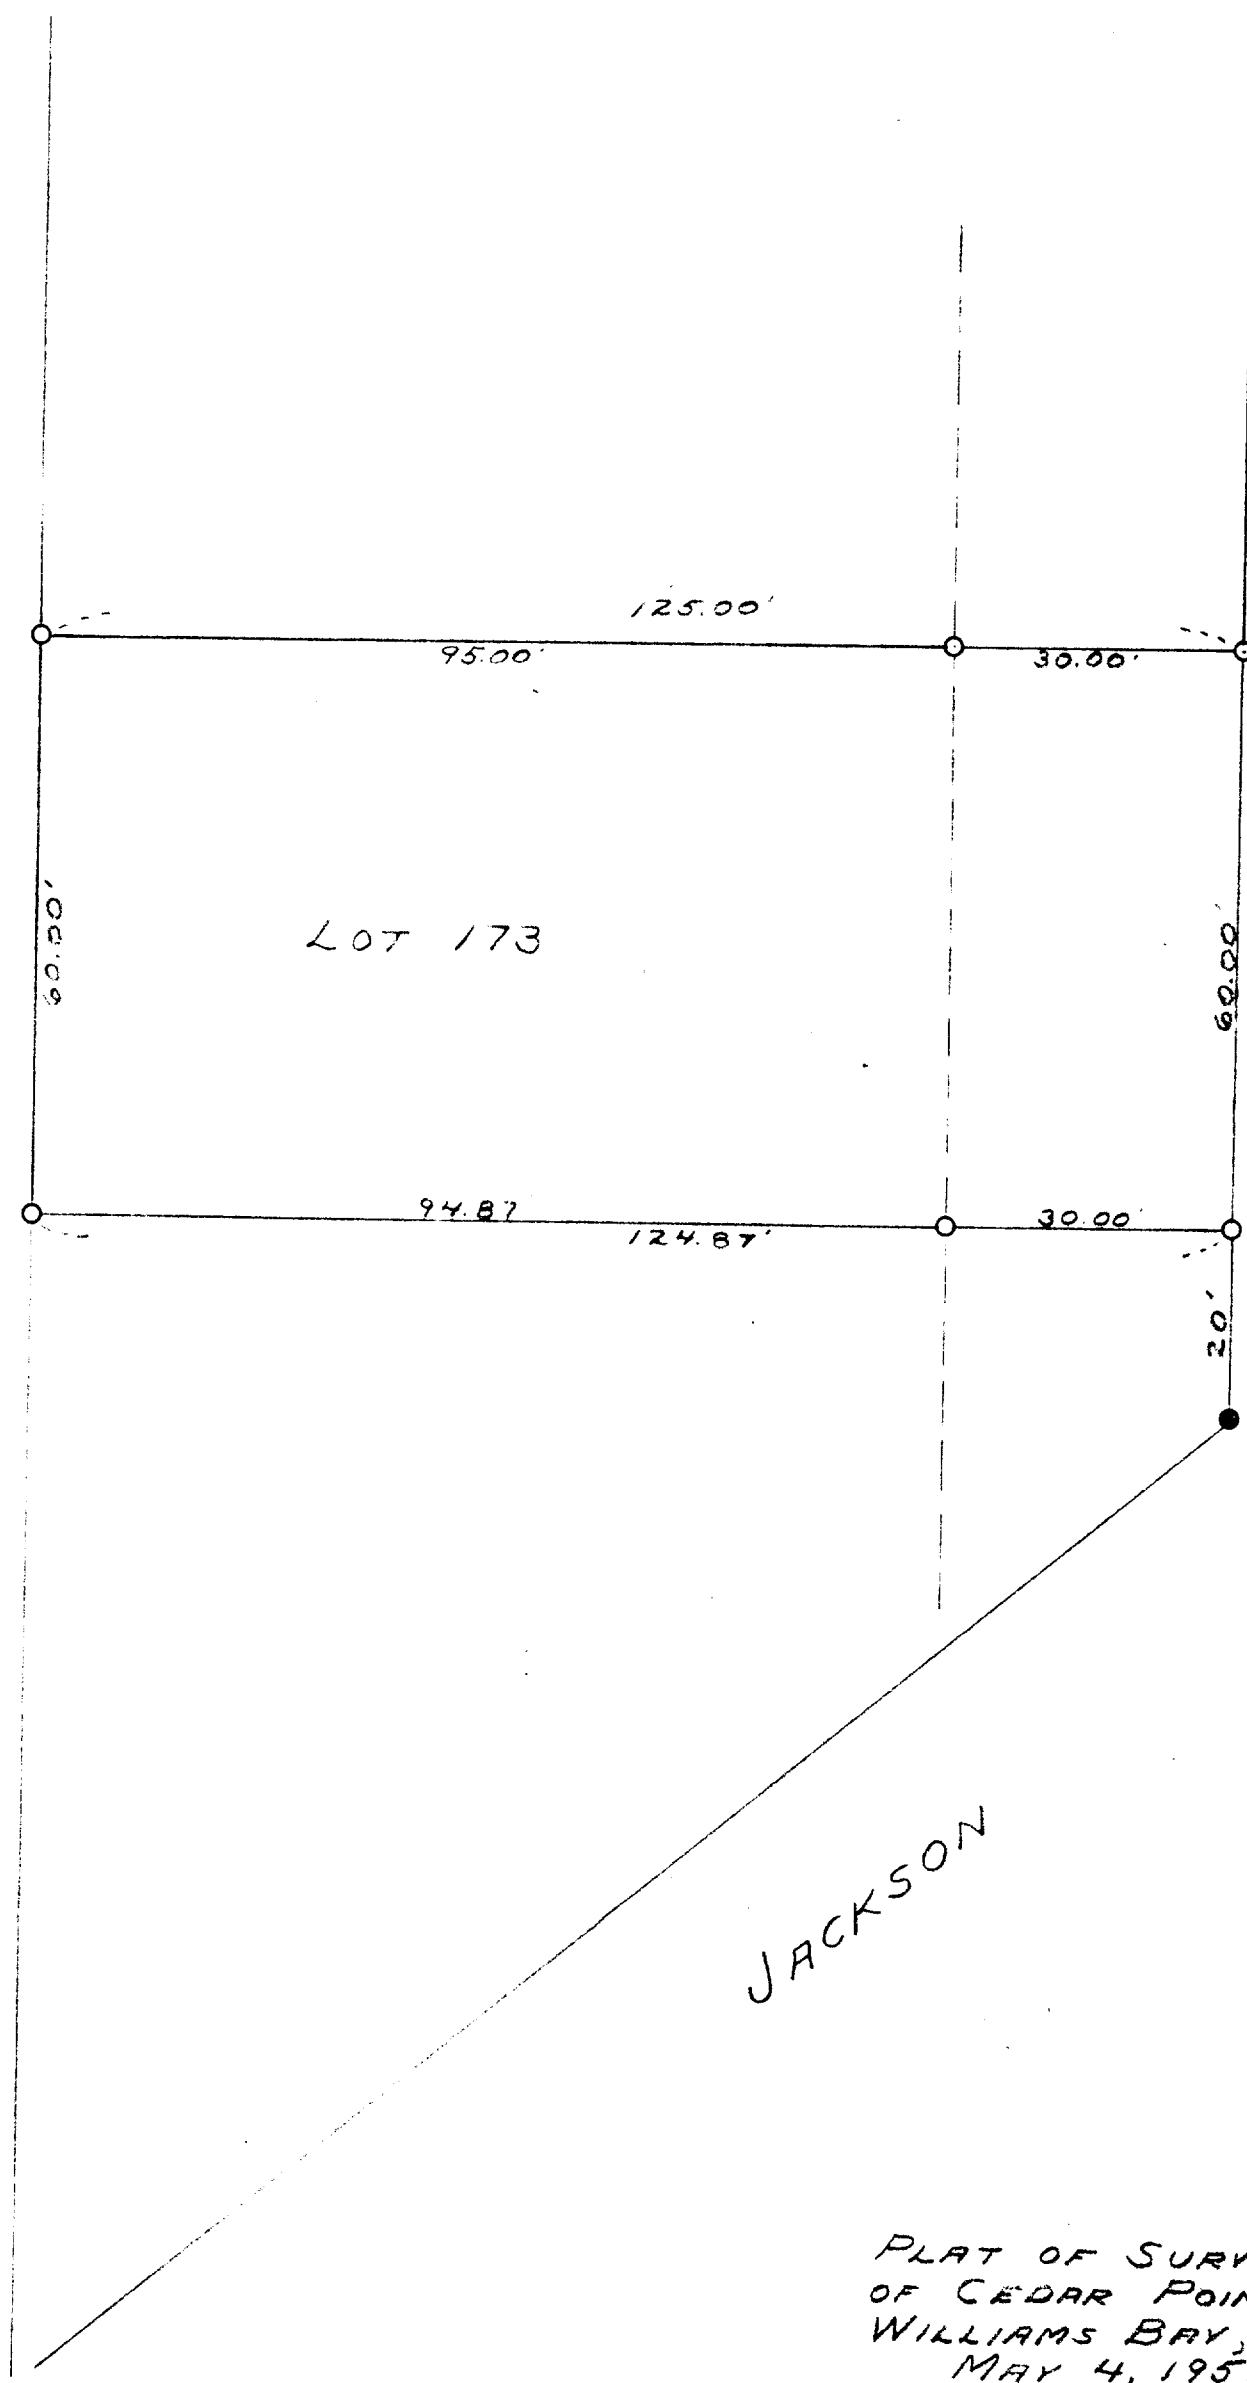

SCALE 1"=20'
 O = IRON STAKE
 ● = CONCRETE MONU.

PLAT OF SURVEY OF LOT 173 OF THE ORIGINAL PLAT
 OF CEDAR POINT PARK, LOCATED IN THE VILLAGE OF
 WILLIAMS BAY, WALWORTH COUNTY, WISCONSIN.
 MAY 4, 1951