



FARRIS, HANSEN & ASSOCIATES, INC.  
ENGINEERING, ARCHITECTURE, SURVEYING  
7 RIDGWAY COURT - P.O. BOX 437, ELKHORN, WISCONSIN 53121  
PHONE: (414) 723-2098 FAX: (414) 723-5886

PLAT OF SURVEY  
LOT 4 OF CSM 2263


LOT 4 OF CSM 2263, RECORDED IN  
VOLUME NO. 11 ON PAGES NO. 69-73  
OF WALWORTH COUNTY CERTIFIED  
SURVEY MAPS; LOCATED IN SECTION  
6, TOWN 1 NORTH, RANGE 17 EAST,  
VILLAGE OF WILLIAMS BAY,  
WALWORTH COUNTY, WISCONSIN

WORK ORDERED BY: THELEN TOTAL  
CONSTRUCTION  
PO BOX 17  
ELKHORN, WI. 53121

DETAIL MAP SCALE 1" = 40'

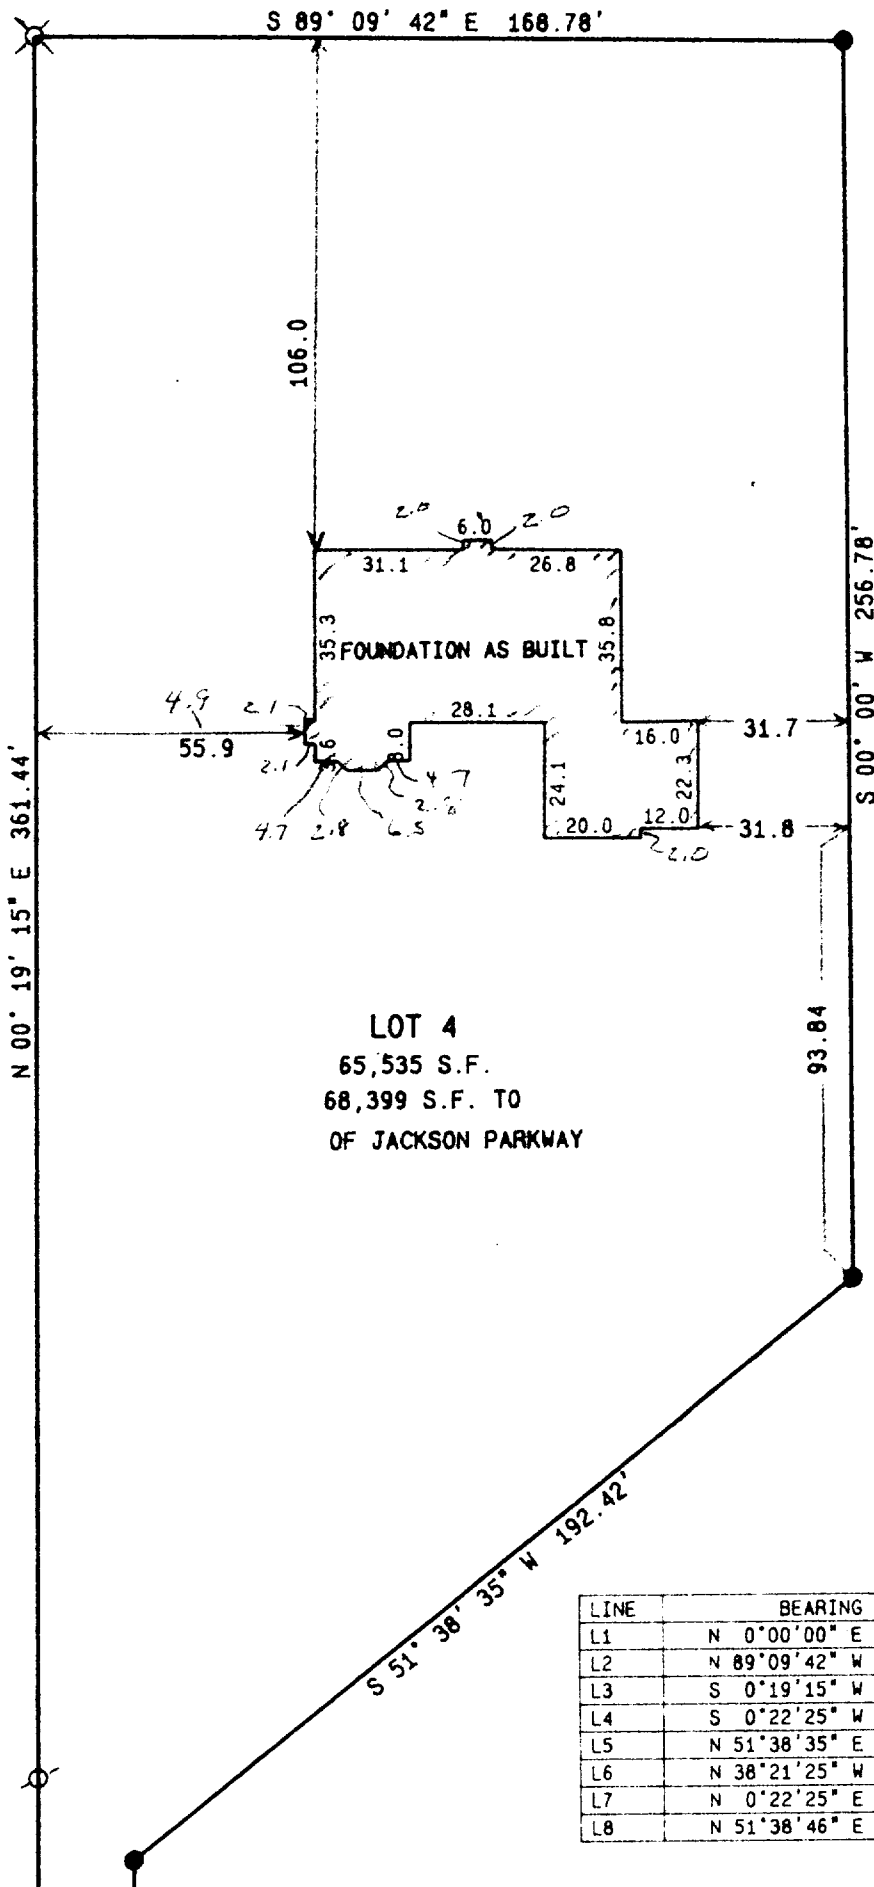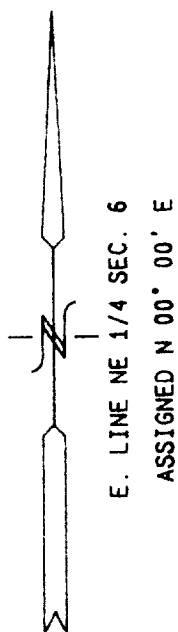

OVERALL LOT SCALE 1" = 200'

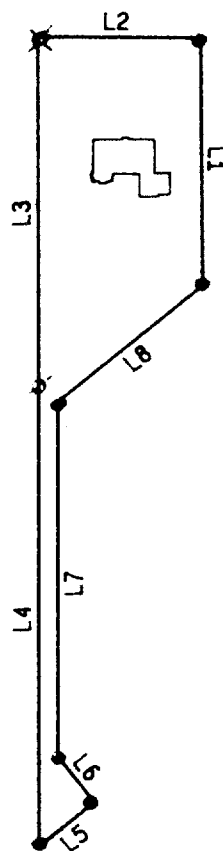



LINE	BEARING	DISTANCE
L1	N 0°00'00" E	256.78
L2	N 89°09'42" W	168.78
L3	S 0°19'15" W	361.44
L4	S 0°22'25" W	476.07
L5	N 51°38'35" E	73.53
L6	N 38°21'25" W	59.71
L7	N 0°22'25" E	366.40
L8	N 51°38'46" E	192.42

NOTE: COPIES OF THIS MAP TO WHICH THE FOLLOWING CERTIFICATE WILL APPLY ARE BLUE LINE PRINTS SHOWING SURVEYOR'S ORIGINAL SEAL AND SIGNATURE IN BLACK INK. COPIES BY ANY OTHER MEANS MAY HAVE ALTERATIONS WHICH DO NOT REPRESENT THE SURVEYOR'S WORK PRODUCT.

I HEREBY CERTIFY THAT THE ABOVE DESCRIBED PROPERTY HAS BEEN SURVEYED UNDER MY DIRECTION AND THAT THE ABOVE MAP IS A TRUE REPRESENTATION THEREOF AND SHOWS THE SIZE AND LOCATION OF THE PROPERTY AND ITS EXTERIOR BOUNDARIES. THIS SURVEY IS MADE FOR THE USE OF THE PRESENT OWNERS OF THE PROPERTY, AND ALSO THOSE WHO PURCHASE, MORTGAGE, OR GUARANTEE THE TITLE THERETO WITHIN ONE YEAR FROM THE DATE HEREOF.

DATED: 9/14/95

PETER S. GORDON R.L.S. 2101

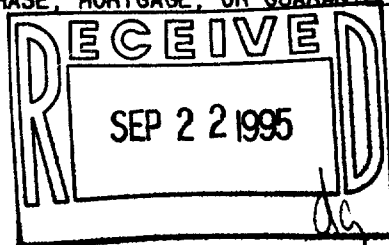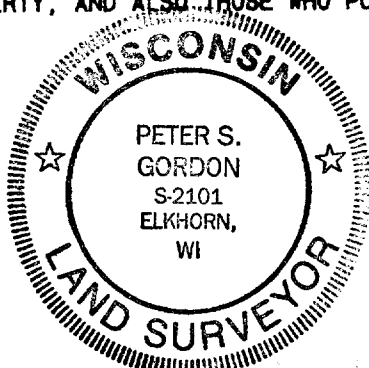

PROJ 3634.04  
SHEET 1 OF 1

WA-2263-4

011-1119