
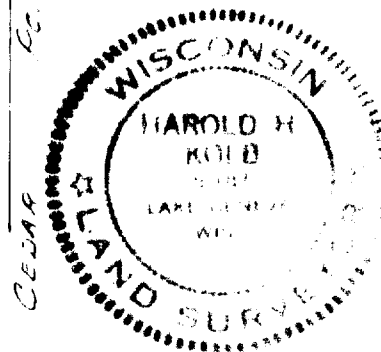


HAROLD H. KOLB


REGISTERED PROFESSIONAL LAND SURVEYOR
LAKE GENEVA, WISCONSIN

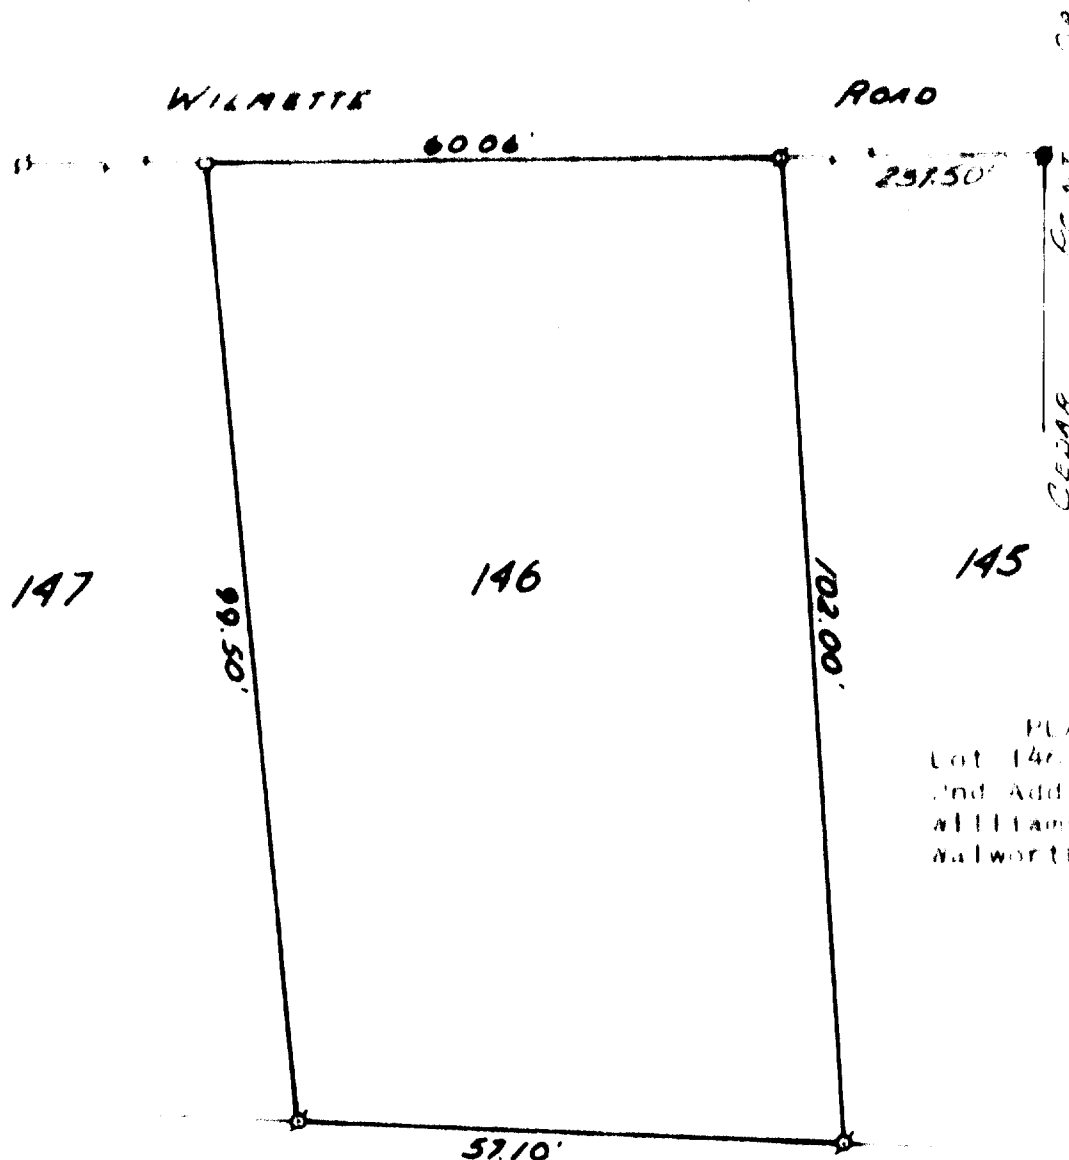

PLAT OF SURVEY OF
Lot 146, Cedar Point Park
and Addition, Village of
William Bay, T. 1 N., R. 12 E.,
Walworth County, Wisconsin

LEGEND

- ▲ IRON PIPE FOUND
- IRON PIPE PLACED
- CONCRETE MONUMENT
- ✕ SPIKE

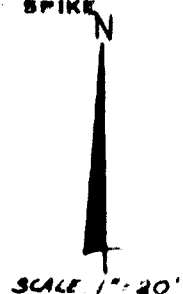

I, HAROLD H. KOLB, DO HEREBY CERTIFY THAT I HAVE
SURVEYED THE PROPERTY HEREON DESCRIBED ACCORDING
TO THE OFFICIAL RECORDS, AND THAT THE PLAT HEREON
IS A CORRECT REPRESENTATION OF THE LOT LINES.

Harold H. Kolb
HAROLD H. KOLB
WISCONSIN REGISTERED LAND SURVEYOR, S-187
DATE October 3, 1968