


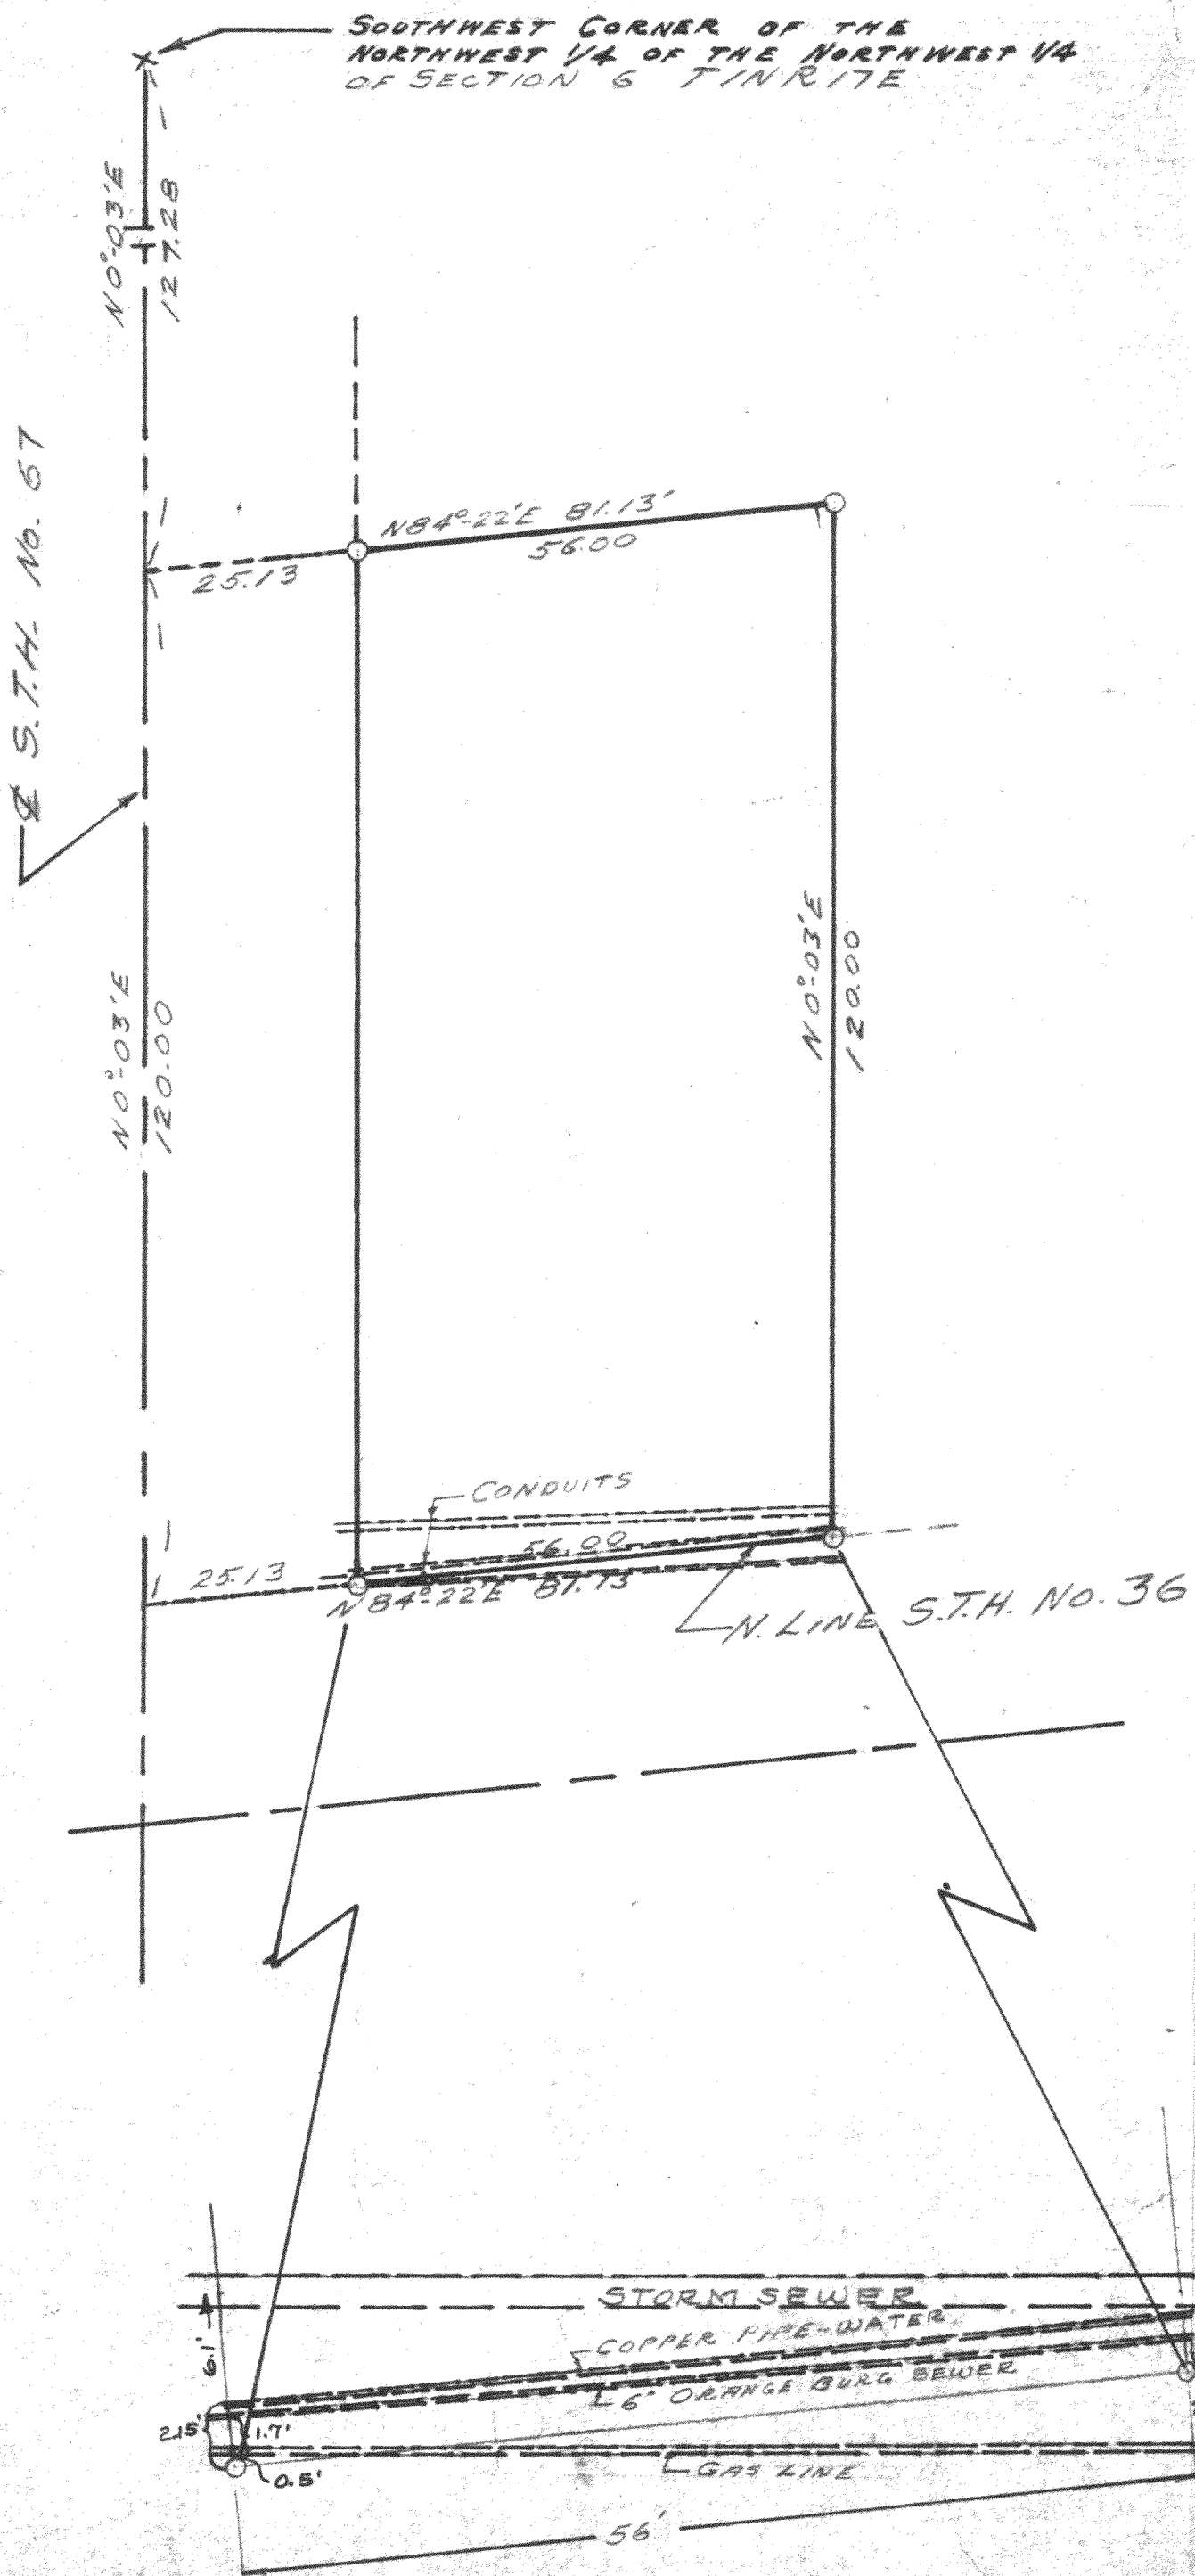

PLAT OF SURVEY OF

LAND
LOCATED IN THE SOUTHWEST
1/4 OF THE NORTHWEST 1/4 OF
SECTION 6 T17N R17E
WALWORTH CO., WISCONSIN

Lloyd L. Jensen
SURVEYOR

SCALE 1" = 20'

DATE AUG. 23, 1939

UP-47

11-116 J