


# Services Offered

Commercial Site Development  
Subdivision Design and Platting  
Planning and Plan Review  
Streets and Highway Design  
Drainage Studies  
Water Distribution Systems  
Sewer Collection Systems  
Construction Surveying and Stake-out Services  
GPS Surveying  
Certified Soil Testing

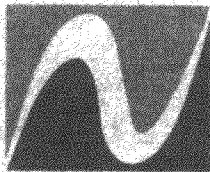

**Nienow Engineering Assoc.**  
Consulting Engineers and Surveyors  
229 E. Main Street  
Waterford, WI 53185  
(414) 534-9190 Fax (414) 534-9192

962849  
962849S1.DWG


## PLAT OF SURVEY

LOT 4 OF BLOCK 1, LAKEWOOD TRAILS SUBDIVISION,  
LOCATED IN THE NORTHEAST 1/4 AND THE NORTHWEST 1/4 OF THE NORTHWEST 1/4 OF  
SECTION 1, TOWN 1 NORTH, RANGE 16 EAST,  
VILLAGE OF WILLIAMS BAY, WALWORTH COUNTY, WISCONSIN

**LAKEWOOD DRIVE**  
(66' WIDE)

BENCHMARK  
TOP OF IRON ROD  
ELEV: 1026.60


SURVEY PREPARED FOR:  
D.B.I. HOME BUILDERS  
BOX 5360 RFD  
LONGROVE, IL 60047

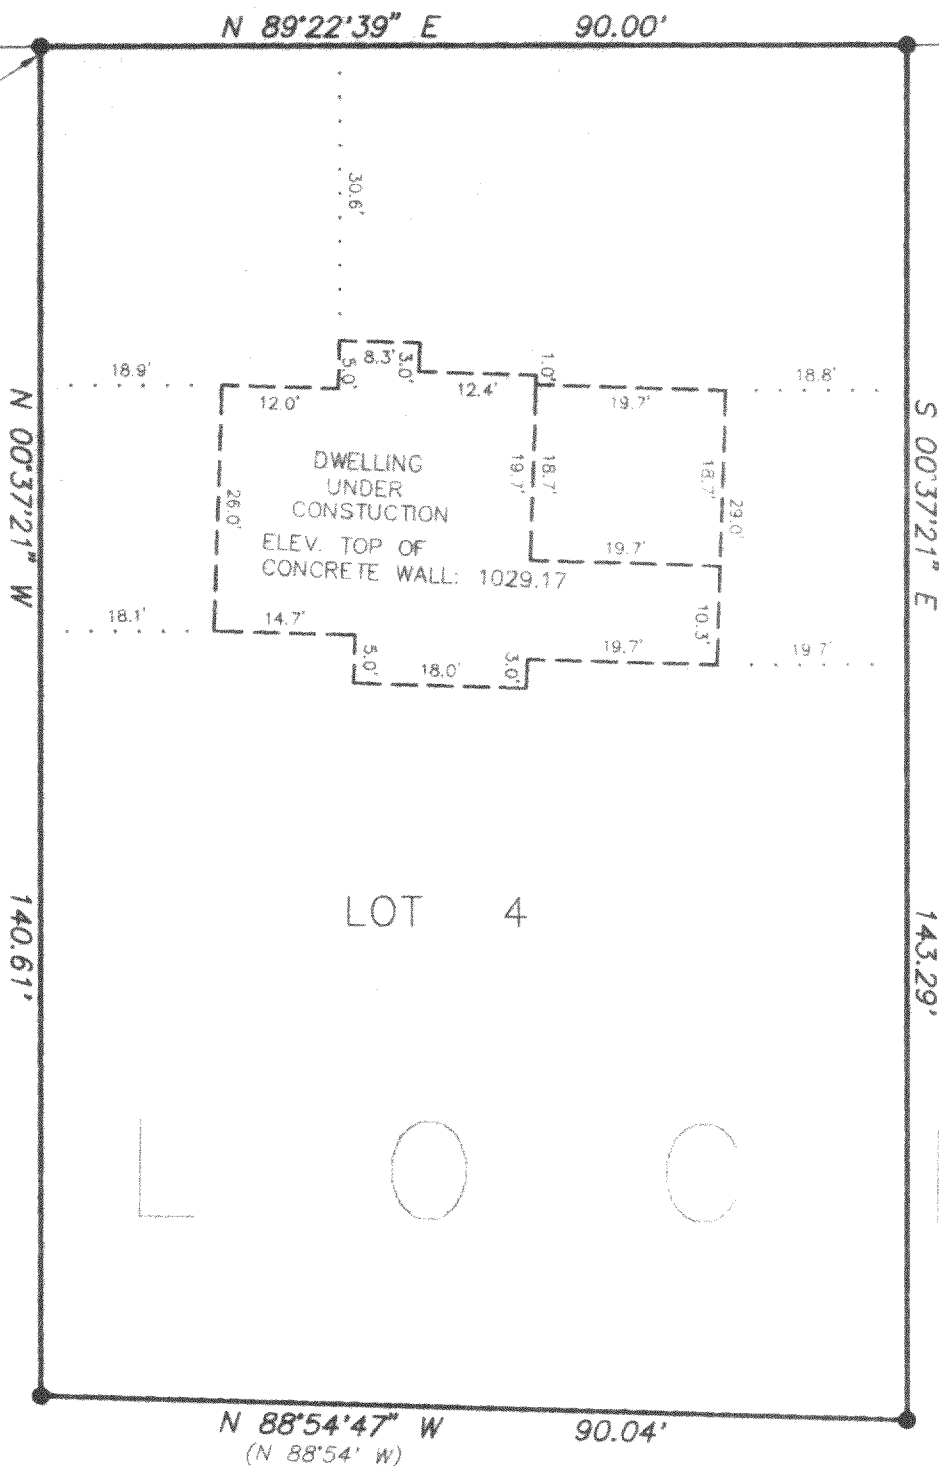

### LEGEND


- - FOUND IRON ROD
- ( ) - RECORDED AS

BEARINGS BASED ON  
NORTH LINE OF LOT 4, BLOCK 1  
LAKEWOOD TRAILS SUBDIVISION  
RECORDED BEARING: N 89°22'39" E

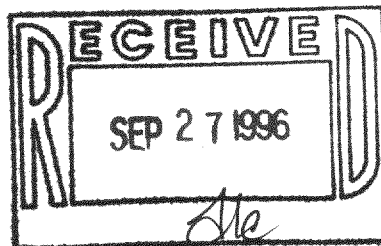

STATE OF WISCONSIN )  
RACINE COUNTY )

SCALE: 1" = 20'

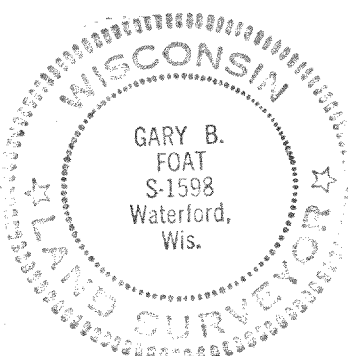

I HEREBY CERTIFY THAT I HAVE SURVEYED THE ABOVE DESCRIBED PROPERTY AND THE ABOVE MAP IS A TRUE REPRESENTATION THEREOF AND SHOWS THE SIZE AND LOCATION OF THE PROPERTY, THE LOCATION OF ALL VISIBLE STRUCTURES AND DIMENSIONS OF ALL PRINCIPAL BUILDINGS THEREON, BOUNDARY FENCES, APPARENT EASEMENTS, ROADWAY AND VISIBLE ENCROACHMENTS, IF ANY.

THIS SURVEY IS MADE FOR THE PRESENT OWNERS OF THE PROPERTY, AND ALSO THOSE WHO PURCHASE, OR GUARANTEE THE TITLE THERETO WITHIN (1) YEAR FROM THE DATE HEREOF.

DATED AT WATERFORD THIS 26TH DAY OF AUGUST 19 96

RECERTIFIED 8-26-96 Jay B. Foat

WLAK-4

11-1178