
414-537-4221

OF

Lot 15, BAYWOOD HEIGHTS SUBDIVISION, located in the Southeast Quarter of the Northwest Quarter and Southwest Quarter of the Northwest Quarter of Section 1, Town 1 North, Range 16 East of the 4th Principal Meridian, lying and being in the Village of Williams Bay, Walworth County, Wisconsin.

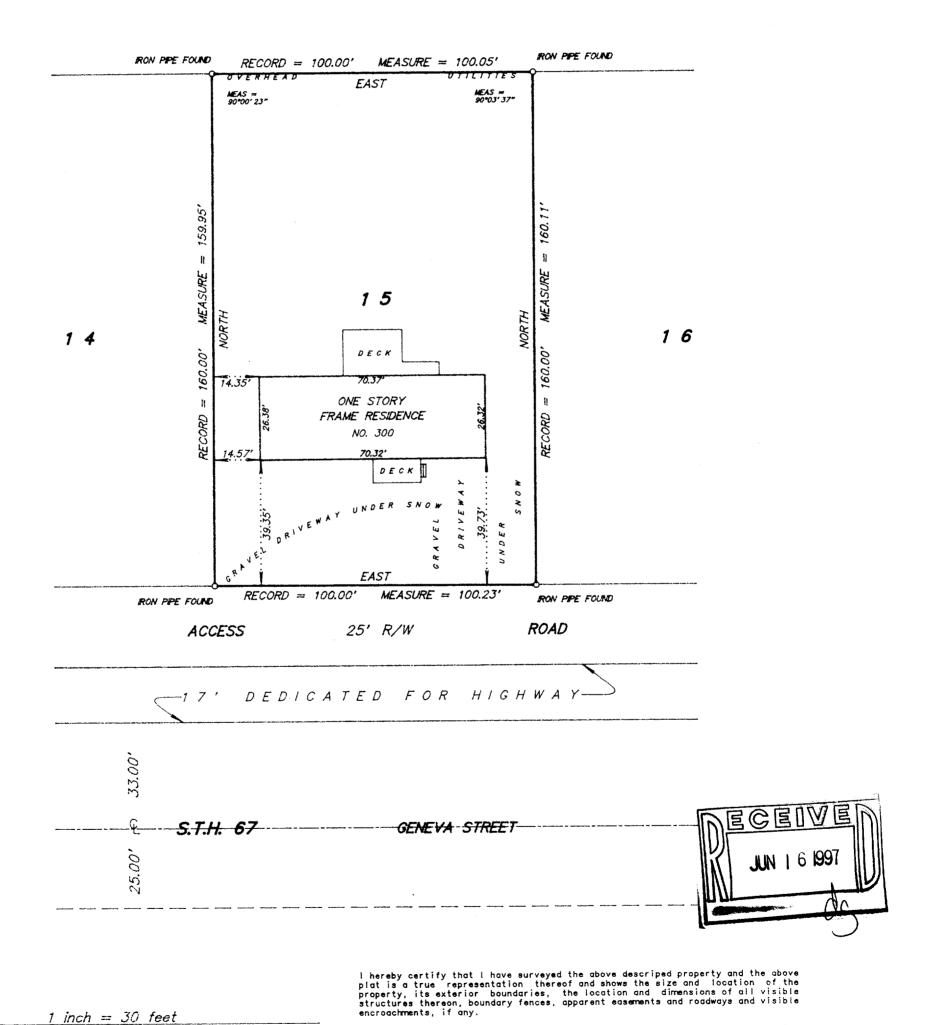

This survey is made for the exclusive use of the present owners of the property, and also those who purchase, mortgage, or guarentee the title thereto within one year from the date hereof.

Dated at Bassett, Wisconsin this _____ day of _____ 1997.

Wisconsin Registered Land Surveyor S - 1784

Mark A. Bolender

SCALE 1 inch = 30 feet

JOB NO. 97007

ORDERED BY D. Schiltz/ Davison, Mulligan & Schiltz, LTD.