


50' JEFFERSON PLACE

50'

20'

CEDAR POINT DRIVE

DRIVEWAY

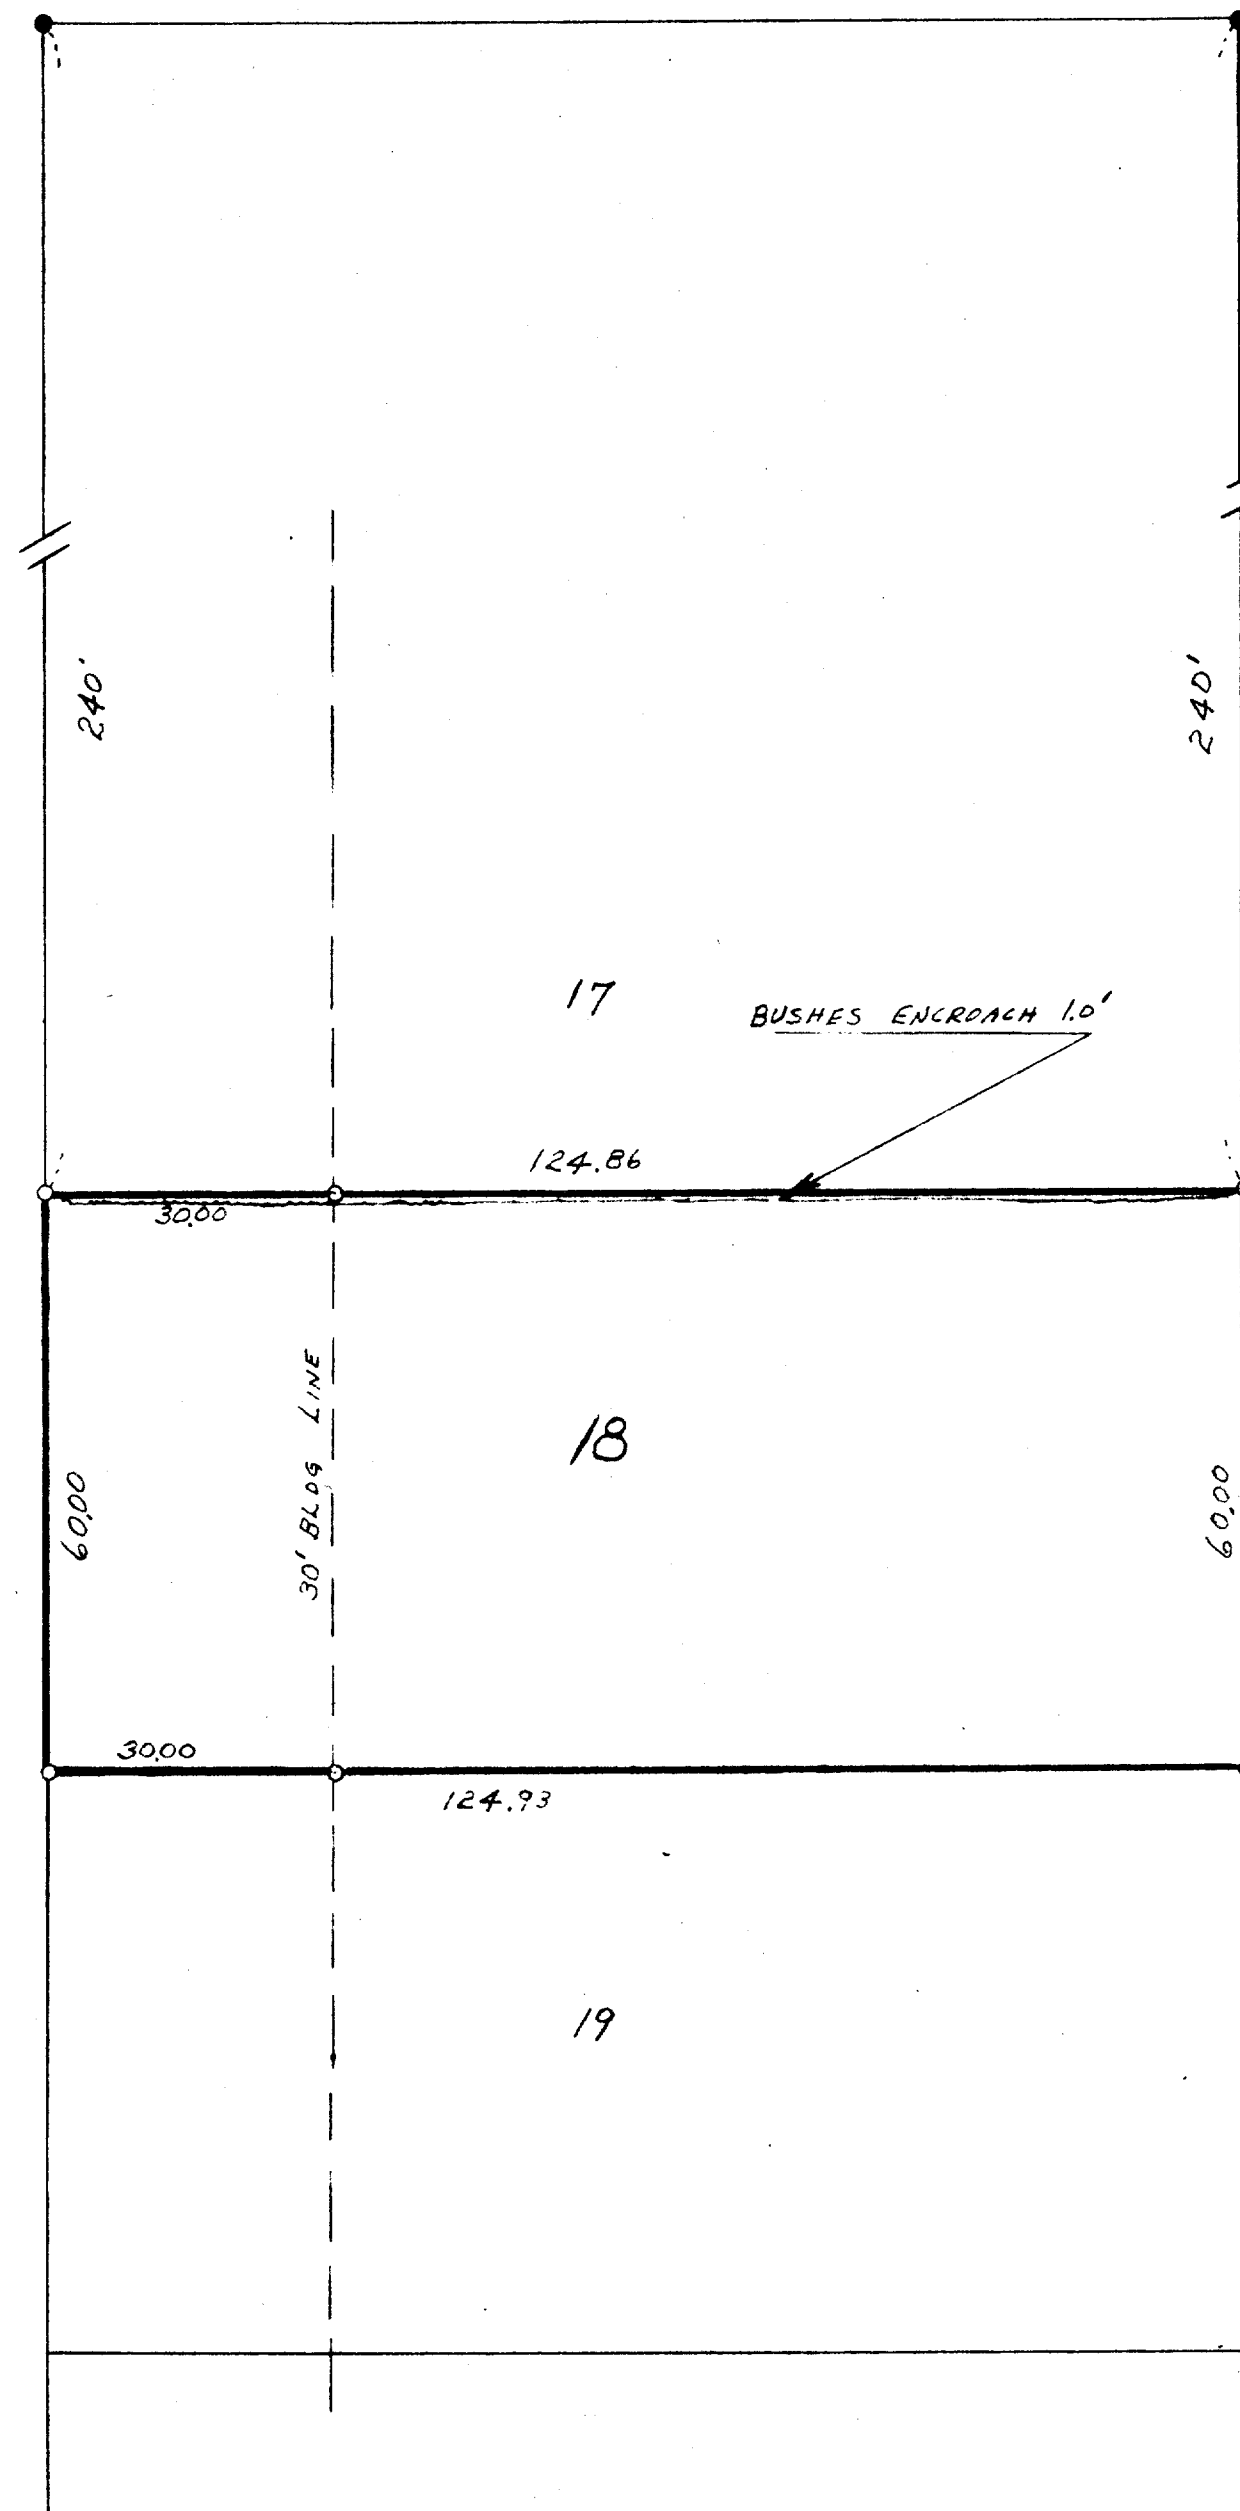

- - CONCRETE MONUMENT
- - IRON PIPE

PLAT OF SURVEY
OF

LOT 18

OF
CEDAR POINT PARK SUBDIVISION
IN THE

VILLAGE OF WILLIAMS BAY,
WALWORTH COUNTY, WISCONSIN

Lloyd S. Jensen
SURVEYOR

SCALE 1" = 20'

DATE FEB. 1954