


**REGISTERED PROFESSIONAL LAND SURVEYOR
LAKE GENEVA, WISCONSIN**




Lot 23, Cedar Point Park First Addition,
Village of Williams Bay, Walworth County,
Wisconsin..

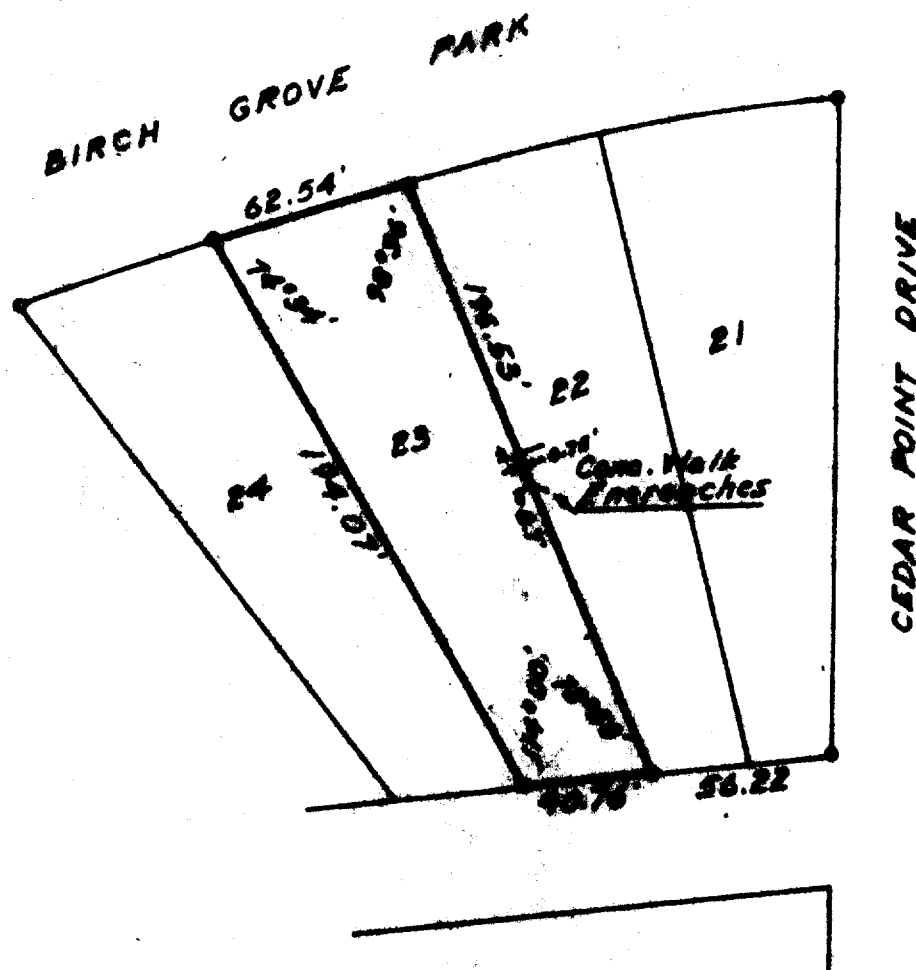

LEGEND

- # - IRON PIPE FOUND
- - IRON PIPE PLACED
- - CONCRETE MONUMENT
- X - SPIKE

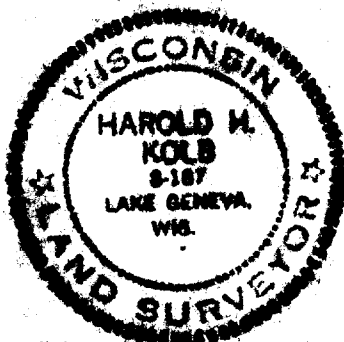

I, HAROLD H. KOLB, DO HEREBY CERTIFY THAT I HAVE SURVEYED THE PROPERTY HEREON DESCRIBED ACCORDING TO THE OFFICIAL RECORDS, AND THAT THE FLAT HEREON IS A CORRECT REPRESENTATION OF THE LOT LINES.

HAROLD H. KOLB
HAROLD H. KOLB

WISCONSIN REGISTERED LAND SURVEYOR, 9-187

DATE May 10, 1966

REVISED: May 28, 1966

11-129