


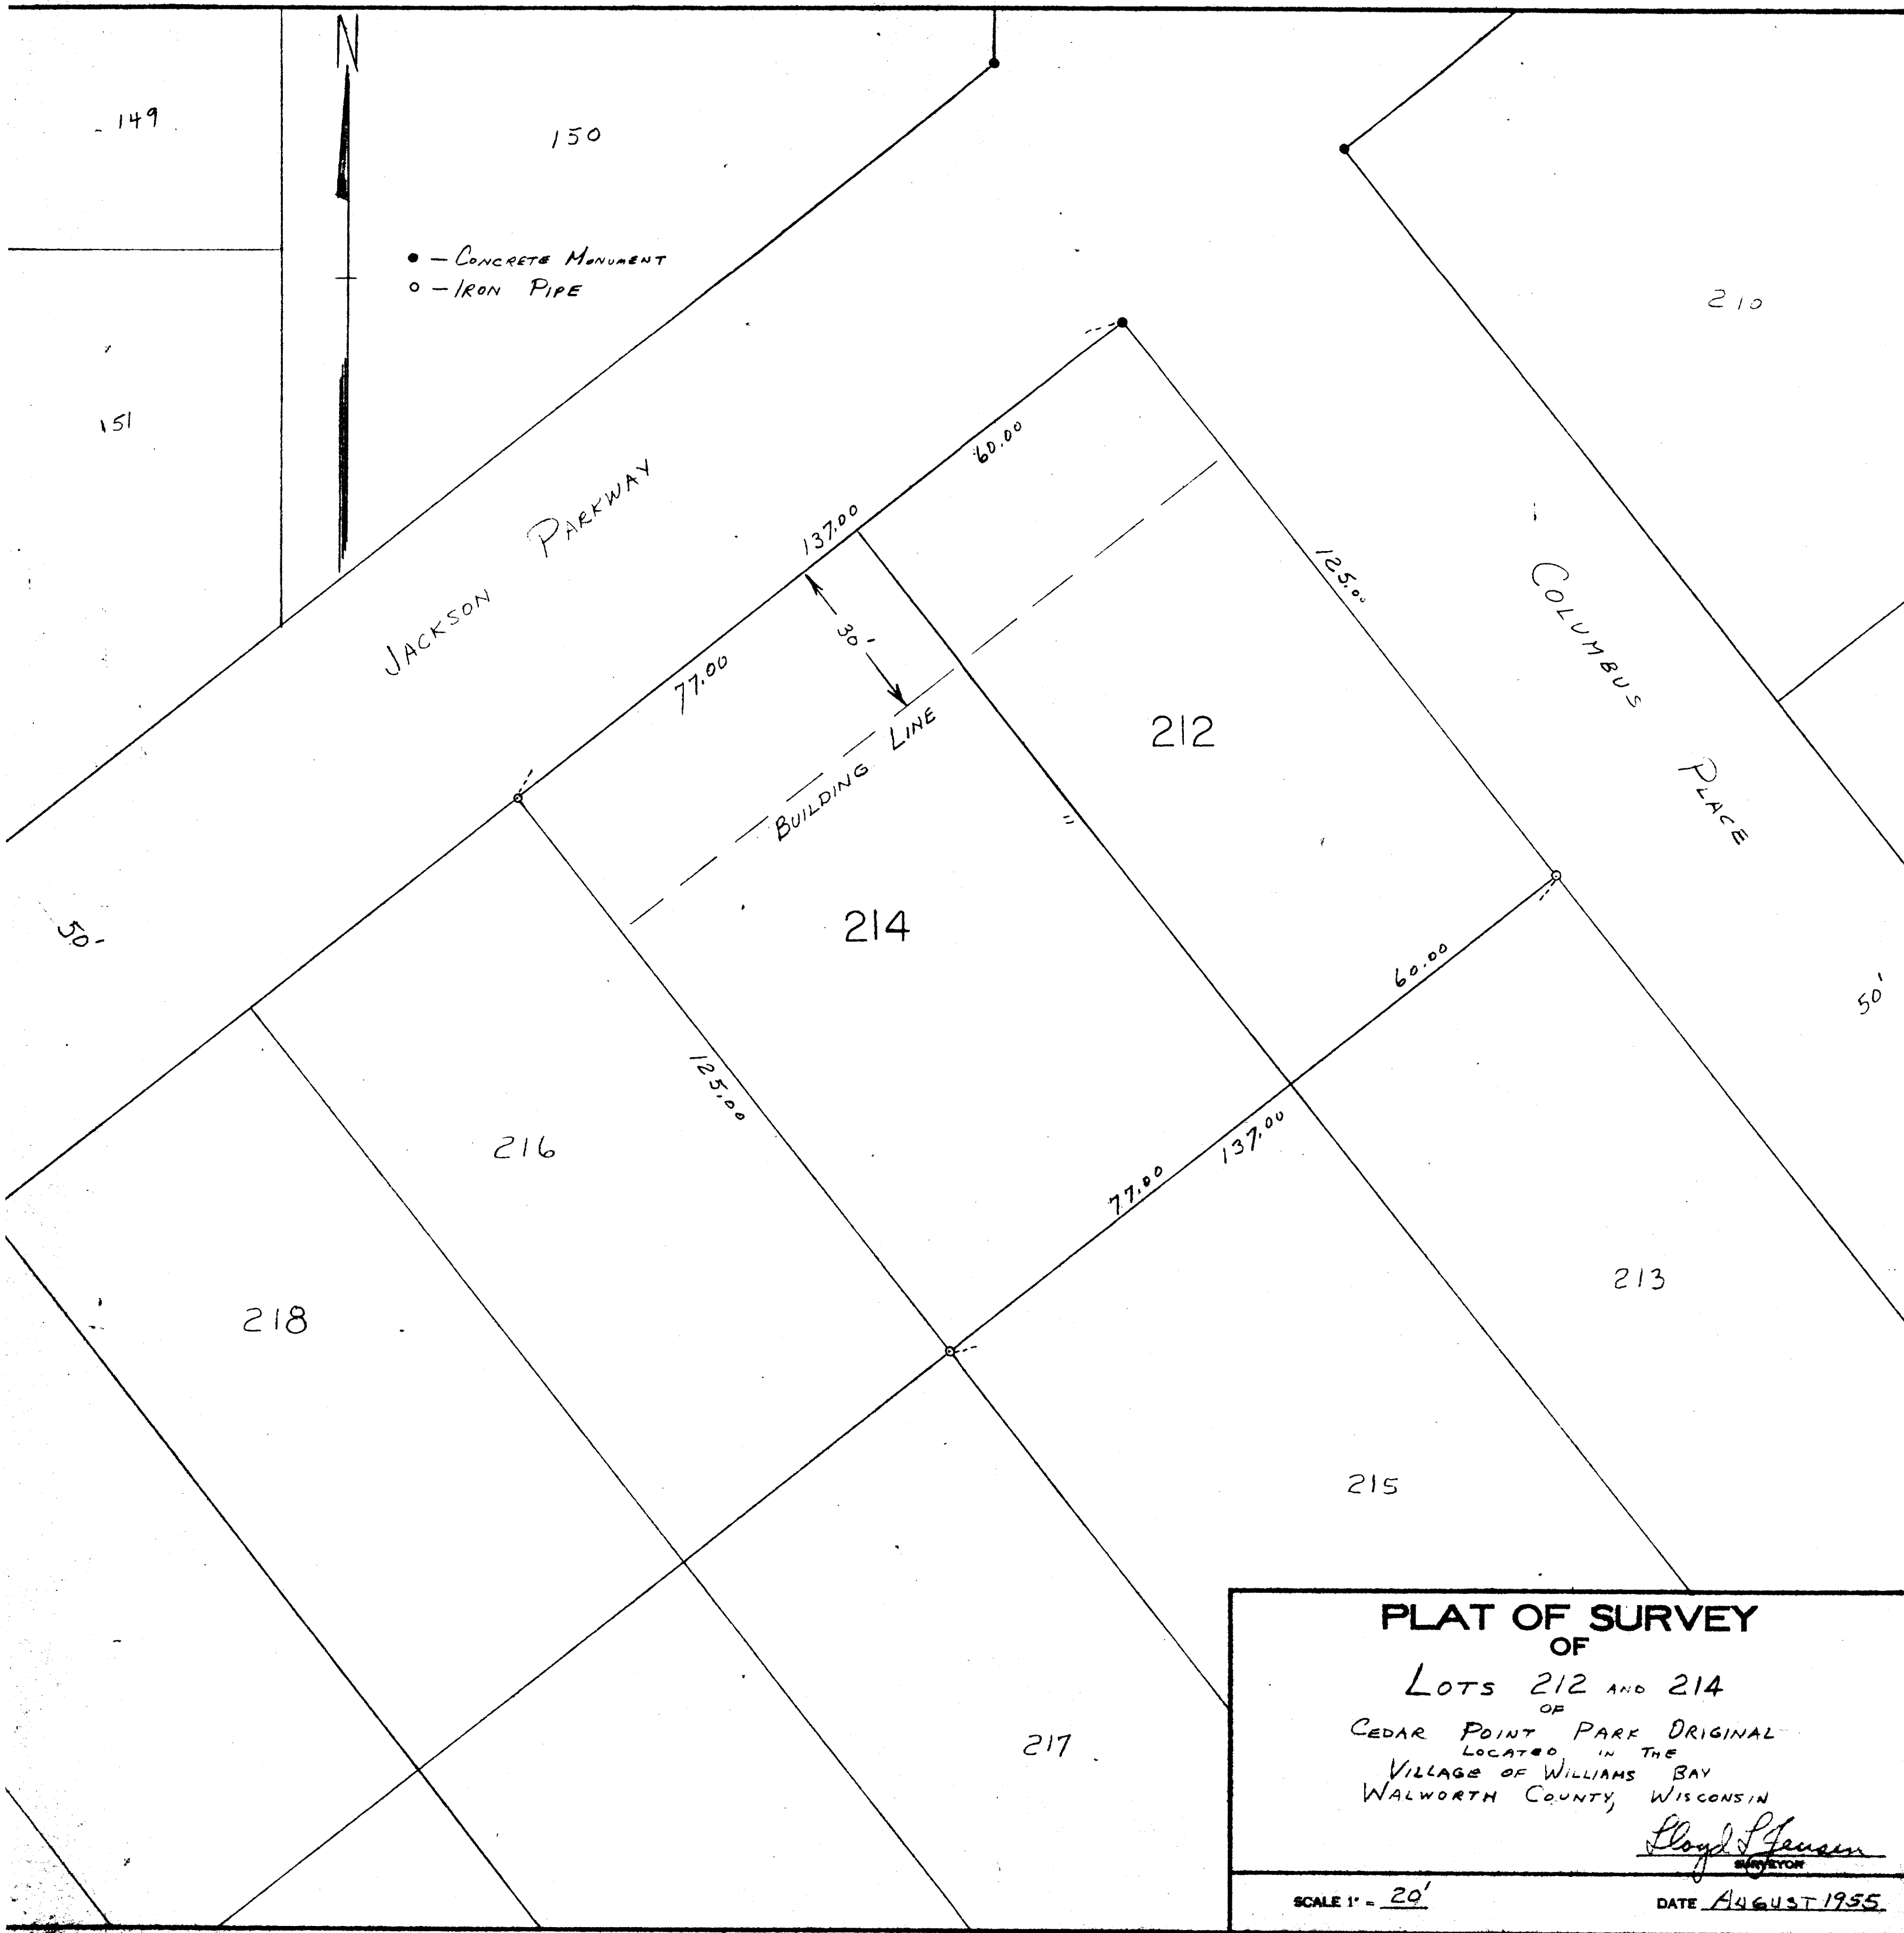

PLAT OF SURVEY
OF

LOTS 212 AND 214

OF
CEDAR POINT PARK ORIGINAL
LOCATED IN THE
VILLAGE OF WILLIAMS BAY
WALWORTH COUNTY, WISCONSIN

Lloyd Jensen
SURVEYOR

SCALE 1" = 20'

DATE AUGUST 1955

11-133 J ~