



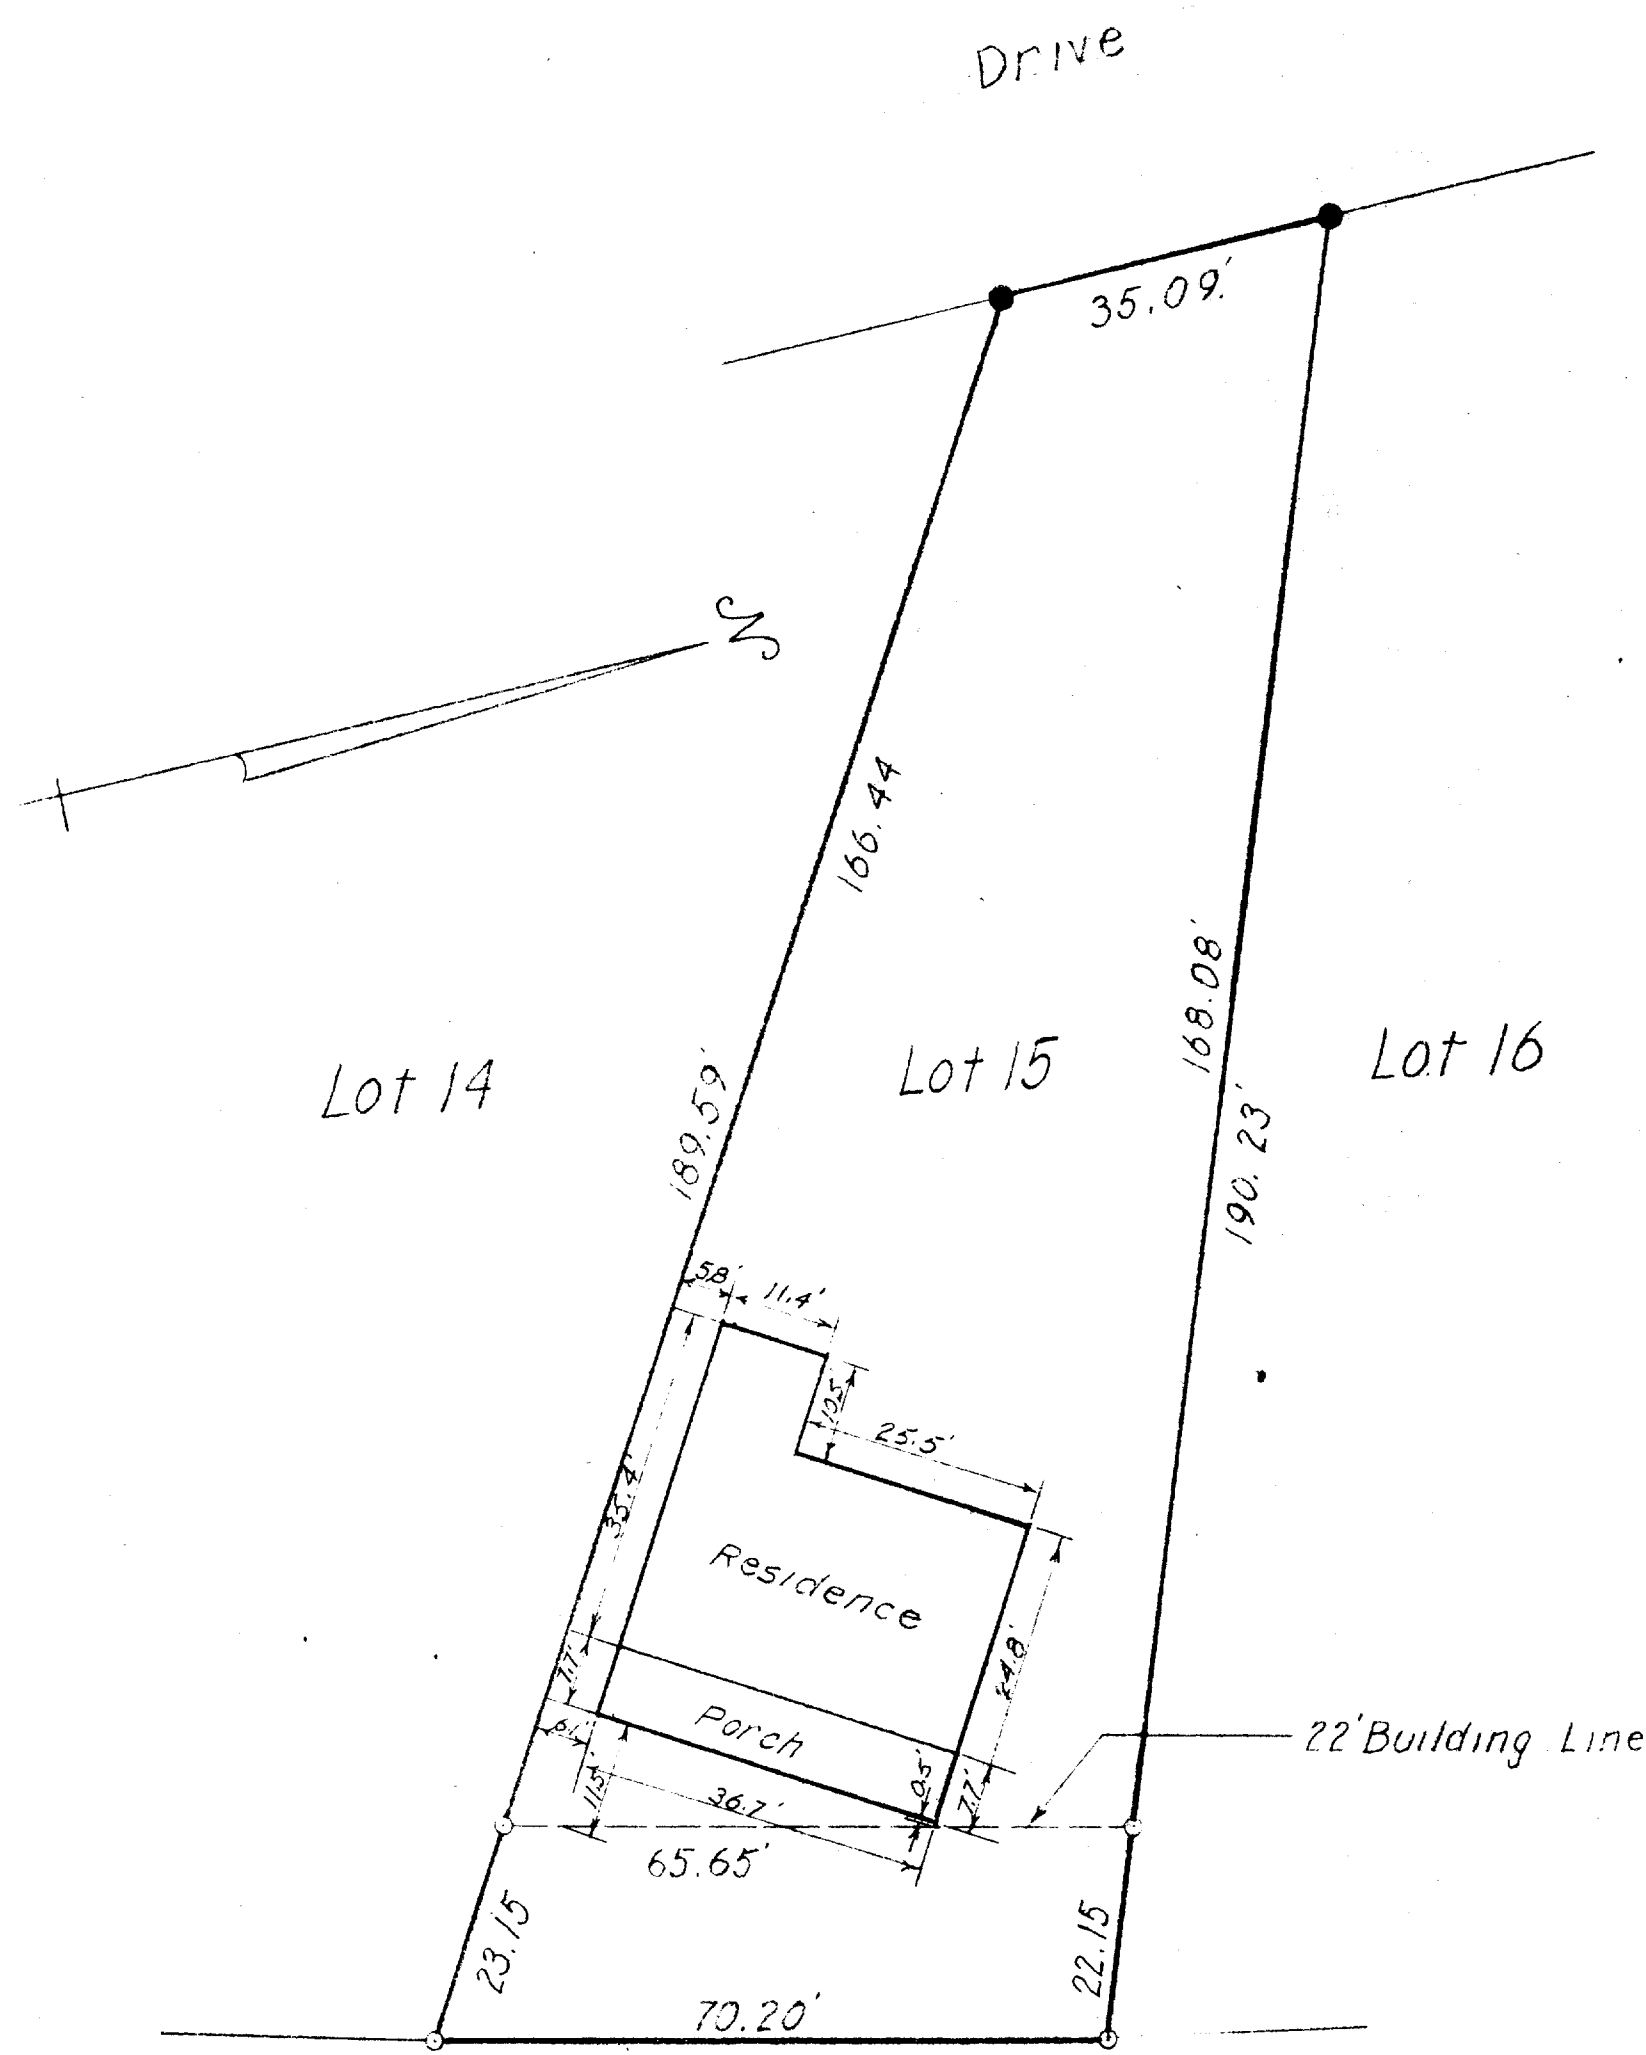

○ - Iron Pipe
 ● - Concrete Monument

Birch Grove Park

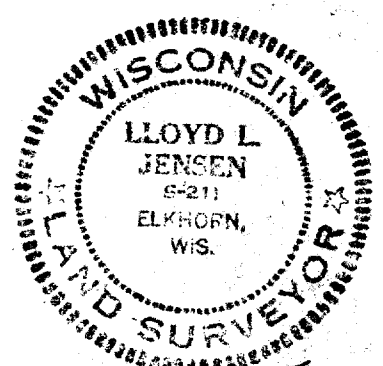

PLAT OF SURVEY OF Lot 15 of the 1st Addition to Cedar Point Park, Village of Williams Bay, Section 6, T1N, R17E, Walworth County, Wisconsin	
<i>Lloyd L. Jensen</i> SURVEYOR	DATE <u>Dec. 1956</u>
SCALE 1" = 20'	