
ABELL SURVEYING & MAPPING

1140 SEQUOIA STREET • DELAVAN, WISCONSIN 53115 262-728-6737



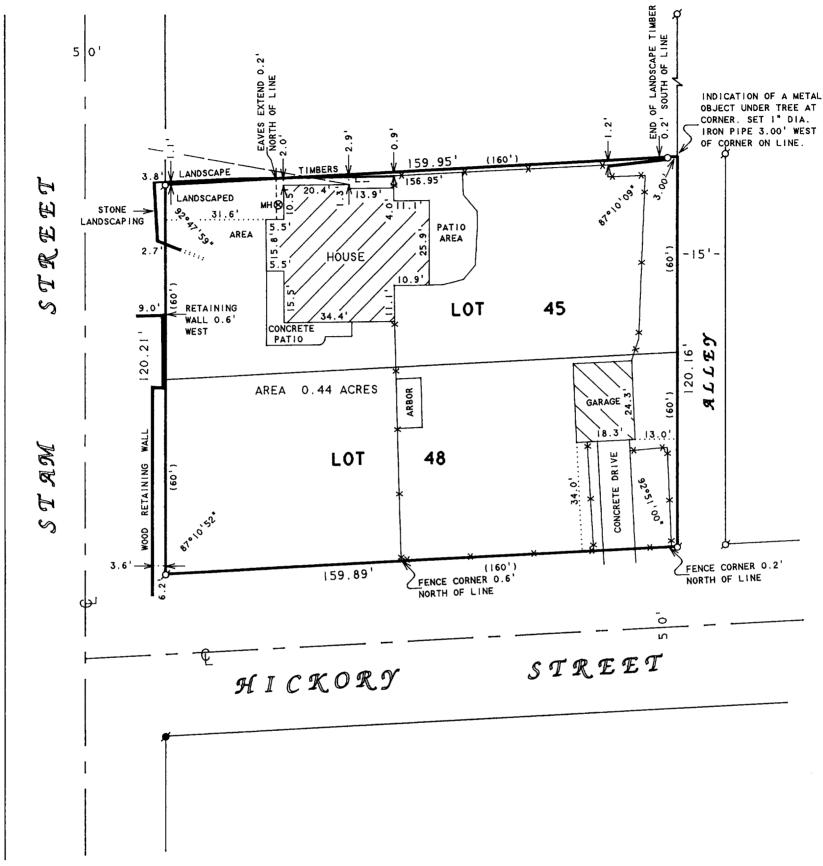

SCALE | =30

LEGEND

Ø -IRON PIPE FOUND


■ -CONCRETE MONUMENT FOUND

O -I* DIA. IRON PIPE SET

MH⊗ -MANHOLE COVER

PLAT OF SURVEY OF

LOTS 45 AND 48, BAY VIEW SUBDIVISION, LOCATED IN THE VILLAGE OF WILLIAMS BAY, WALWORTH COUNTY, WISCONSIN.

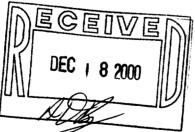

I HEREBY CERTIFY THAT I HAVE SURVEYED THE ABOVE DESCRIBED PROPERTY AND THAT THE ABOVE MAP IS A TRUE REPRESENTATION THEREOF AND SHOWS THE SIZE AND LOCATION OF THE PROPERTY, ITS EXTERIOR BOUNDARIES, THE LOCATION OF ALL VISIBLE STRUCTURES AND DIMENSIONS OF ALL PRINCIPAL BUILDINGS THEREON, BOUNDARY FENCES, APPARENT EASEMENTS, ROADWAYS AND VISIBLE ENCROACHMENTS, IF ANY, TO THE BEST OF MY KNOWLEDGE AND BELIEF.

THIS SURVEY IS MADE FOR THE USE OF THE PRESENT OWNERS OF THE PROPERTY, AND ALSO THOSE WHO PURCHASE, MORTGAGE, OR GUARANTEE THE TITLE THERETO WITHIN ONE (I) YEAR FROM DATE HEREON.

ORDERED BY: KEEFE REAL ESTATE 1155 E. GENEVA STREET DELAVAN, WI 53115

DAVID F. ABELL WISCONSIN REGISTERED LAND SURVEYOR, S-1596

October 16, 2000

DATE JOB NUMBER - 00167
NOTE: THIS IS NOT A CERTIFIED COPY UNLESS SEALED.

11-1509