


GEORGE T. DUNHAM
SURVEYING & SUBDIVIDING
DELAVAN, WISCONSIN

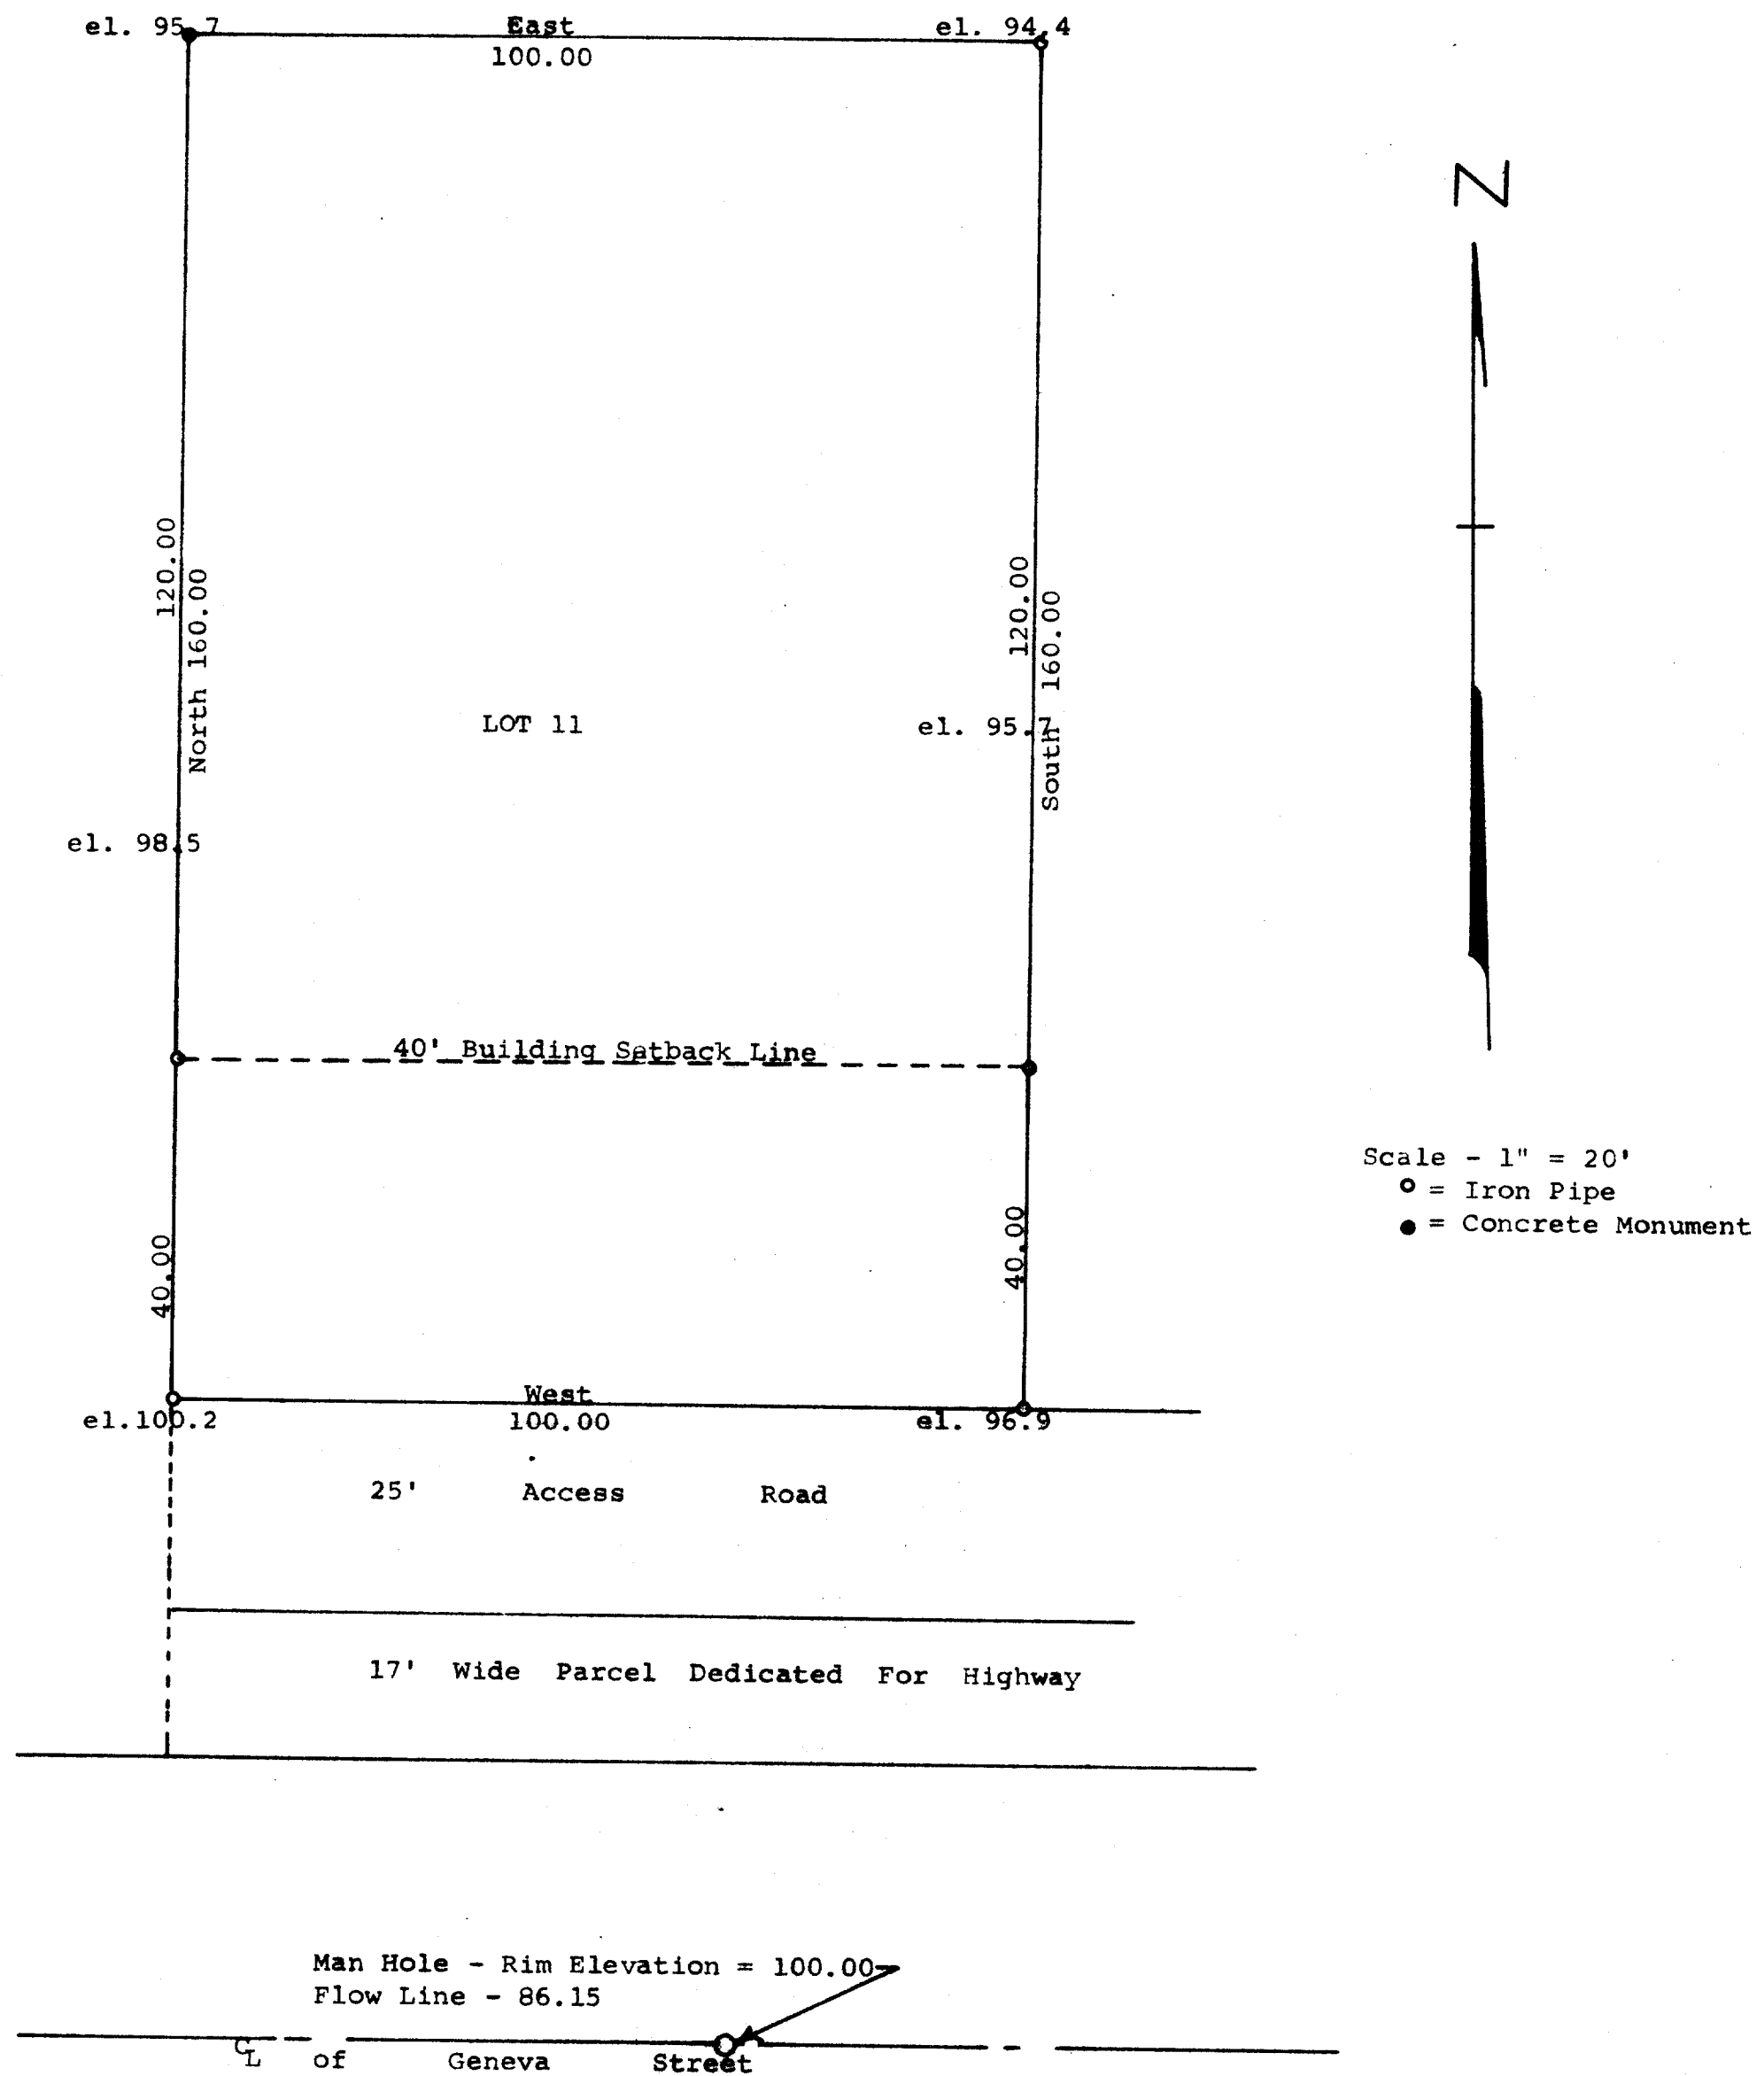

STATE OF WISCONSIN)
COUNTY OF WALWORTH) SS

I, George T. Dunham, Surveyor, certify that I have surveyed the property described as follows,
Lot 11 of Baywood Heights Subdivision located in the Village of Williams Bay, Walworth County, Wisconsin
and that the plat shown above is an accurate survey and a true representation thereof and correctly shows the exterior boundary lines and that there are no buildings on said property at this date.
August 15, 1972

George T. Dunham
George T. Dunham, Surveyor

