



PLAT OF SURVEY

WORK ORDERED BY -
GENEVA LAKEFRONT REALTY
P.O. BOX 901
WILLIAMS BAY, WI. 53191


FARRIS, HANSEN & ASSOCIATES, INC.
Engineering, Architecture, Surveying
7 Ridgeway Court P.O. Box 437
ELKHORN, WISCONSIN 53121
Office: (262) 723-2098
Fax: (262) 723-5886

REVISIONS

PROJECT NO.
4641
DATE:
01/03/2002
SHEET NO.
1 OF 1


PLAT OF SURVEY

LOT 11 OF JEWELL'S SUBDIVISION
LOCATED IN THE VILLAGE OF WILLIAMS
BAY, WALWORTH COUNTY, WISCONSIN

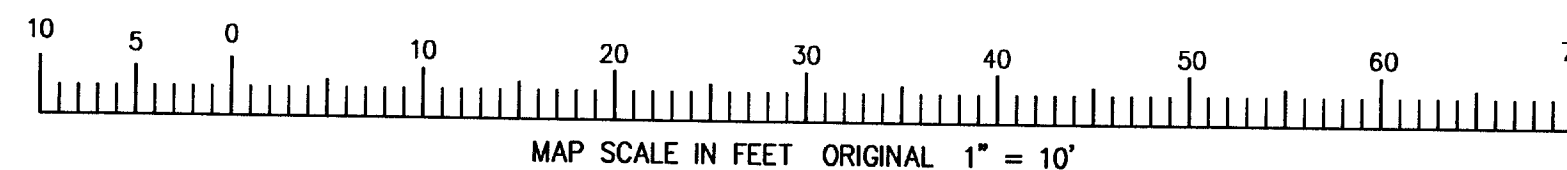

LEGEND

- = FOUND IRON PIPE STAKE 1" DIA.
- = FOUND IRON REBAR STAKE 3/4" DIA.
- ⦿ = SET IRON REBAR STAKE 3/4" DIA.
- (XXX) = RECORDED AS

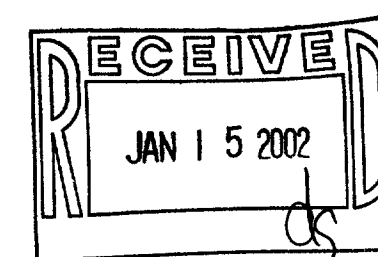


NOTE: COPIES OF THIS MAP TO WHICH THE FOLLOWING CERTIFICATE WILL APPLY SHOW THE SURVEYOR'S ORIGINAL SEAL AND SIGNATURE IN RED INK. COPIES BY ANY OTHER MEANS MAY HAVE ALTERATIONS WHICH DO NOT REPRESENT THE SURVEYOR'S WORK PRODUCT.

I HEREBY CERTIFY THAT THE ABOVE DESCRIBED PROPERTY HAS BEEN SURVEYED UNDER MY DIRECTION AND THAT THE ABOVE MAP IS A TRUE REPRESENTATION THEREOF AND SHOWS THE SIZE AND LOCATION OF THE PROPERTY AND ITS EXTERIOR BOUNDARIES. THIS SURVEY IS MADE FOR THE USE OF THE PRESENT OWNERS OF THE PROPERTY, AND ALSO THOSE WHO PURCHASE, MORTGAGE, OR GUARANTEE THE TITLE THERETO WITHIN ONE YEAR FROM THE DATE HEREOF.

DATED: JAN. 4, 2002

PETER S. GORDON R.L.S. 2101

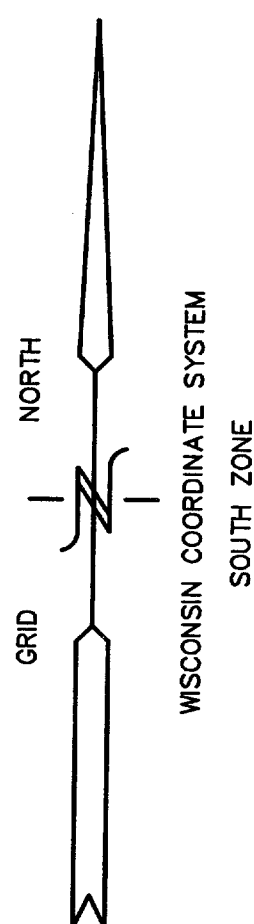

LOT 10

LOT 12

LOT 11

RESIDENCE

JACUZZI

DECK

DECK

JEWELL DRIVE

EDGE OF PAVEMENT

FENCE LINE (TYPICAL)

CORNER OF GARAGE 1.8' EAST OF PROPERTY LINE.

OVERHEAD WIRES RUN ALONG NORTH LINE OF PROPERTY.

N 89-53-31 E 60.14' (60')

(120°)
120.29'

N 01-20-11 E 149.05' (150')

S 01-26-07 W 149.17' (150')

S 90-00-00 W 59.88' (60')

56'

19.7

10.0

8.3

2.3

7.00

2.3

2.0

24.1

10'

13.8

8.2

24.2

2.3

21.6

20.7

10'