

LOT 6 GRAND TERRACE
SUBDIVISION

LOT 8 GRAND TERRACE
SUBDIVISION

6' WALKWAY EASEMENT

0.3' ENCROACHMENT
5.7'
5.5'
0.5' ENCROACHMENT

RESIDENCE

GENEVA LAKE

O - IRON PIPE
X - CROSS IN CONCRETE WALL


PLAT OF SURVEY OF

LOTS 3, 7, 8 AND 9 IN WILLIAM G. WILLIAM-
SON'S SUBDIVISION OF LOT 7 GRAND TERRACE
SUBDIVISION, VILLAGE OF WILLIAMS BAY,
WALWORTH COUNTY, WISCONSIN.

Lloyd L. Jensen
SURVEYOR

SCALE 1" = 30'

DATE APRIL, 1957

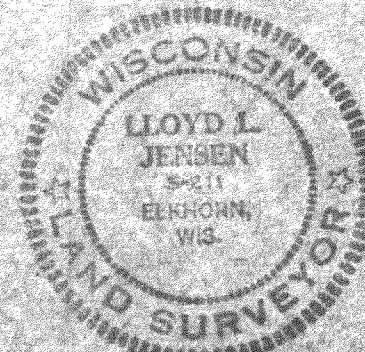

WW-3,5

11-163