

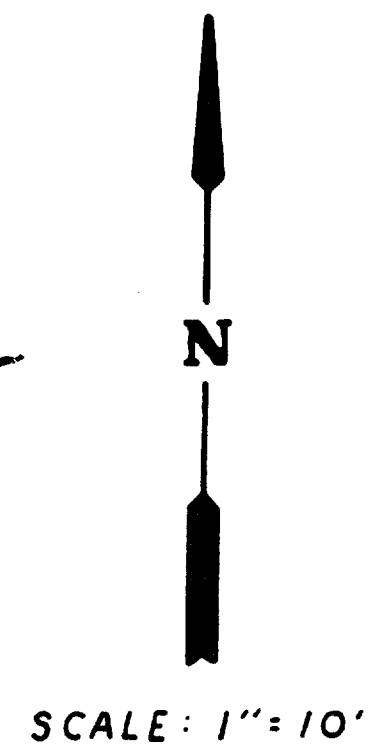


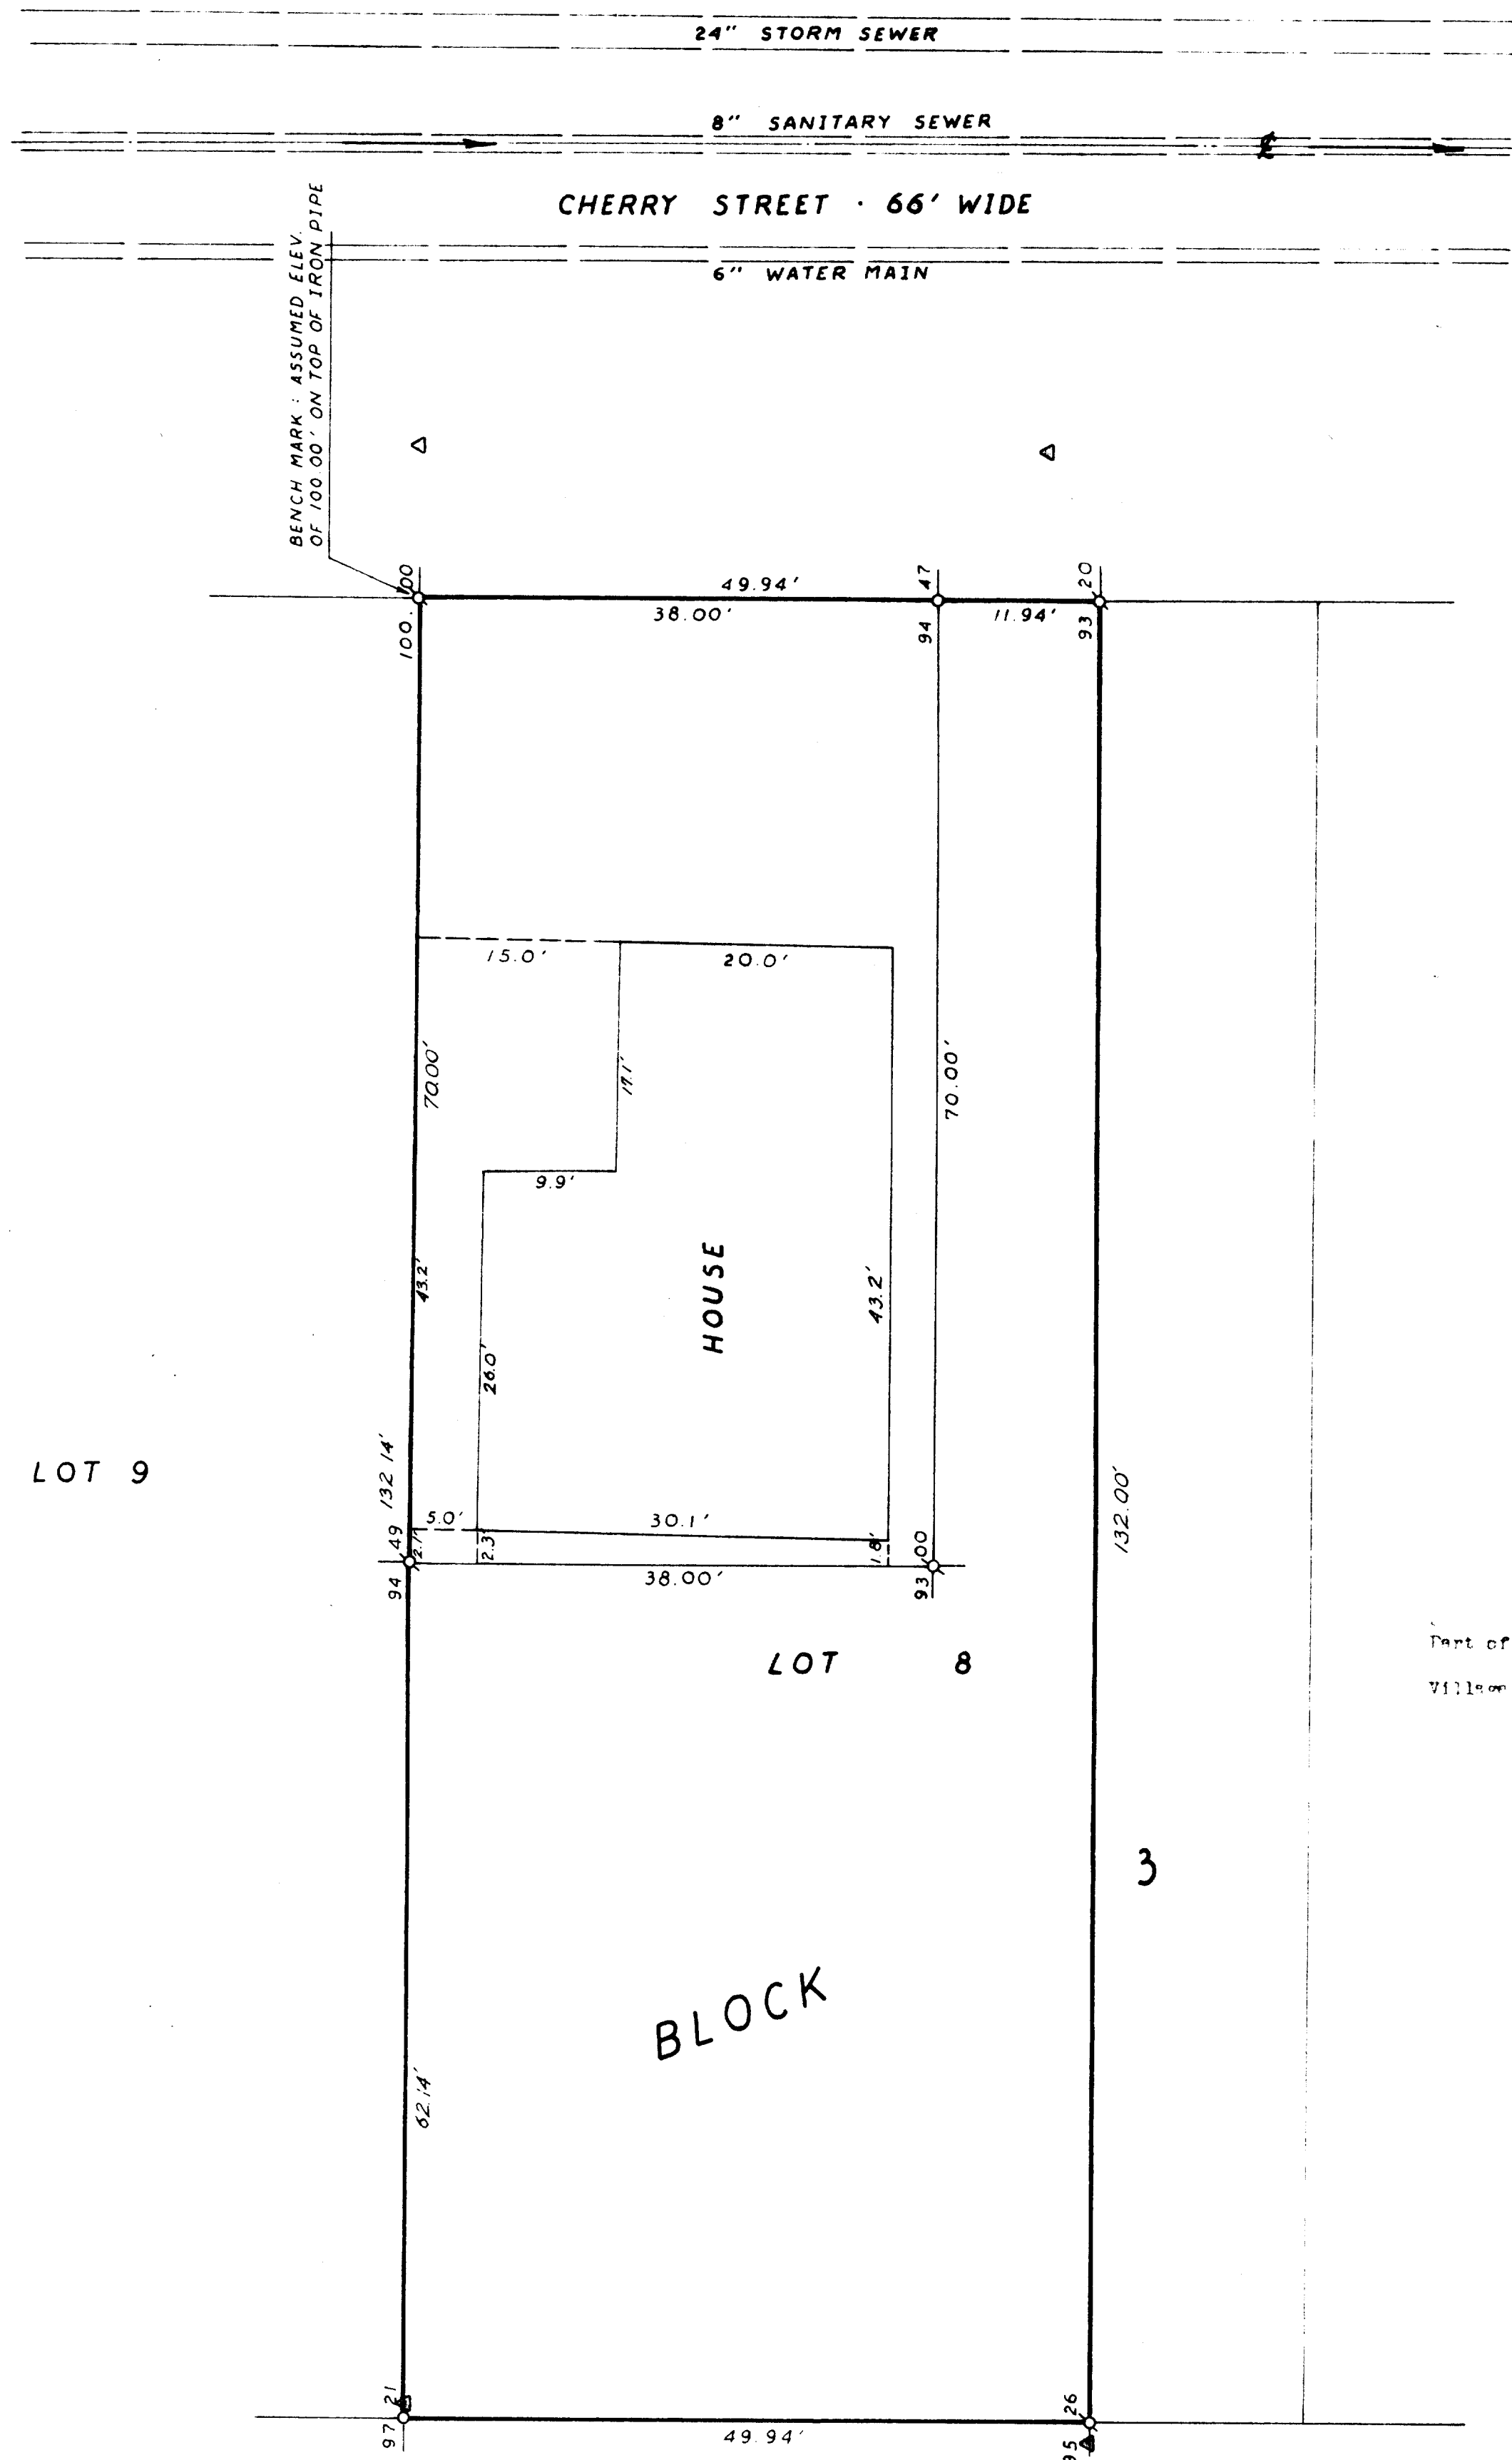

LOT 7
Part of Lot 8, Block 3, Original Plat of the
Village of Williams Bay, Walworth County, Wisconsin.

- LEGEND
- -- Iron Pin Found
 - -- Iron Pin Placed
 - △ -- Telephone Pole

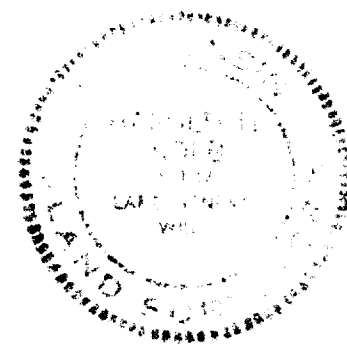

Harold H. Kolb
Surveyor
July 13, 1972