PREPARED FOR: JERRY AND DAVE BURROUGH PO. BOX 1026 WILLIAMS BAY WI.

53191

## PLAT OF SURVEY


- OF -

J.K. SURVEYING INC. N3705 WILLOWBEND LANE LAKE GENEVA, WI, 53147 262-248-3697

LOTS 2 AND 3 OF BLOCK 9 OF WILLIAMS SECOND ADDITION, TO THE VILLAGE OF WILLIAMS BAY, LOCATED IN THE NORTHEAST 1/4 OF SECTION 1, TOWN 1 NORTH, RANGE 16 EAST, VILLAGE OF WILLIAMS BAY WALWORTH COUNTY, WISCONSIN.

C.L. CHERRY STREET

(66' WIDE ROAD)

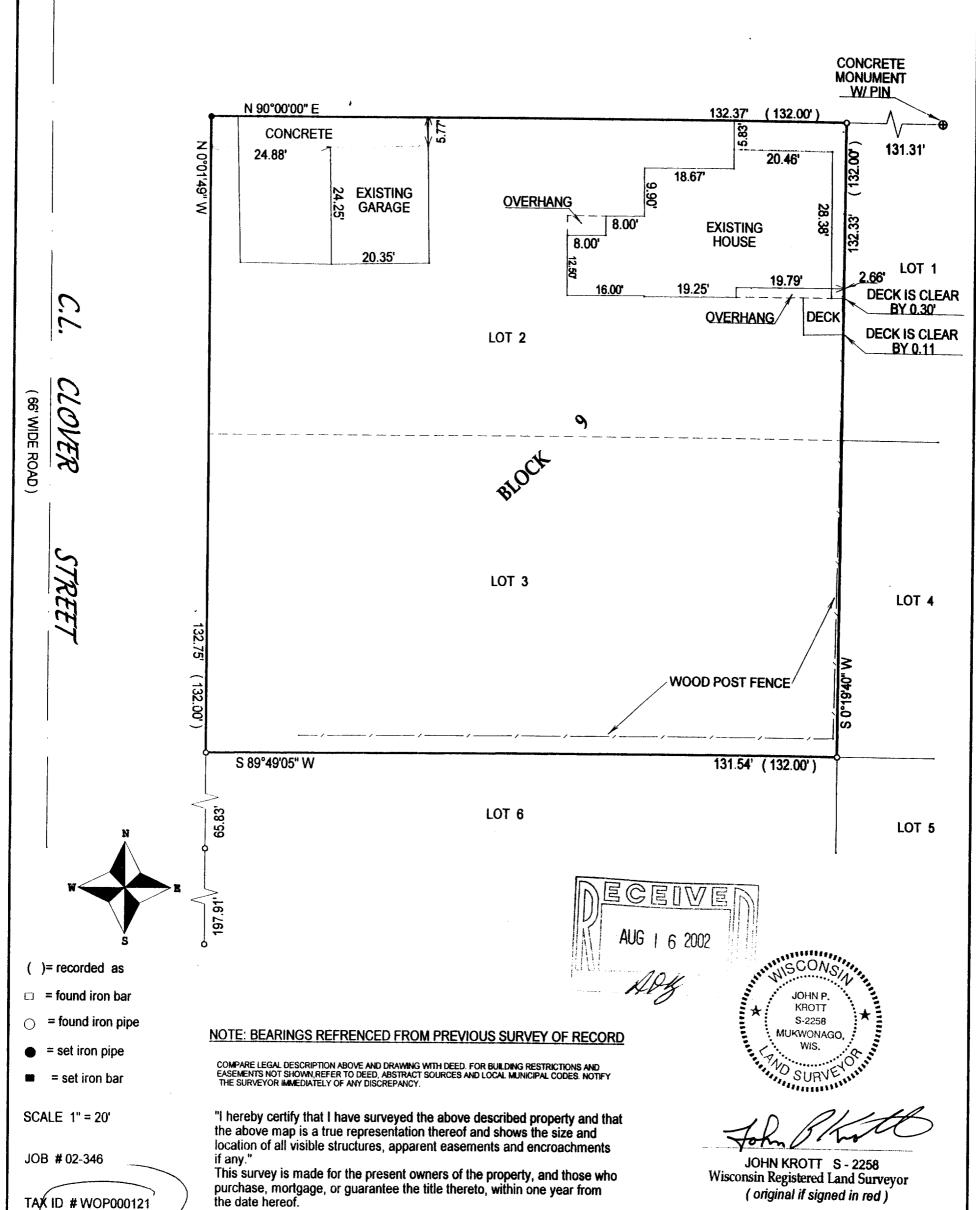

DATED THIS THE 18th DAY OF JULY 2002.