
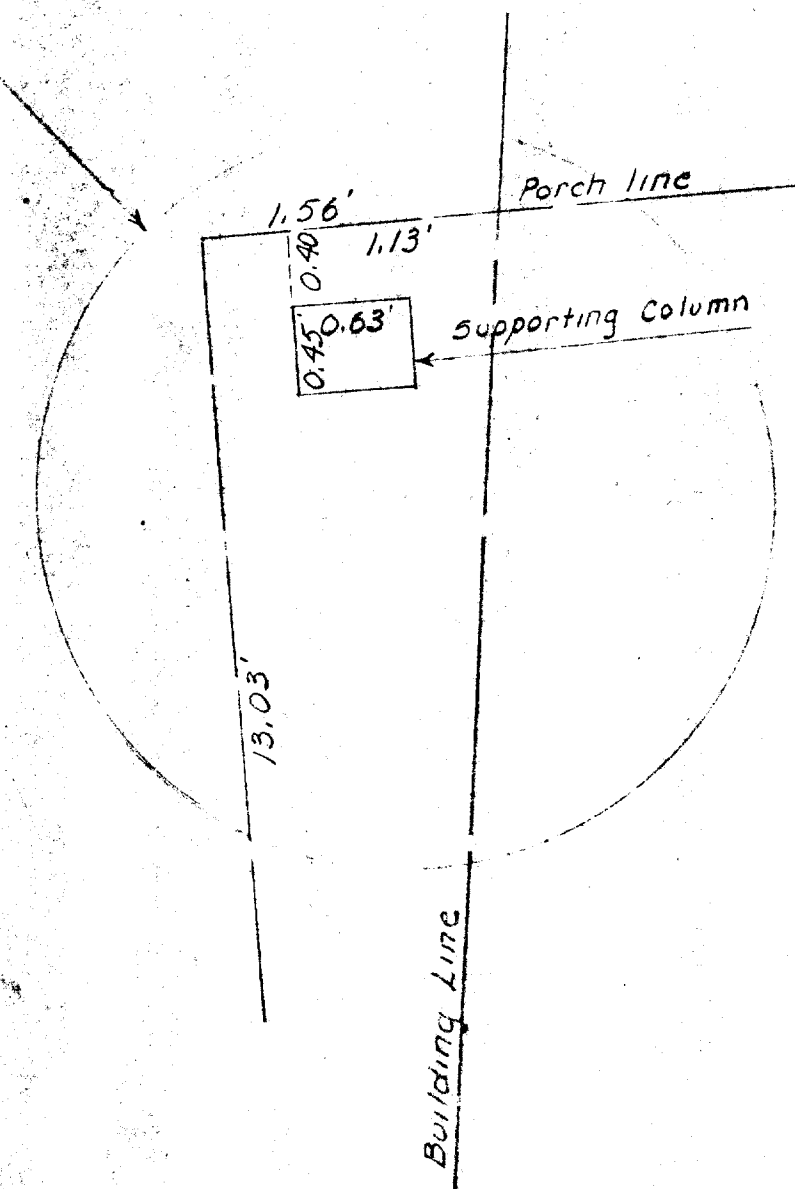


Geneva Lake

Lot 209


Lot 210

Lot 211

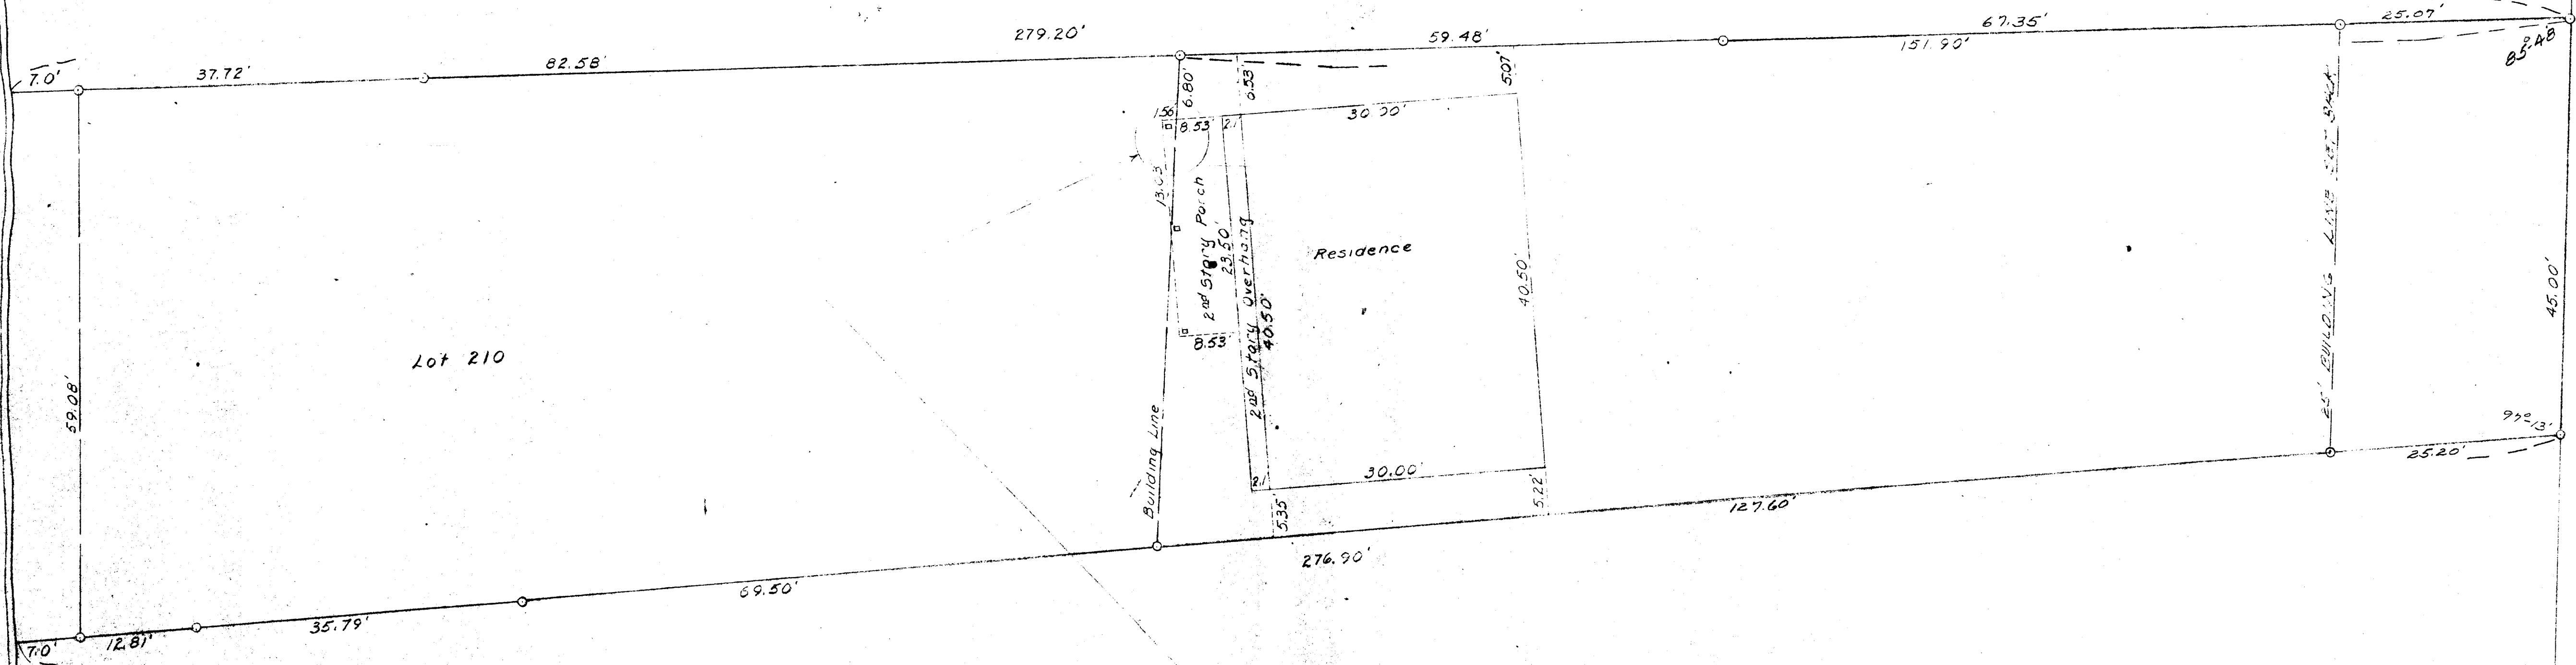

Detail
Scale 1" = 1'

○ - Iron Pipe

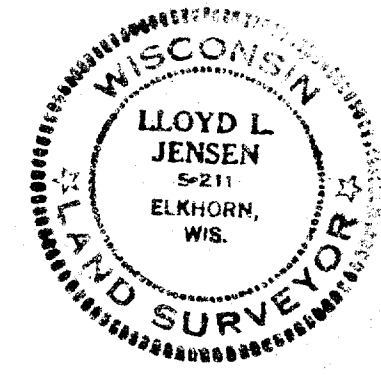

Plot of Survey of Lot 210, Third
Addition to Cedar Point Park, Village
of Williams Bay, Walworth County, Wis.

DRAWN BY H. Kolb	JENSEN & JOHNSON CIVIL ENGINEERS ELKHORN, WIS. RECEIVED AUG. 1963 DATE AUGUST, 1961
CHECKED BY <i>[Signature]</i>	
APPROVED BY	