

PREPARED FOR:  
LINDA TONGE  
KEEFE REALTY  
751 GENEVA PARKWAY  
LAKE GENEVA WI 53147

# PLAT OF SURVEY



- OF -

J.K. SURVEYING INC.  
N3705 WILLOWBEND LANE  
LAKE GENEVA, WI, 53147  
262-248-3697

THE NORTH 1/2 OF LOT 234 AND ALL OF LOT 235 EXCEPT THE NORTH 2.50 FEET THEREOF  
ALL IN THIRD ADDITION TO CEDAR POINT PARK, IN THE VILLAGE OF WILLIAMS BAY,  
WALWORTH COUNTY, WISCONSIN.

C.L. CIRCLE PARKWAY

(40' WIDE ROAD)

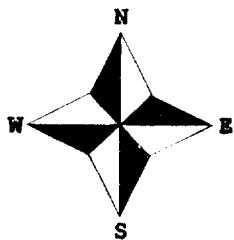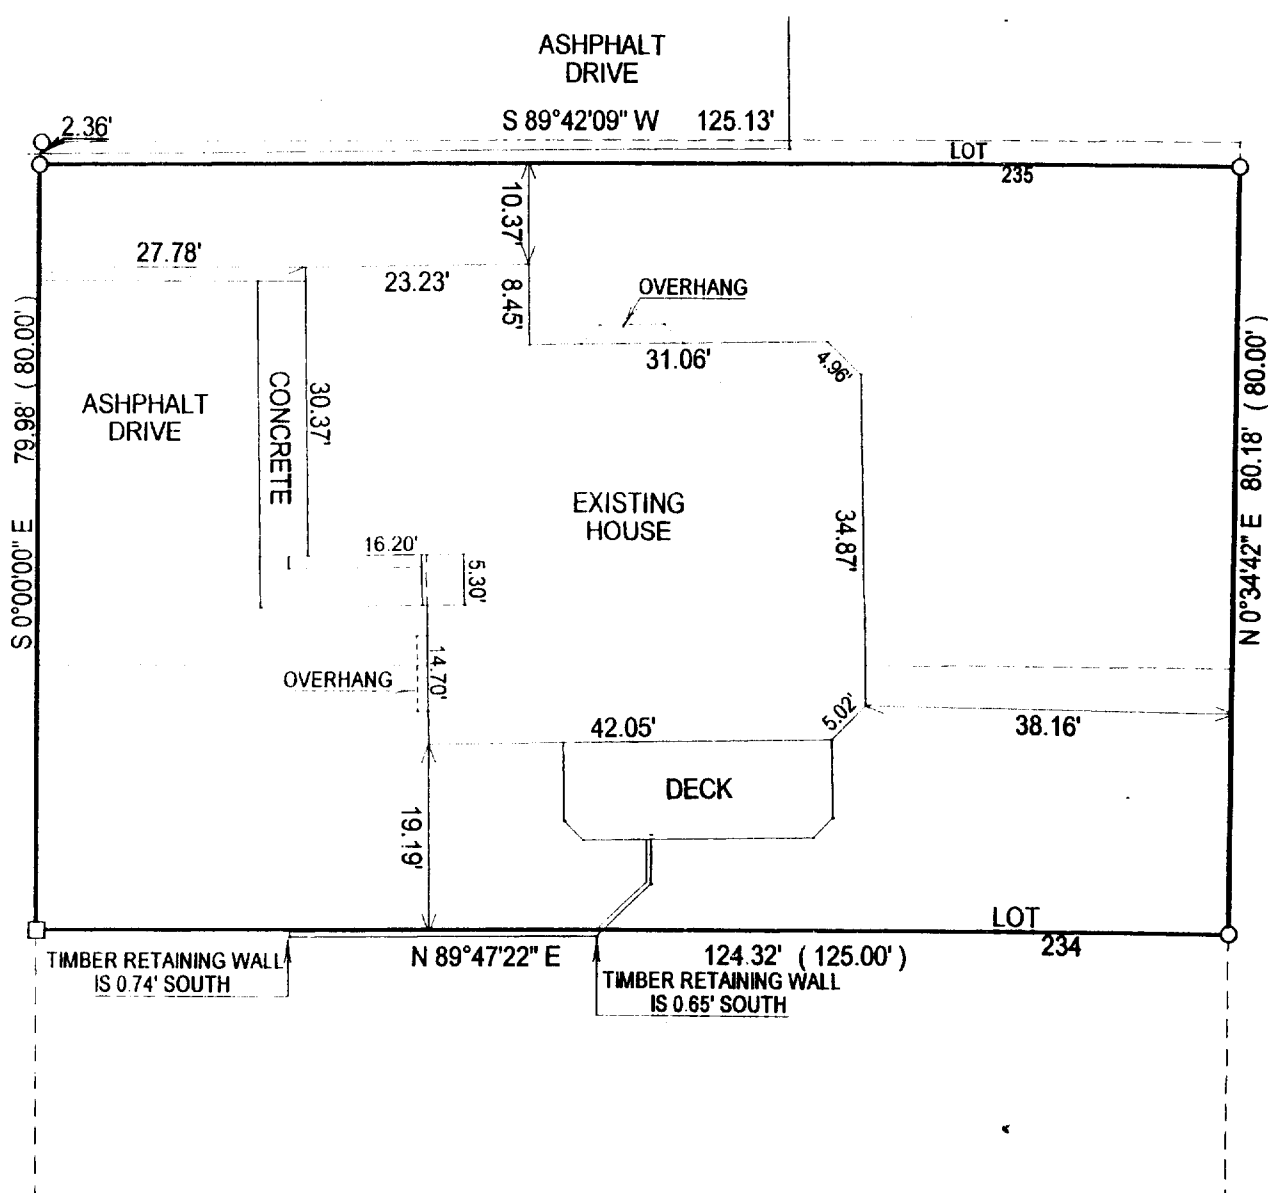

- ( ) = recorded as  
□ = found iron bar  
○ = found iron pipe  
● = set iron pipe  
■ = set iron bar

SCALE 1" = 20'

JOB # 03-183

TAX ID # WCP300030

OCT - 3 2003


322

NOTE: BASIS OF BEARING WAS ASSUMED THAT CIRCLE PARKWAY BEARS S 0°00'00" E.

COMPARE LEGAL DESCRIPTION ABOVE AND DRAWING WITH DEED. FOR BUILDING RESTRICTIONS AND EASEMENTS NOT SHOWN, REFER TO DEED, ABSTRACT SOURCES AND LOCAL MUNICIPAL CODES. NOTIFY THE SURVEYOR IMMEDIATELY OF ANY DISCREPANCY.

"I hereby certify that I have surveyed the above described property and that the above map is a true representation thereof and shows the size and location of all visible structures, apparent easements and encroachments if any."

This survey is made for the present owners of the property, and those who purchase, mortgage, or guarantee the title thereto, within one year from the date hereof.

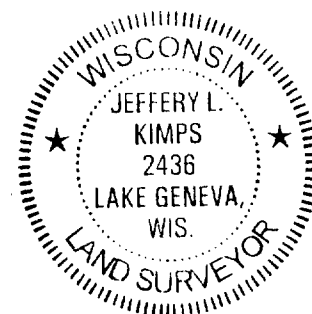

JEFFREY L. KIMPS S-2436  
Wisconsin Registered Land Surveyor  
(original if signed in red)

DATED THIS THE 24th DAY OF APRIL 2003.

011-1785