
PREPARED FOR: ROBERT HOPKINS 427 SUNSET LaGRANGE, IL 60525

PLAT OF SURVEY

J.K. SURVEYING INC. N3705 WILLOWBEND LANE LAKE GENEVA, WI 53147 (262) 248-3697

- OF -

LOT 154 ORIGINAL CEDAR POINT PARK SUBDIVISION, BEING A SUBDIVISION IN THE VILLAGE OF WILLIAMS BAY, WALWORTH COUNTY, WISCONSIN.

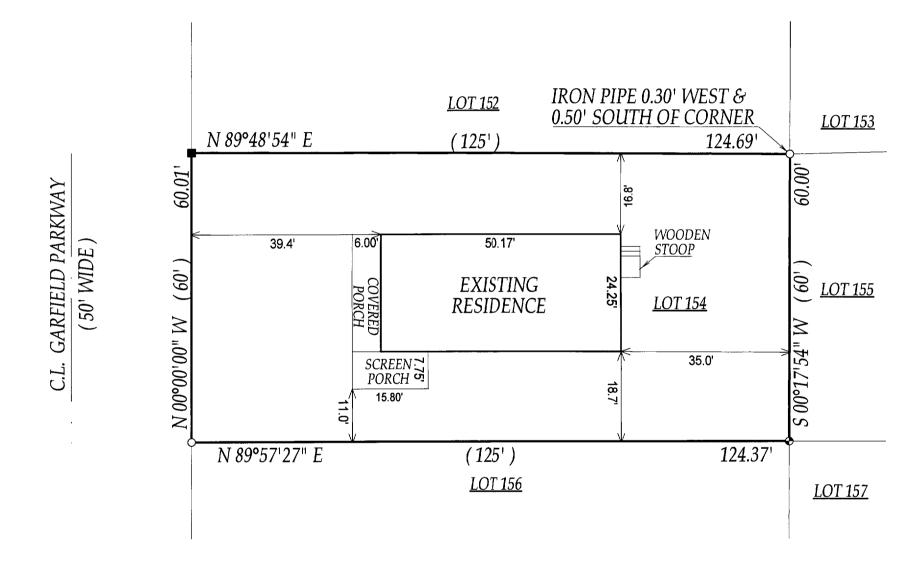

JOHN P. TO SURVEY OF THE

COMPARE LEGAL DESCRIPTION ABOVE AND DRAWING WITH DEED. FOR BUILDING RESTRICTIONS AND EASEMENTS NOT SHOWN, REFER TO DEED, ABSTRACT SOURCES AND LOCAL MUNICIPAL CODES. NOTIFY THE SURVEYOR IMMEDIATELY OF ANY DISCREPANCY.

"I hereby certify that I have surveyed the above described property and that the above map, to the best of my knowledge and belief, is a true representation thereof and shows the size and location of all visible structures, apparent easements and encroachments if any."

This survey is made for the present owners of the property, and those who purchase, mortgage, or guarantee the title thereto, within one year from the date hereof.

VW

JOHN KROTT S - 2258 Wisconsin Registered Land Surveyor (original if signed in red)

DATED THIS 20TH, DAY OF FEBRUARY 2004.

() = RECORDED AS

□ = FOUND IRON BAR

○ = FOUND IRON PIPE

■ = SET IRON BAR

■ = SET IRON PIPE

SCALE: 1" = 20'

JOB #: 03-067

TAX ID #: WCP 127