


PLAT OF SURVEY

OF

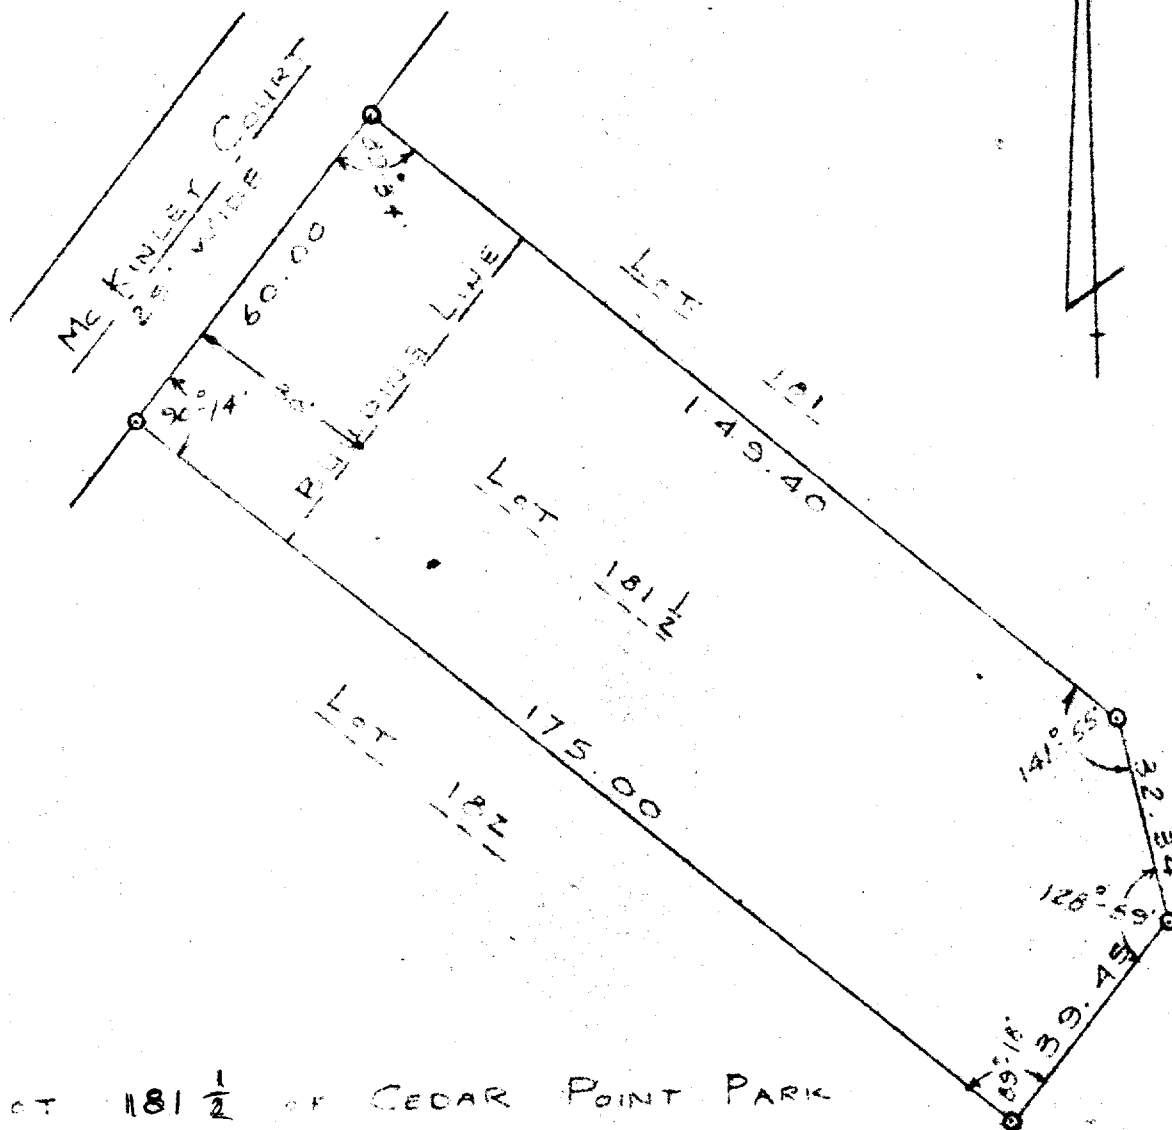

LOT 181 $\frac{1}{2}$ OF CEDAR POINT PARK
 LOCATED IN THE SE $\frac{1}{4}$ OF SECTION 6
 T1N, R1E, VILLAGE OF WILLIAMS BAY
 WALWORTH COUNTY, WISCONSIN.

SURVEY AND PLAT BY
JENSEN & JOHNSON
 CIVIL ENGINEERS AND SURVEYORS

Elkhorn, Wisconsin

LEGEND

- — Iron Pipe
 - — Concrete Monument
- Scale 1" = 30'

WE CERTIFY: That we have surveyed the above described property and that the plat shown hereon is an accurate survey and a true representation thereof and correctly shows the exterior boundary lines and all divisions of said property.

Date JUNE 24, 1963

Lloyd S. Jensen
 LLOYD S. JENSEN, Partner

Wisconsin Registered Land Surveyor, No. S-211

CP-155

11-181 J

11-181