PREPARED FOR:


PLAT OF SURVEY

DONNA ZABOROWSKI

-OF-

J.K. SURVEYING INC. N3705 WILLOWBEND LANE LAKE GENEVA, WI, 53147 262-248-3697

LOT 45 IN LACKEY BROTHERS SUBDIVISION OF WILLIAMS BAY, WISCONSIN, BEING A SUBDIVISION OF PART OF THE SOUTHEAST 1/4 OF SECTION 1, IN TOWNSHIP 1 NORTH, RANGE 16 EAST, AND THE SOUTHWEST 1/4 OF THE SECTION 6, IN TOWN SHIP 1 NORTH, RANGE 17 EAST, IN THE VILLAGE OF WILLIAMS BAY.

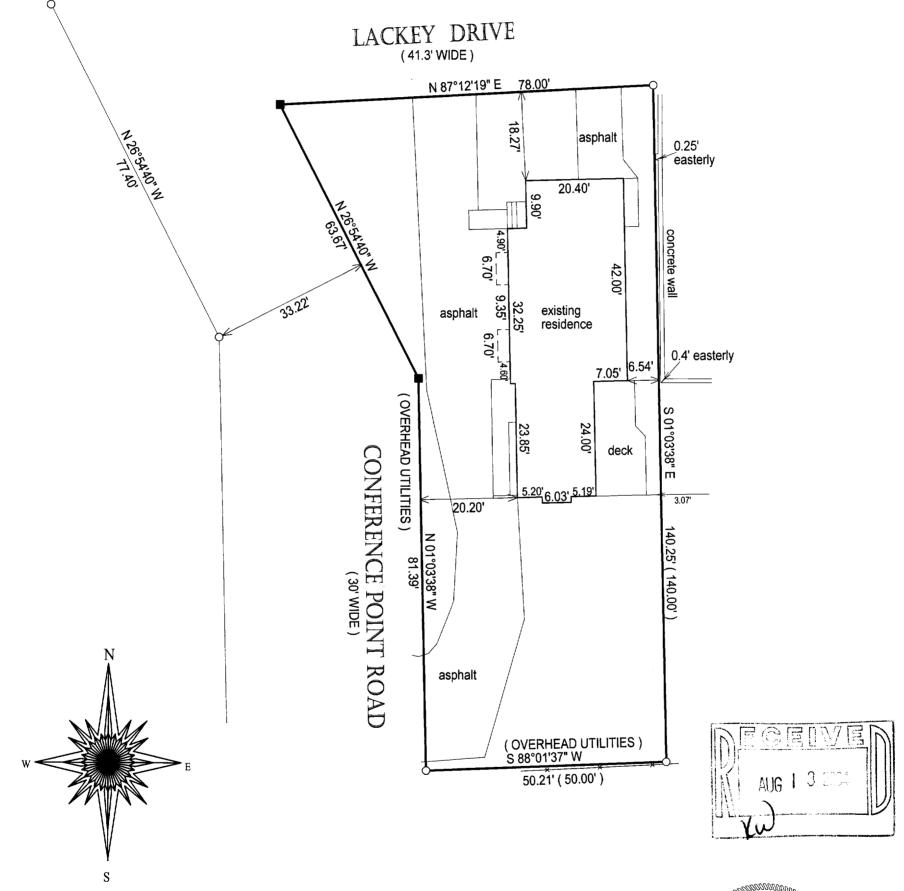

() = RECORDED AS

 \Box = FOUND IRON BAR

○ = FOUND IRON PIPE

● = SET IRON PIPE

= SET IRON BAR

SCALE: 1" = 20'

JOB #: 04-324

TAX ID #:wlb 00044

COMPARE LEGAL DESCRIPTION ABOVE AND DRAWING WITH DEED. FOR BUILDING RESTRICTIONS AND EASEMENTS NOT SHOWN, REFER TO DEED, ABSTRACT SOURCES AND LOCAL MUNICIPAL CODES. NOTIFY THE SURVEYOR IMMEDIATELY OF ANY DISCREPANCY.

"I hereby certify that the above described property was surveyed under my supervision and that the above map, to the best of my knowledge and belief, is a true representation thereof and shows the size and location of all visible structures, apparent easements and encroachments if any." This survey is made for the present owners of the property, and those who purchase, mortgage, or guarentee the title thereto, within one year from the date hereof.



JETALY L MMPS S - 2436 Wisconsin Registered Land Surveyor (oxiginal if signed in red)

DATED THE 14 TH, DAY OF ____JUNE

2004.