SSIGNED NORTH LINE OF ROGERS PARKWAY S 88 34'15" W


FARRIS, HANSEN & ASSOCIATES, INC.

ENGINEERING — ARCHITECTURE — SURVEYING
7 RIDGWAY COURT — P.O. BOX 437 — ELKHORN, WISCONSIN 53121
PHONE: (262) 723—2098 FAX: (262) 723—5886


PLAT OF SURVEY

LOTS 164 AND 166 OF CEDAR POINT PARK SUBDIVISION
LOCATED IN PART OF SECTION 6, TOWN 1 NORTH,
RANGE 17 EAST, VILLAGE OF WILLIAMS BAY,
WALWORTH COUNTY, WISCONSIN

WORK ORDERED BY –
 DON FREDRICKSON – FREDRICKSON CONST.
 842 STONEBRIDGE LANE
 BUFFALO GROVE, IL 60089

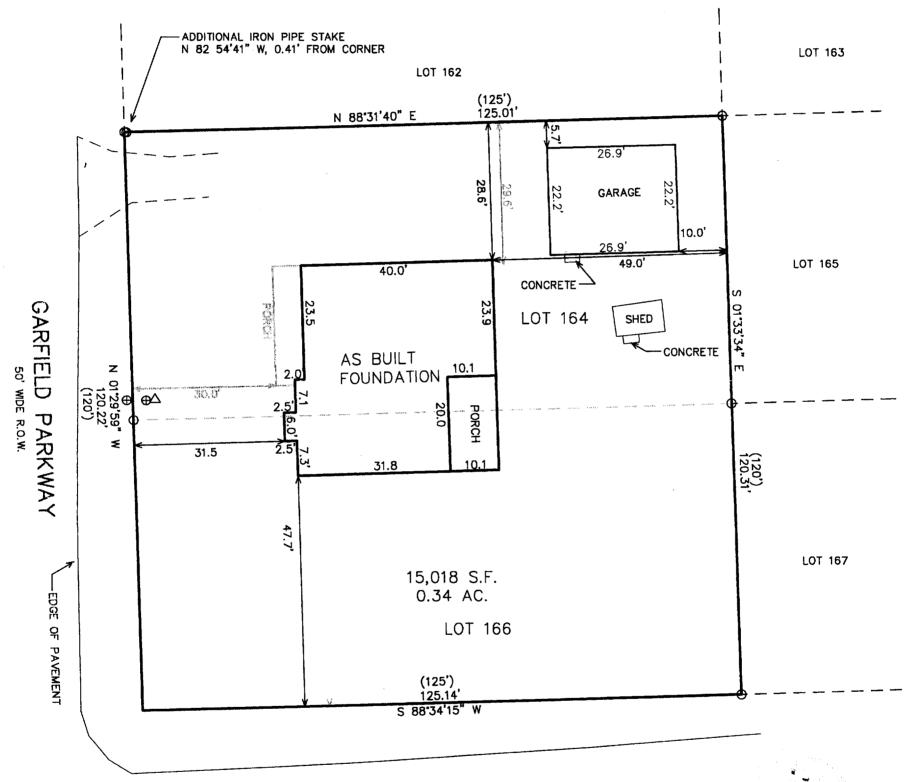

ROGERS PARKWAY

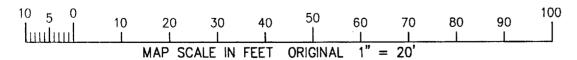

NOTE: COPIES OF THIS MAP TO WHICH THE FOLLOWING CERTIFICATE WILL APPLY SHOW THE SURVEYOR'S ORIGINAL SEAL AND SIGNATURE IN RED INK. COPIES BY ANY OTHER MEANS MAY HAVE ALTERATIONS WHICH DO NOT REPRESENT THE SURVEYOR'S WORK PRODUCT.

I HEREBY CERTIFY THAT THE ABOVE DESCRIBED PROPERTY HAS BEEN SURVEYED UNDER MY DIRECTION AND THAT THE ABOVE MAP IS A TRUE REPRESENTATION THEREOF AND SHOWS THE SIZE AND LOCATION OF THE PROPERTY AND ITS EXTERIOR BOUNDARIES. THIS SURVEY IS MADE FOR THE USE OF THE PRESENT OWNERS OF THE PROPERTY, AND ALSO THOSE WHO PURCHASE, MORTGAGE, OR GUARANTEE THE TITLE THERETO WITHIN ONE YEAR FROM THE DATE HEREOF.

REVISED 03-15-2005

DATED: JULY 27, 2004

REVISED 06-11-2005 TO SHOW SIZE & LOCATION OF AS BUILT FOUNDATION

PETER S. GORDON R.L.S. 2101

PROJECT: 6610 DATE: 07/27/2004

LEGEND

O = FOUND IRON PIPE STAKE

(XXX) = RECORDED AS

SHEET 1 OF 1

WCP SIET - WCP DODIS9

311-1978