


# PLAT OF SURVEY

OF

LOT 11 - BLOCK 2  
UNIVERSITY HEIGHTS  
VILLAGE OF WILLIAMS BAY  
WALWORTH COUNTY, WISCONSIN

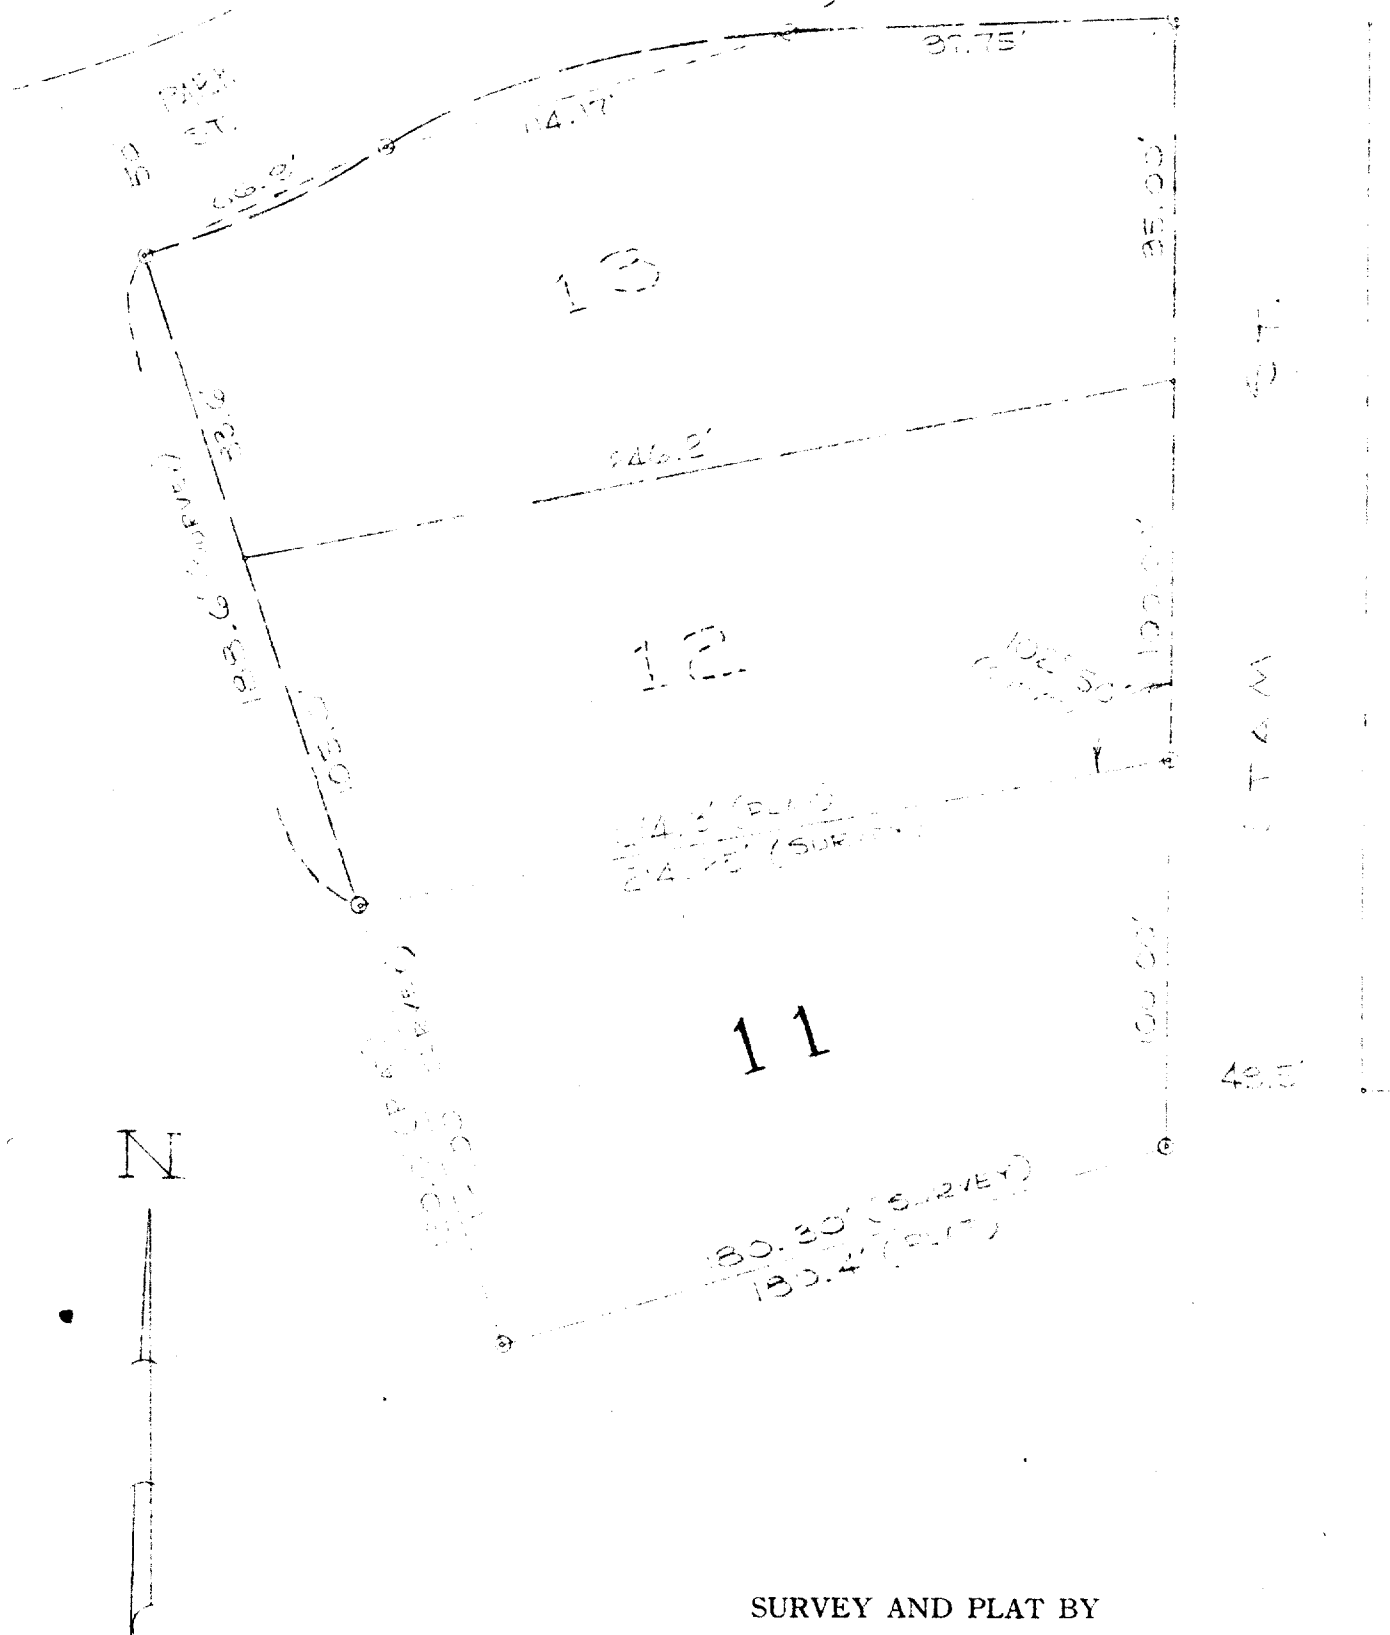

N

## LEGEND

- — Iron Pipe
  - — Concrete Monument
- Scale 1" = 50'

SURVEY AND PLAT BY  
**JENSEN & JOHNSON**  
CIVIL ENGINEERS AND SURVEYORS

Elkhorn, Wisconsin

WE CERTIFY: That we have surveyed the above described property and that the plat shown hereon is an accurate survey and a true representation thereof and correctly shows the exterior boundary lines and all divisions of said property.

Date February 19, 1963

*Lloyd J. Jensen*  
LLOYD J. JENSEN, Partner

Wisconsin Registered Land Surveyor, No. S-211

WUH-13