
PREPARED FOR: LINDA TONGE KEEFE REAL ESTATE, INC 751 GENEVA PARKWAY LAKE GENEVA, WI 53147

PLAT OF SURVEY

J.K. SURVEYING INC. N3705 WILLOWBEND LANE LAKE GENEVA, WI, 53147 262-248-3697

- OF -

LOT 192 CEDAR POINT PARK, A SUBDIVISION LOCATED IN THE VILLAGE OF WILLIAMS BAY, WALWORTH COUNTY, WISCONSIN

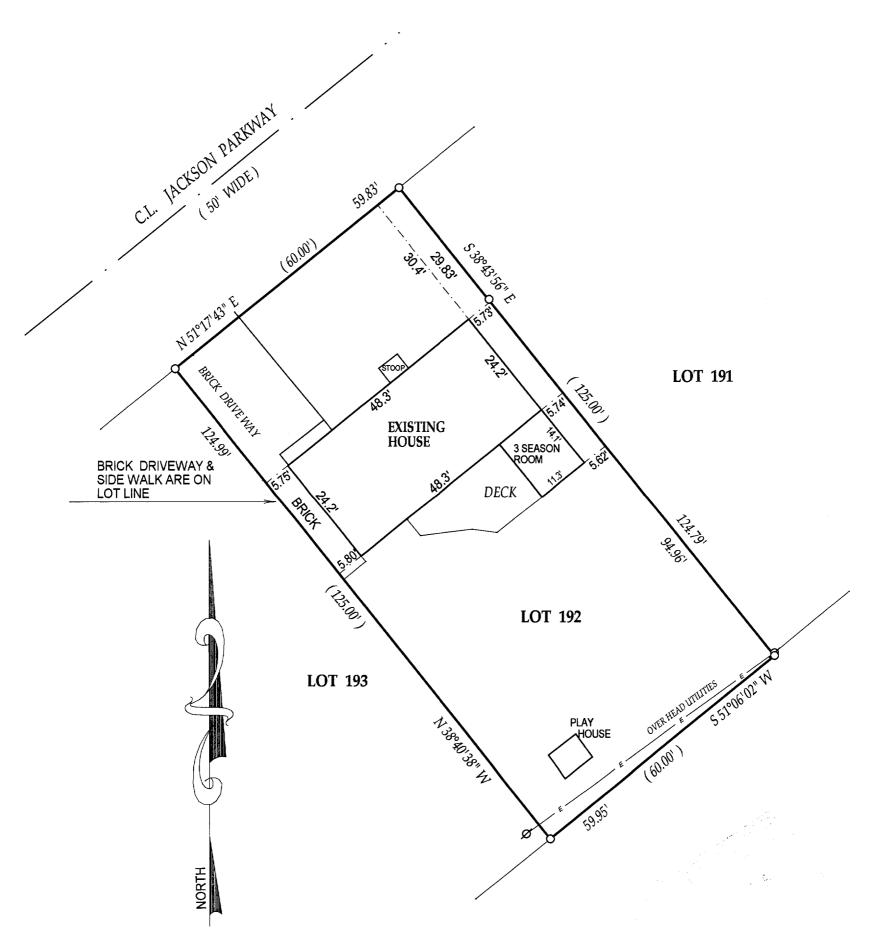

()= recorded as

□ = found iron bar

= found iron pipe

= set iron pipe

■ = set iron bar

SCALE 1" = 20'

JOB # 04-046UPDATE


TAX ID # WCP-166

"I hereby certify that I have surveyed the above described property and that the above map is a true representation thereof and shows the size and location of all visible structures, apparent easements and encroachments

COMPARE LEGAL DESCRIPTION ABOVE AND DRAWING WITH DEED. FOR BUILDING RESTRICTIONS AND EASEMENTS NOT SHOWN, REFER TO DEED, ABSTRACT SOURCES AND LOCAL MUNICIPAL CODES. NOTIFY THE SURVEYOR IMMEDIATELY OF ANY DISCREPANCY.

This survey is made for the present owners of the property, and those who purchase, mortgage, or guarantee the title thereto, within one year from the date hereof.

DATED THIS _____TH, DAY OF _FEBRUARY 20 __04

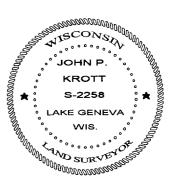

REVISED 3 / 2 / 2005

JOHN KROTT S - 2258 Wisconsin Registered Land Surveyor (original if signed in red)