

- - INDICATES IRON PIPE FOUND
- - INDICATES IRON PIPE SET

DESCRIPTION:

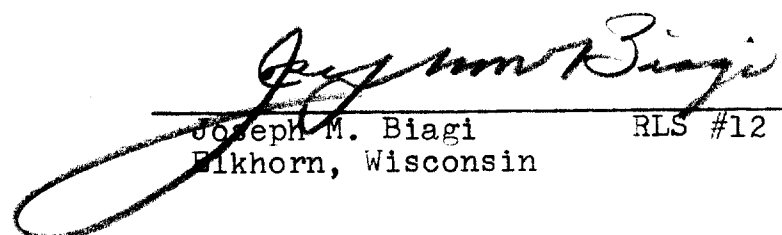
Lot 24 of Block 1 of Harbor View Sub. located in the NE $\frac{1}{4}$  of Section 6, T1N, R17E, in the Village of Williams Bay, Walworth County, Wisconsin.

CERTIFICATE:

I, Joseph M. Biagi, surveyor, do hereby certify that I have surveyed the property hereon described.

DATE:

January 12, 1973

  
 Joseph M. Biagi RLS #12  
 Elkhorn, Wisconsin