PREPARED FOR: DAN NOR 419 W GENEVA ST. WILLIAMS BAY, WI 53191

PLAT OF SURVEY

-OF-


THE NORTHWEST 1/4 OF LOT 10 IN OBSERVATORY SUBDIVISION, IN THE VILLAGE OF WILLIAMS BAY, WALWORTH COUNTY, WISCONSIN.

PATHFINDER SURVEYING INC. W2888 KRUEGER ROAD, UNIT "D" LAKE GENEVA, WI, 53147 262-248-3697



GENEVA STREET

(50' WIDE)

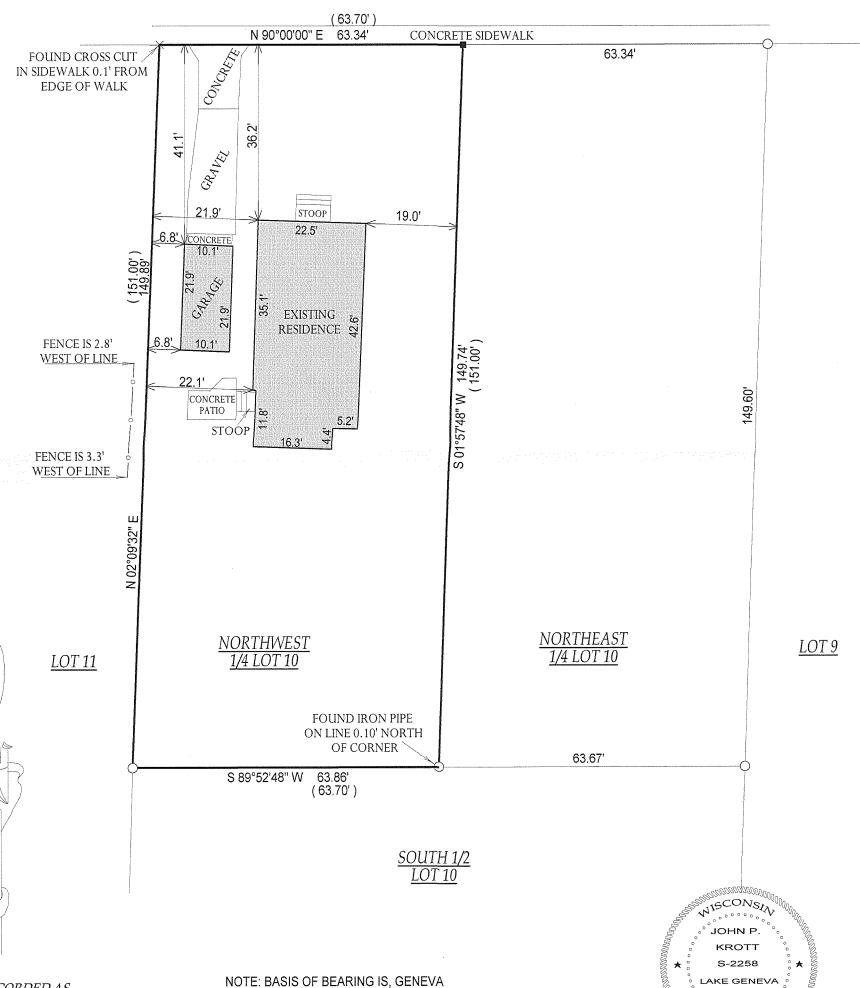

() = RECORDED AS

 \Box = FOUND IRON BAR

= FOUND IRON PIPE

= SET IRON PIPE

= SET IRON BAR

SCALE: 1" = 20'

JOB #: 06-360

TAX ID#: WOB 00021

STREET ASSUMED EAST-WEST.

COMPARE LEGAL DESCRIPTION ABOVE AND DRAWING WITH DEED. FOR BUILDING RESTRICTIONS AND EASEMENTS NOT SHOWN, REFER TO DEED, ABSTRACT SOURCES AND LOCAL MUNICIPAL CODES. NOTIFY THE SURVEYOR IMMEDIATELY OF ANY DISCREPANCY.

"I hereby certify that the above described property was surveyed under my supervision and that the above map, to the best of my knowledge and belief, is a true representation thereof and shows the size and location of all visible structures, apparent easements and encroachments if any." This survey is made for the present owners of the property, and those who purchase, mortgage, or guarantee the title thereto, within one year from the date hereof.



JOHN KROTT S - 2258

Wisconsin Registered Land Surveyor (original if signed in red)

DATED THE 3rd DAY OF AUGUST, 2006.