



#34/72

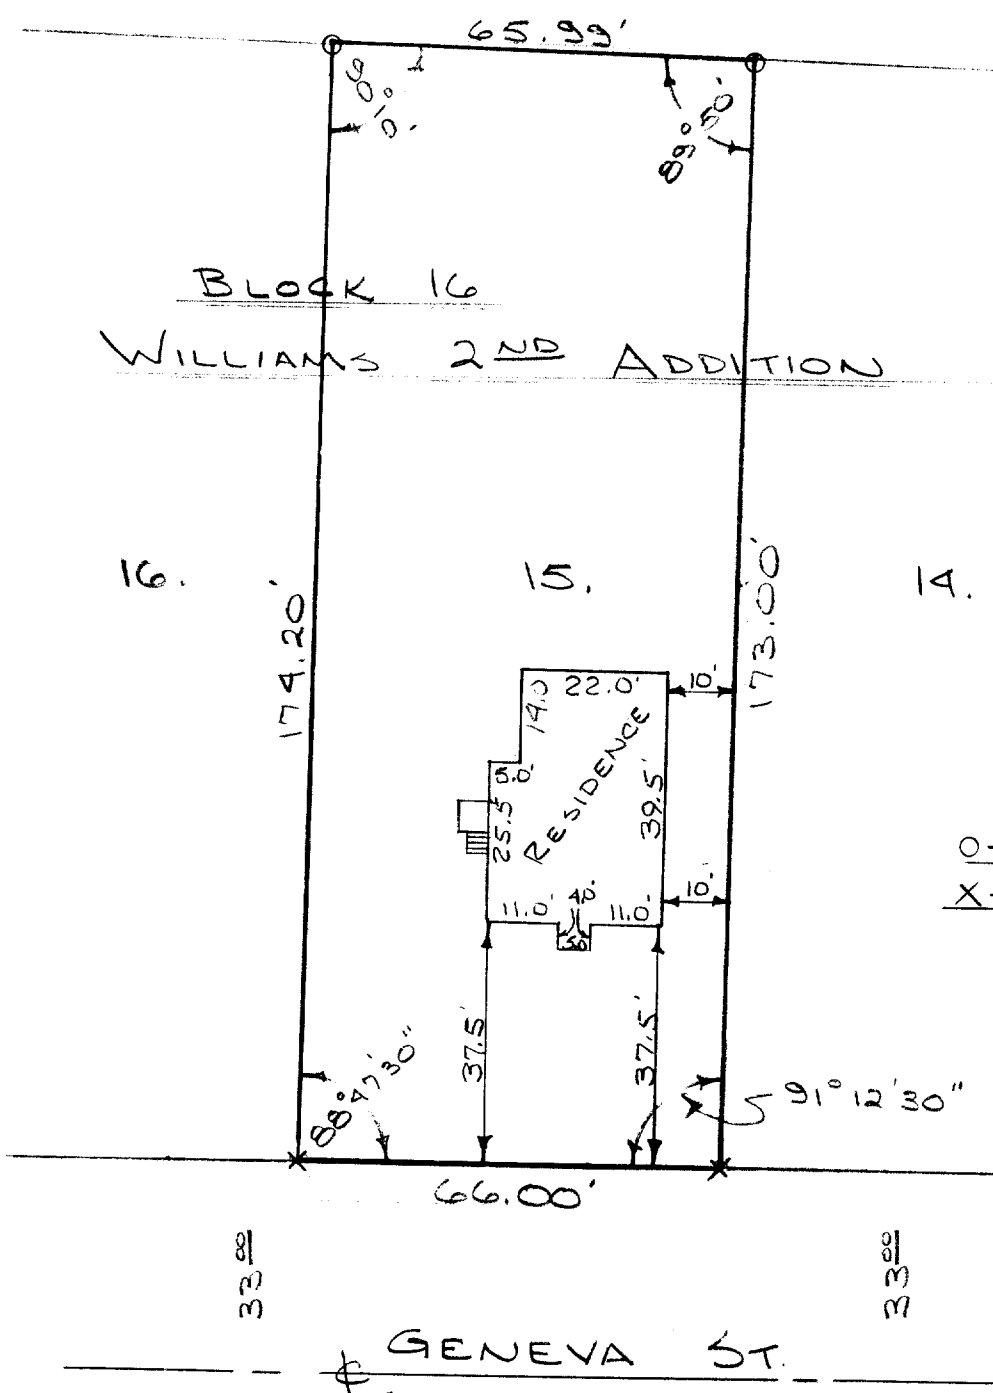

O-INDICATES IRON PIPE
X-INDICATES CHISELED X

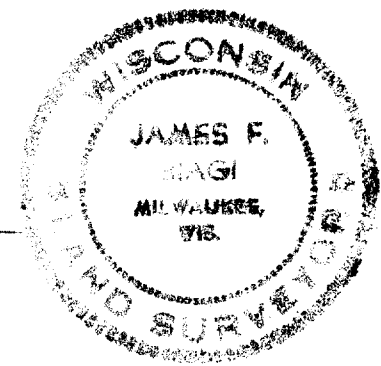

DESCRIPTION:
All of Lot number Fifteen (15) in Block number Sixteen (16) of Williams 2nd Addition, to the Village of Williams Bay, Walworth County, Wisconsin.

CERTIFICATE:
I, James F. Biagi, surveyor, do hereby certify that I have surveyed the lands hereon described.

July 24, 1972

James F. Biagi
James F. Biagi RLS #272

woof-229

11-208