
Plat of Survey


The East 1/2 of Lot 3 and the West 37 feet of Lot 2 of Block 19 of Williams 3rd Addition to the Village of Williams Bay,

located in the Southeast 1/4 of Section 1, Town 1 North, Range 16 East, Village of Williams Bay, Walworth County, Wisconsin.

Surveyed for: RE/MAX Geneva Realty, Ltd.

101 Broad Street Lake Geneva, Wisconsin. 53147

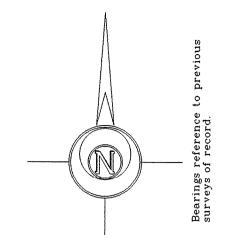

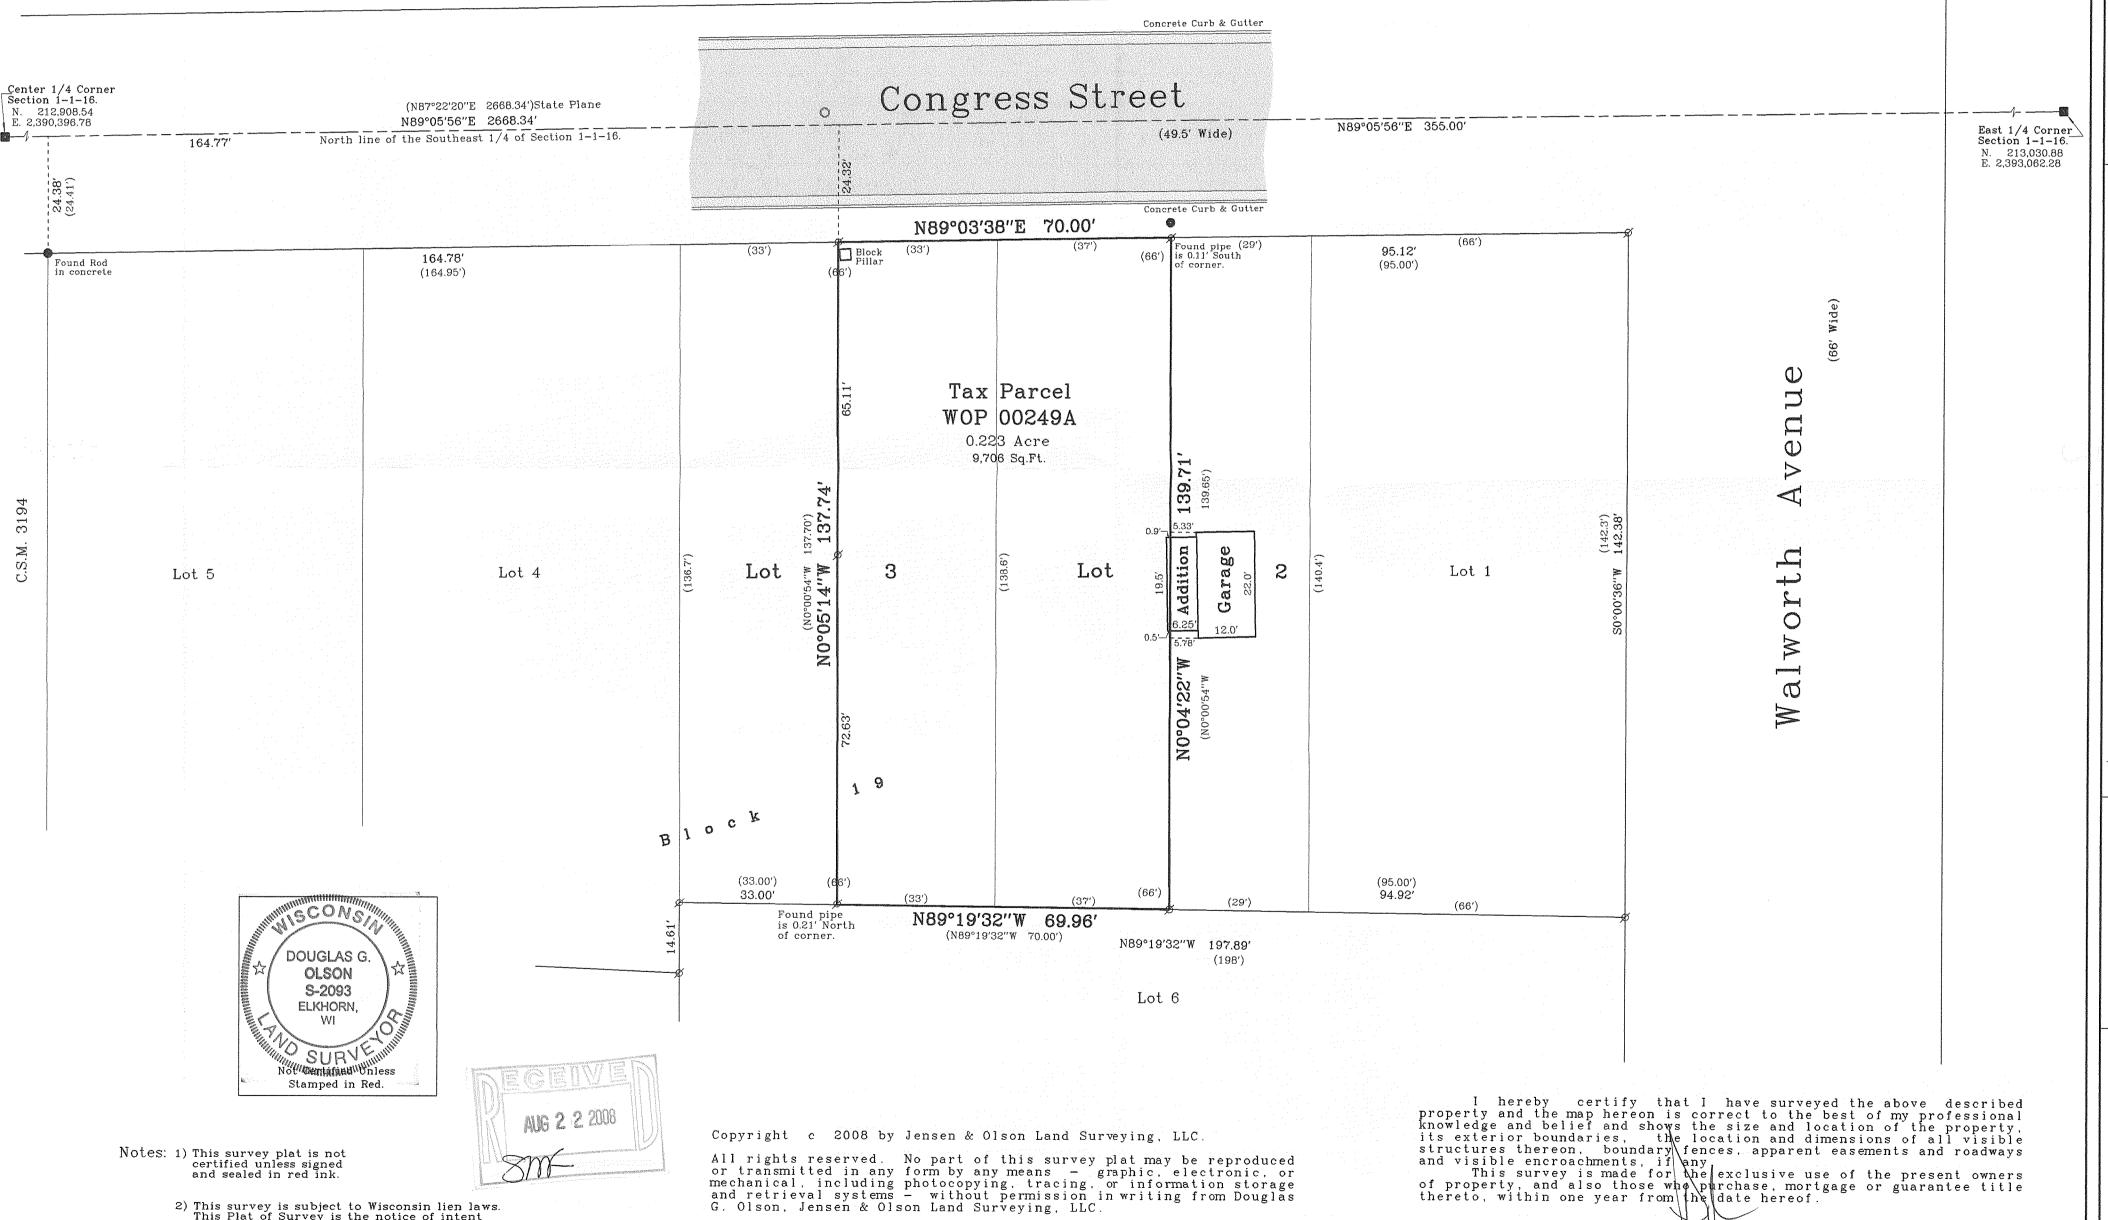

WOP- 249A

This survey is subject to Wisconsin lien laws. This Plat of Survey is the notice of intent to file lien. Lien waiver required.

Wisdon's in Registered Land Surveyor - 2093

O sen

en

MØOCO Sheets

Nu 2008.068 o. Sheet

qof 2008.068