



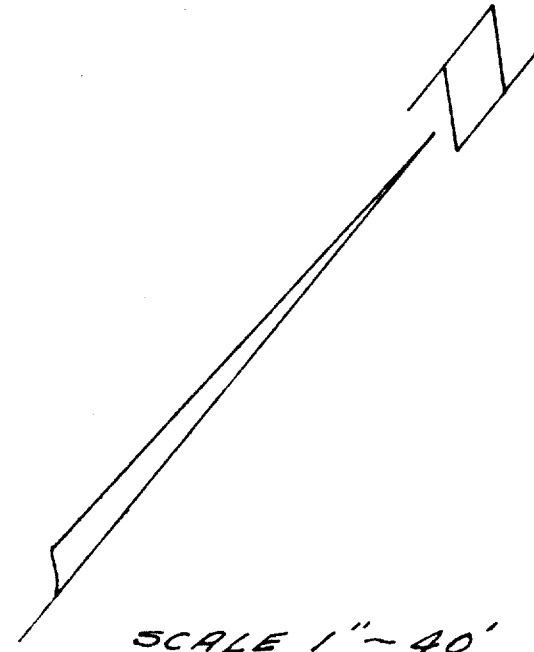

SCALE 1" = 40'
 O - IRON PIPE SET
 X - IRON PIPE FOUND
 MH - MAN HOLE
 () - BEARING TAKEN FROM SUBDIVISION PLAT

PLAT OF SURVEY
 OF
 LOTS 12 & 13 OF CEDAR POINT
 SUBDIVISION LOCATED IN SECTIONS
 5 & 6, T1N R1E, VILLAGE OF WILLIAMS
 BAY, WALWORTH COUNTY, WISCONSIN.
 JUNE 1972

Lloyd L. Jensen
 LLOYD L. JENSEN
 COUNTY SURVEYOR

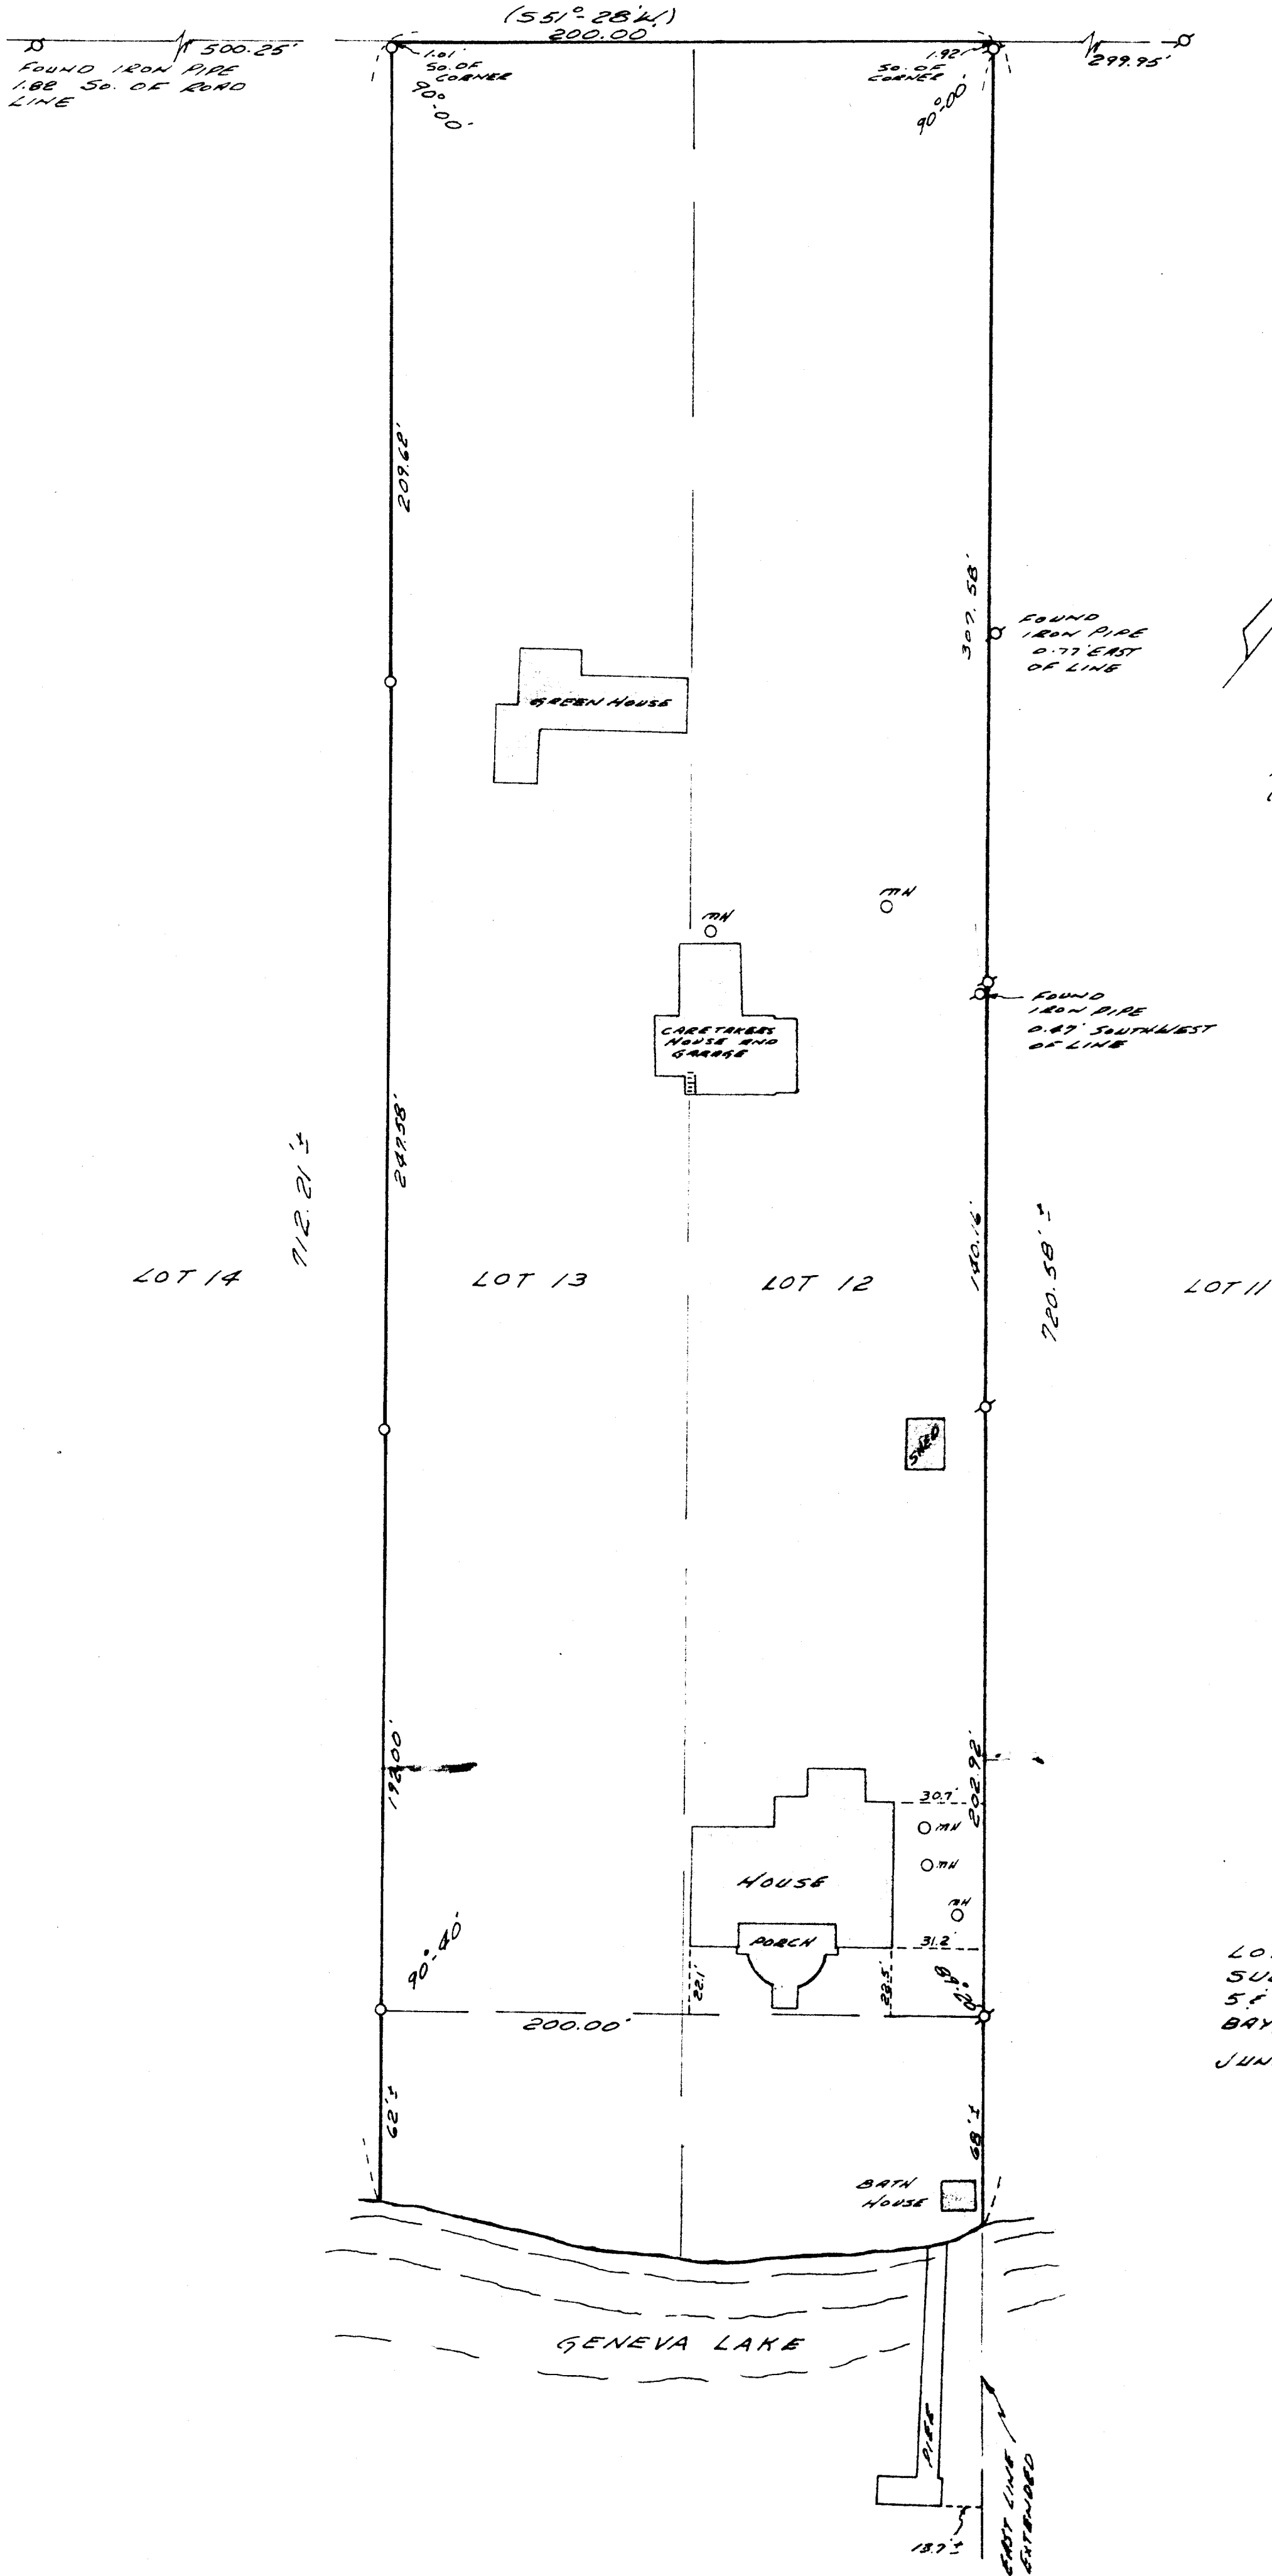