


FARRIS, HANSEN & ASSOCIATES, INC.

ENGINEERING — ARCHITECTURE — SURVEYING
7 RIDGWAY COURT — P.O. BOX 437 — ELKHORN, WISCONSIN 53121
PHONE: (262) 723-2098 FAX: (262) 723-5886

PLAT OF SURVEY LOT 4 OF SUMMER HAVEN



LOCATED IN PART OF SECTION 6, TOWN 1 NORTH, RANGE 17 EAST
AND SECTION 1, TOWN 1 NORTH, RANGE 16 EAST, VILLAGE OF
WILLIAMS BAY, WALWORTH COUNTY, WISCONSIN

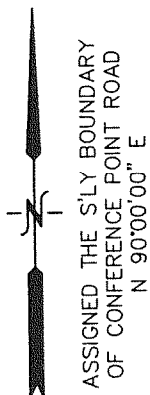

CONFERENCE POINT ROAD
{30' WIDE R.O.W.}

— WORK ORDERED BY —
JOANNE GLEASON
1523 NORTH WALNUT AVENUE
ARLINGTON HEIGHTS, IL 60004

NOTE: EASEMENTS OF RECORD APPEAR TO
GIVE THE VILLAGE OF WILLIAMS BAY
THE RIGHT TO RUN UTILITIES WITHIN
THE ROAD RIGHT OF WAYS.

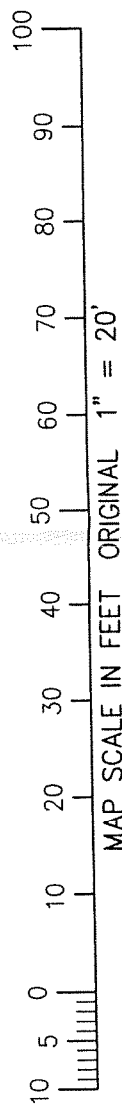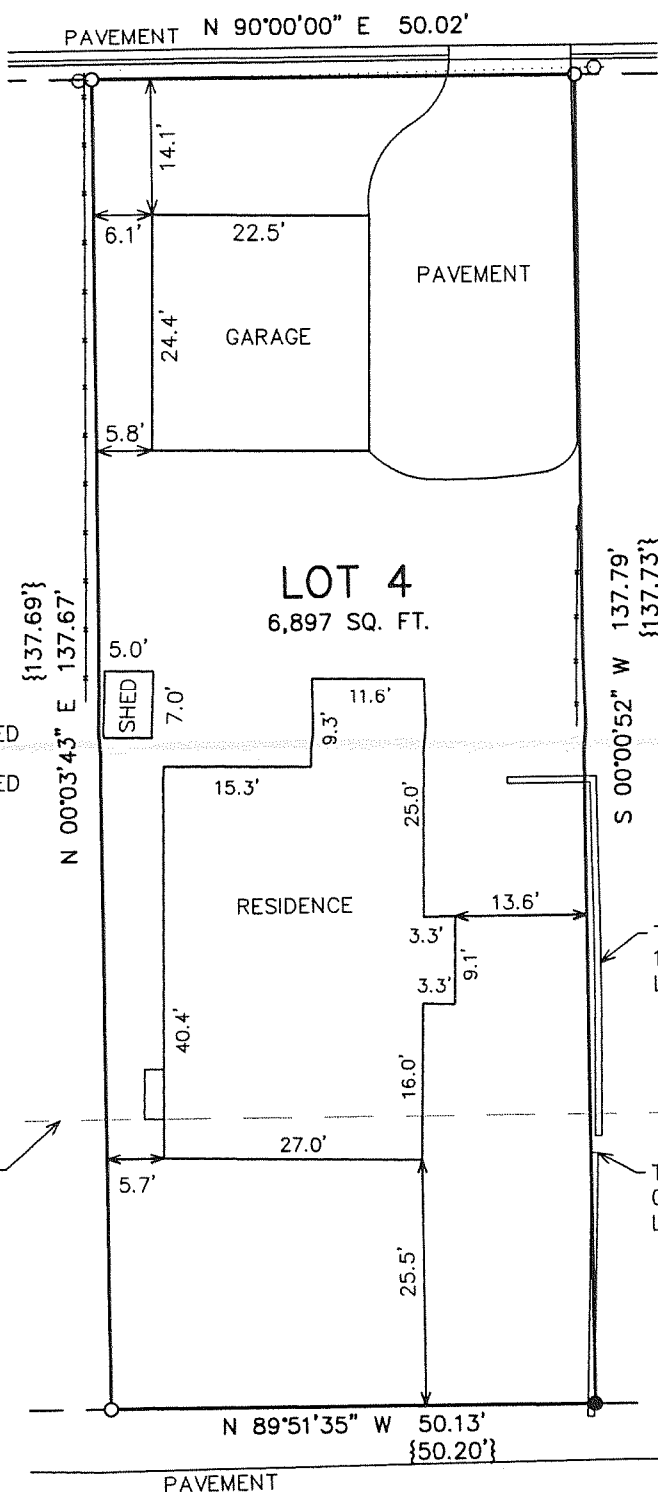

LEGEND


- = FOUND IRON PIPE STAKE
- = FOUND IRON REBAR STAKE
- ◇ = UTILITY POLE LOCATED

..... = OVERHEAD WIRES

—+—+—+— = FENCE LINE

{XXX} = RECORDED AS

LIECHTY DRIVE
{30' WIDE R.O.W.}

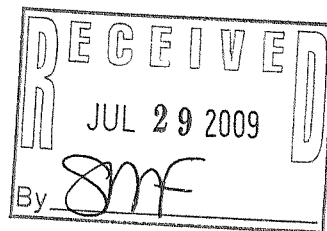

NOTE: COPIES OF THIS MAP TO WHICH THE FOLLOWING CERTIFICATE WILL APPLY SHOW
THE SURVEYOR'S ORIGINAL SEAL AND SIGNATURE IN RED INK. COPIES BY ANY OTHER
MEANS MAY HAVE ALTERATIONS WHICH DO NOT REPRESENT THE SURVEYOR'S WORK
PRODUCT.

I HEREBY CERTIFY THAT THE ABOVE DESCRIBED PROPERTY HAS BEEN SURVEYED UNDER
MY DIRECTION AND THAT THE ABOVE MAP IS A TRUE REPRESENTATION THEREOF AND
SHOWS THE SIZE AND LOCATION OF THE PROPERTY, ITS EXTERIOR BOUNDARIES, THE
LOCATION OF ALL VISIBLE STRUCTURES, AND DIMENSIONS OF ALL PRINCIPLE
BUILDINGS THEREON, BOUNDARY FENCES, APPARENT EASEMENTS, ROADWAYS, AND
VISIBLE ENCROACHMENTS, IF ANY. THIS SURVEY IS MADE FOR THE USE OF THE
PRESENT OWNERS OF THE PROPERTY, AND ALSO THOSE WHO PURCHASE, MORTGAGE, OR
GUARANTEE THE TITLE THERETO WITHIN ONE YEAR FROM THE DATE HEREOF.

DATED: 7/23/2009

PETER S. GORDON

PROJECT: 7953
DATE: 07/23/2009
SHEET 1 OF 1

