

PREPARED FOR
LINDA TONGE
KEEFE REAL ESTATE, INC.
751 GENEVA PARKWAY
PO BOX 460
LAKE GENEVA WI 53147



PLAT OF SURVEY

-OF-

LOT 223 OF CEDAR POINT PARK SUBDIVISION LOCATED
IN TOWN 1 NORTH, RANGE 17 EAST, VILLAGE OF WILLIAMS
BAY, WALWORTH COUNTY, WISCONSIN.

KROTT SURVEYING INC.


N3705 WILLOW BEND LANE
LAKE GENEVA WI. 53147
PHONE # (262)248-3697
FAX # (262)249-0639

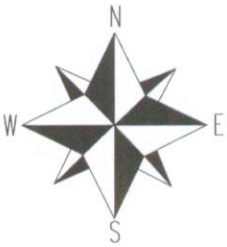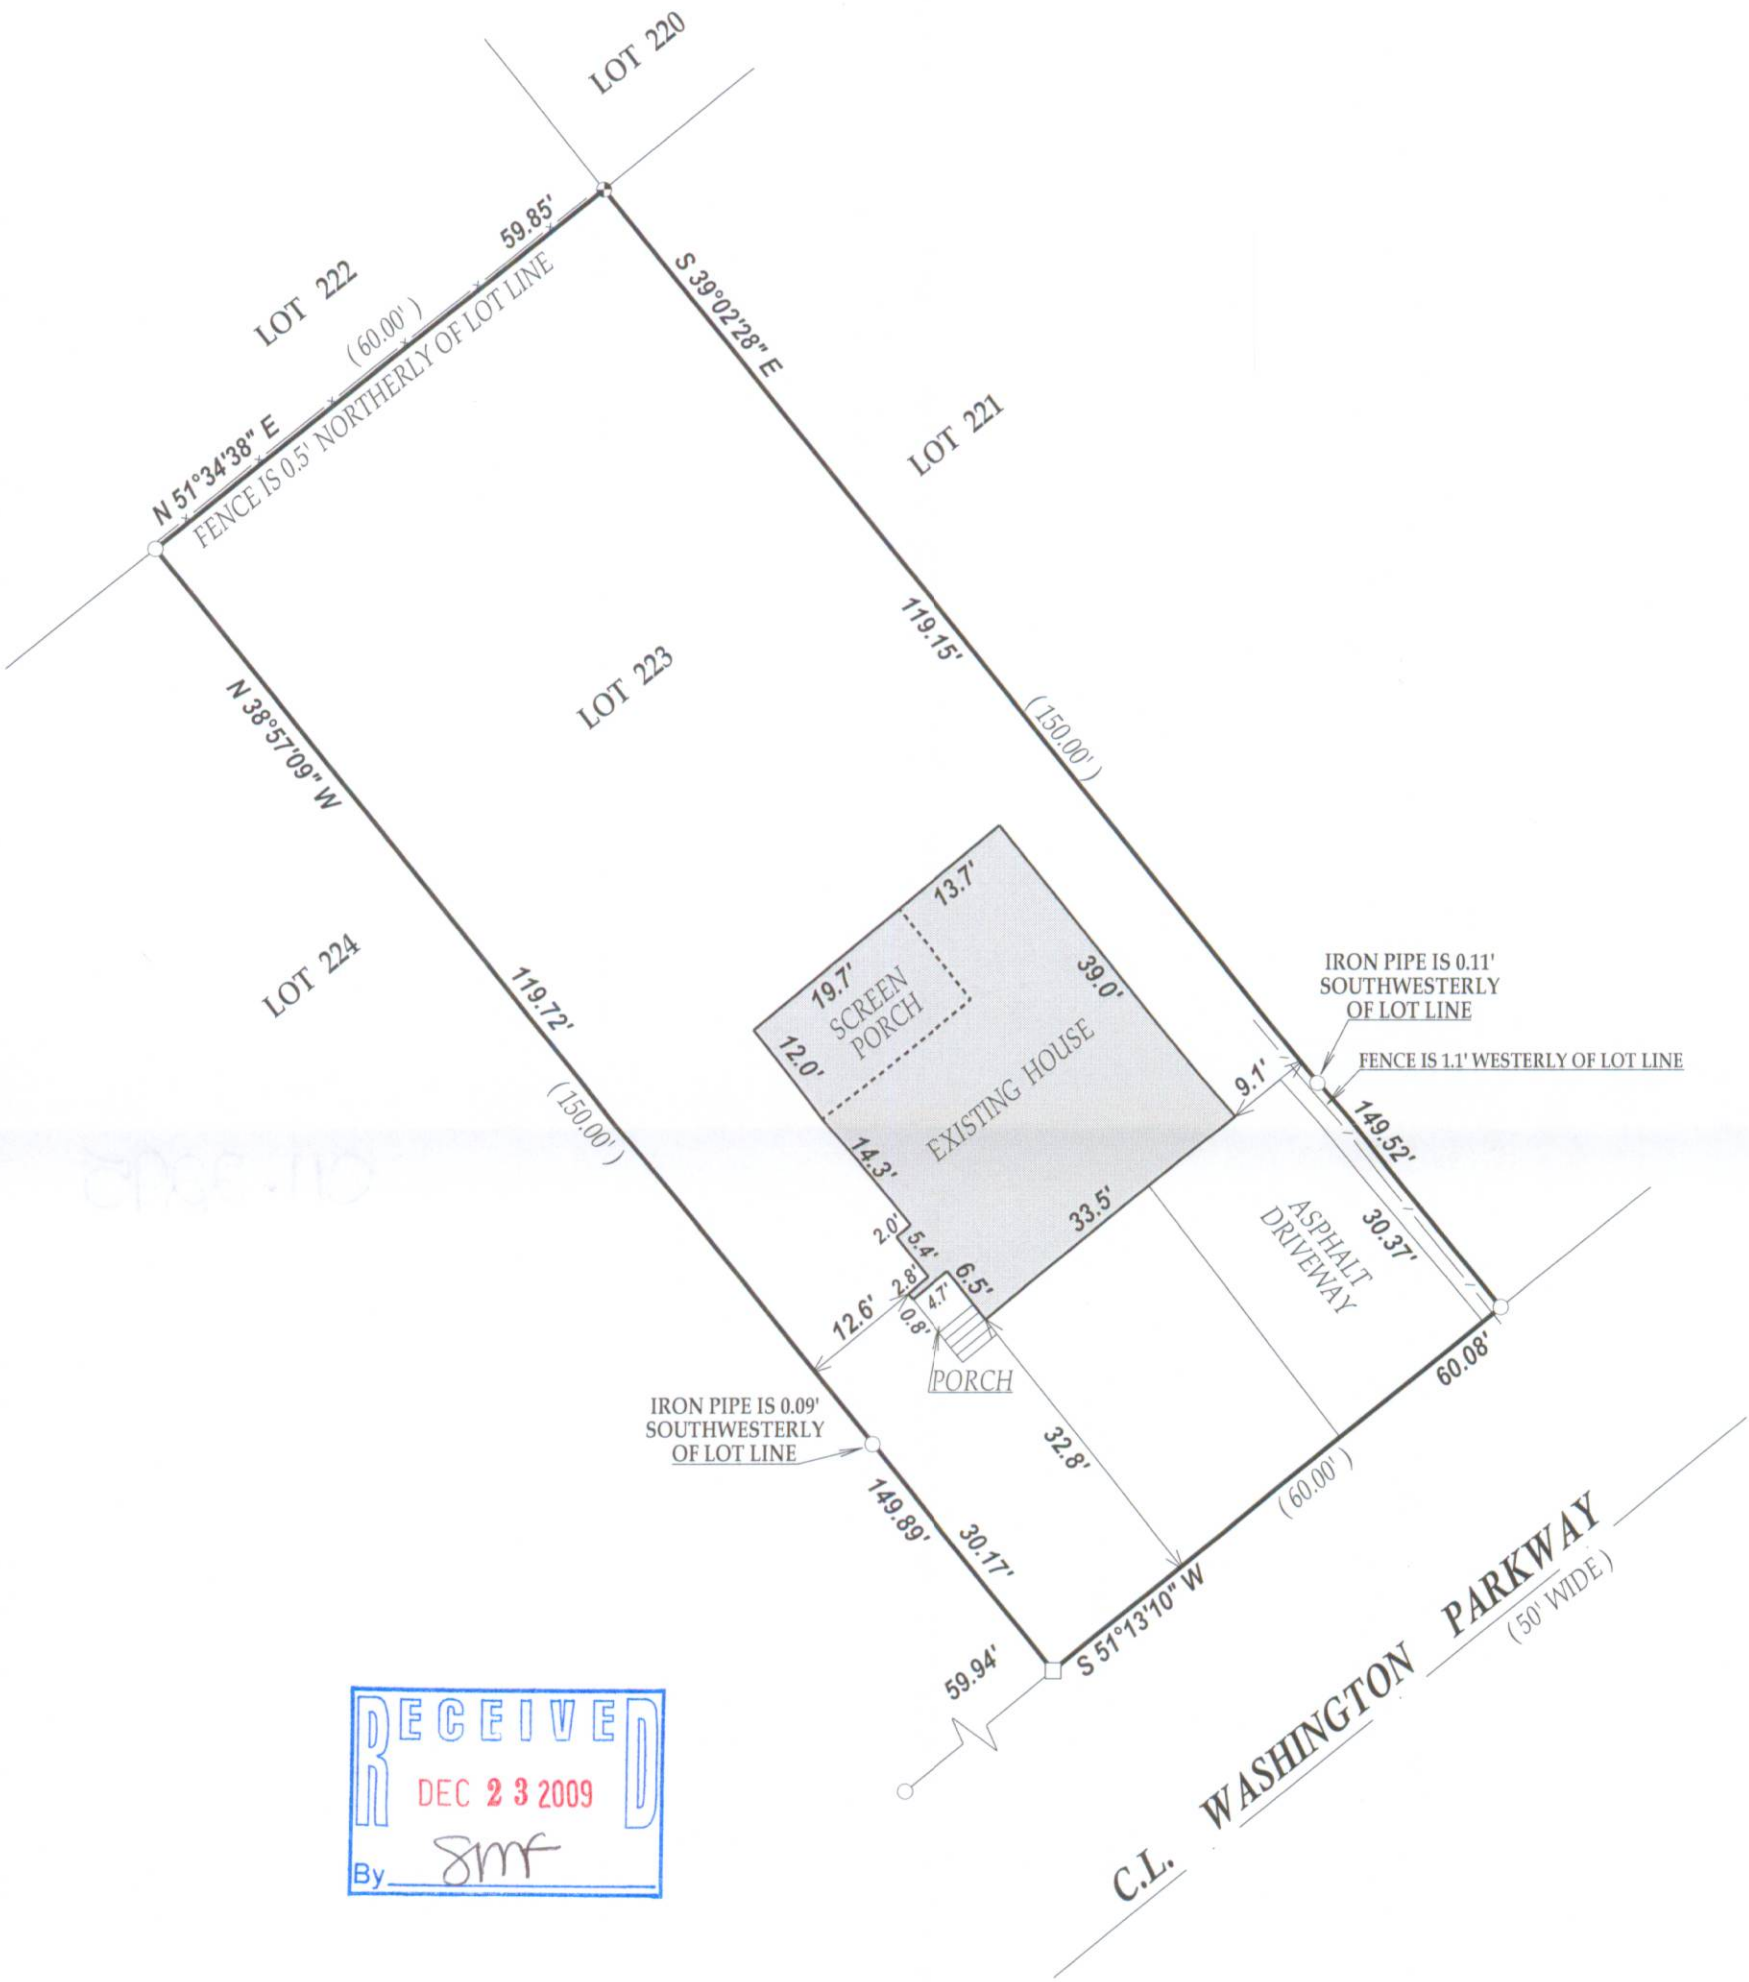

LEGEND

- FOUND IRON PIPE
- FOUND IRON BAR
- ⊙ FOUND CONCRETE MONUMENT

(XX) RECORDED AS
TAX ID # WCP00198
JOB # 09-169

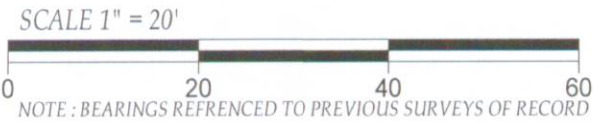

I have surveyed the above-described property and the above map is a true representation thereof and shows the size and location of the property, its exterior boundaries, the location and dimensions of all structures thereon, fences apparent easements and roadways and visible encroachments, if any.

This survey is made for the exclusive use of the present owners of the property, and also those who purchase, mortgage, or insure the title thereto within one (1) year from date hereof; and as to them I warrant the accuracy of said survey map.



DATED THIS 16th DAY OF NOVEMBER 2009.

John P. Krott

JOHN KROTT S - 2258
Wisconsin Registered Land Surveyor
(original if signed in red)

011-2295