

3. The land referred to in the Commitment is described as follows:

Lot 207 in Block 2 in Lakewood Trails North Subdivision located in the Northwest 1/4 and the Northeast 1/4 of the Northwest 1/4 of Section 1, Township 1 North, Range 16 East, in the Village of Williams Bay, County of Walworth, State of Wisconsin.

Tax Key No: WLAKN 00016

PLAT OF SURVEY
LOT 207 OF BLOCK 2
LAKEWOOD TRAILS NORTH SUBDIVISION
LOCATED IN PART OF THE NW 1/4 AND THE NE 1/4
OF THE NW 1/4 OF SECTION 1, TOWN 1 NORTH,
RANGE 16 EAST, VILLAGE OF WILLIAMS BAY,
WALWORTH COUNTY, WISCONSIN




PLAT OF SURVEY
LOT 207 BLOCK 2
LAKEWOOD TRAILS NORTH SUBDIVISION

WORK ORDERED FOR: TRENT MARTIN
BY: KEEFE REAL ESTATE
751 GENEVA PARKWAY
LAKE GENEVA, WI.

FARRIS, HANSEN & ASSOCIATES, INC.
Engineering, Architecture, Surveying
7 Ridgway Court P.O. Box 437
ELKHORN, WISCONSIN 53121
Office: (262) 723-2098
Fax: (262) 723-5866

REVISIONS
10/05/2004
SHOW SIZE &
LOCATION OF
AS-BUILT
FOUNDATION

PROJECT NO.
3836.02.207
DATE:
05/28/02
SHEET NO.
1 OF 1

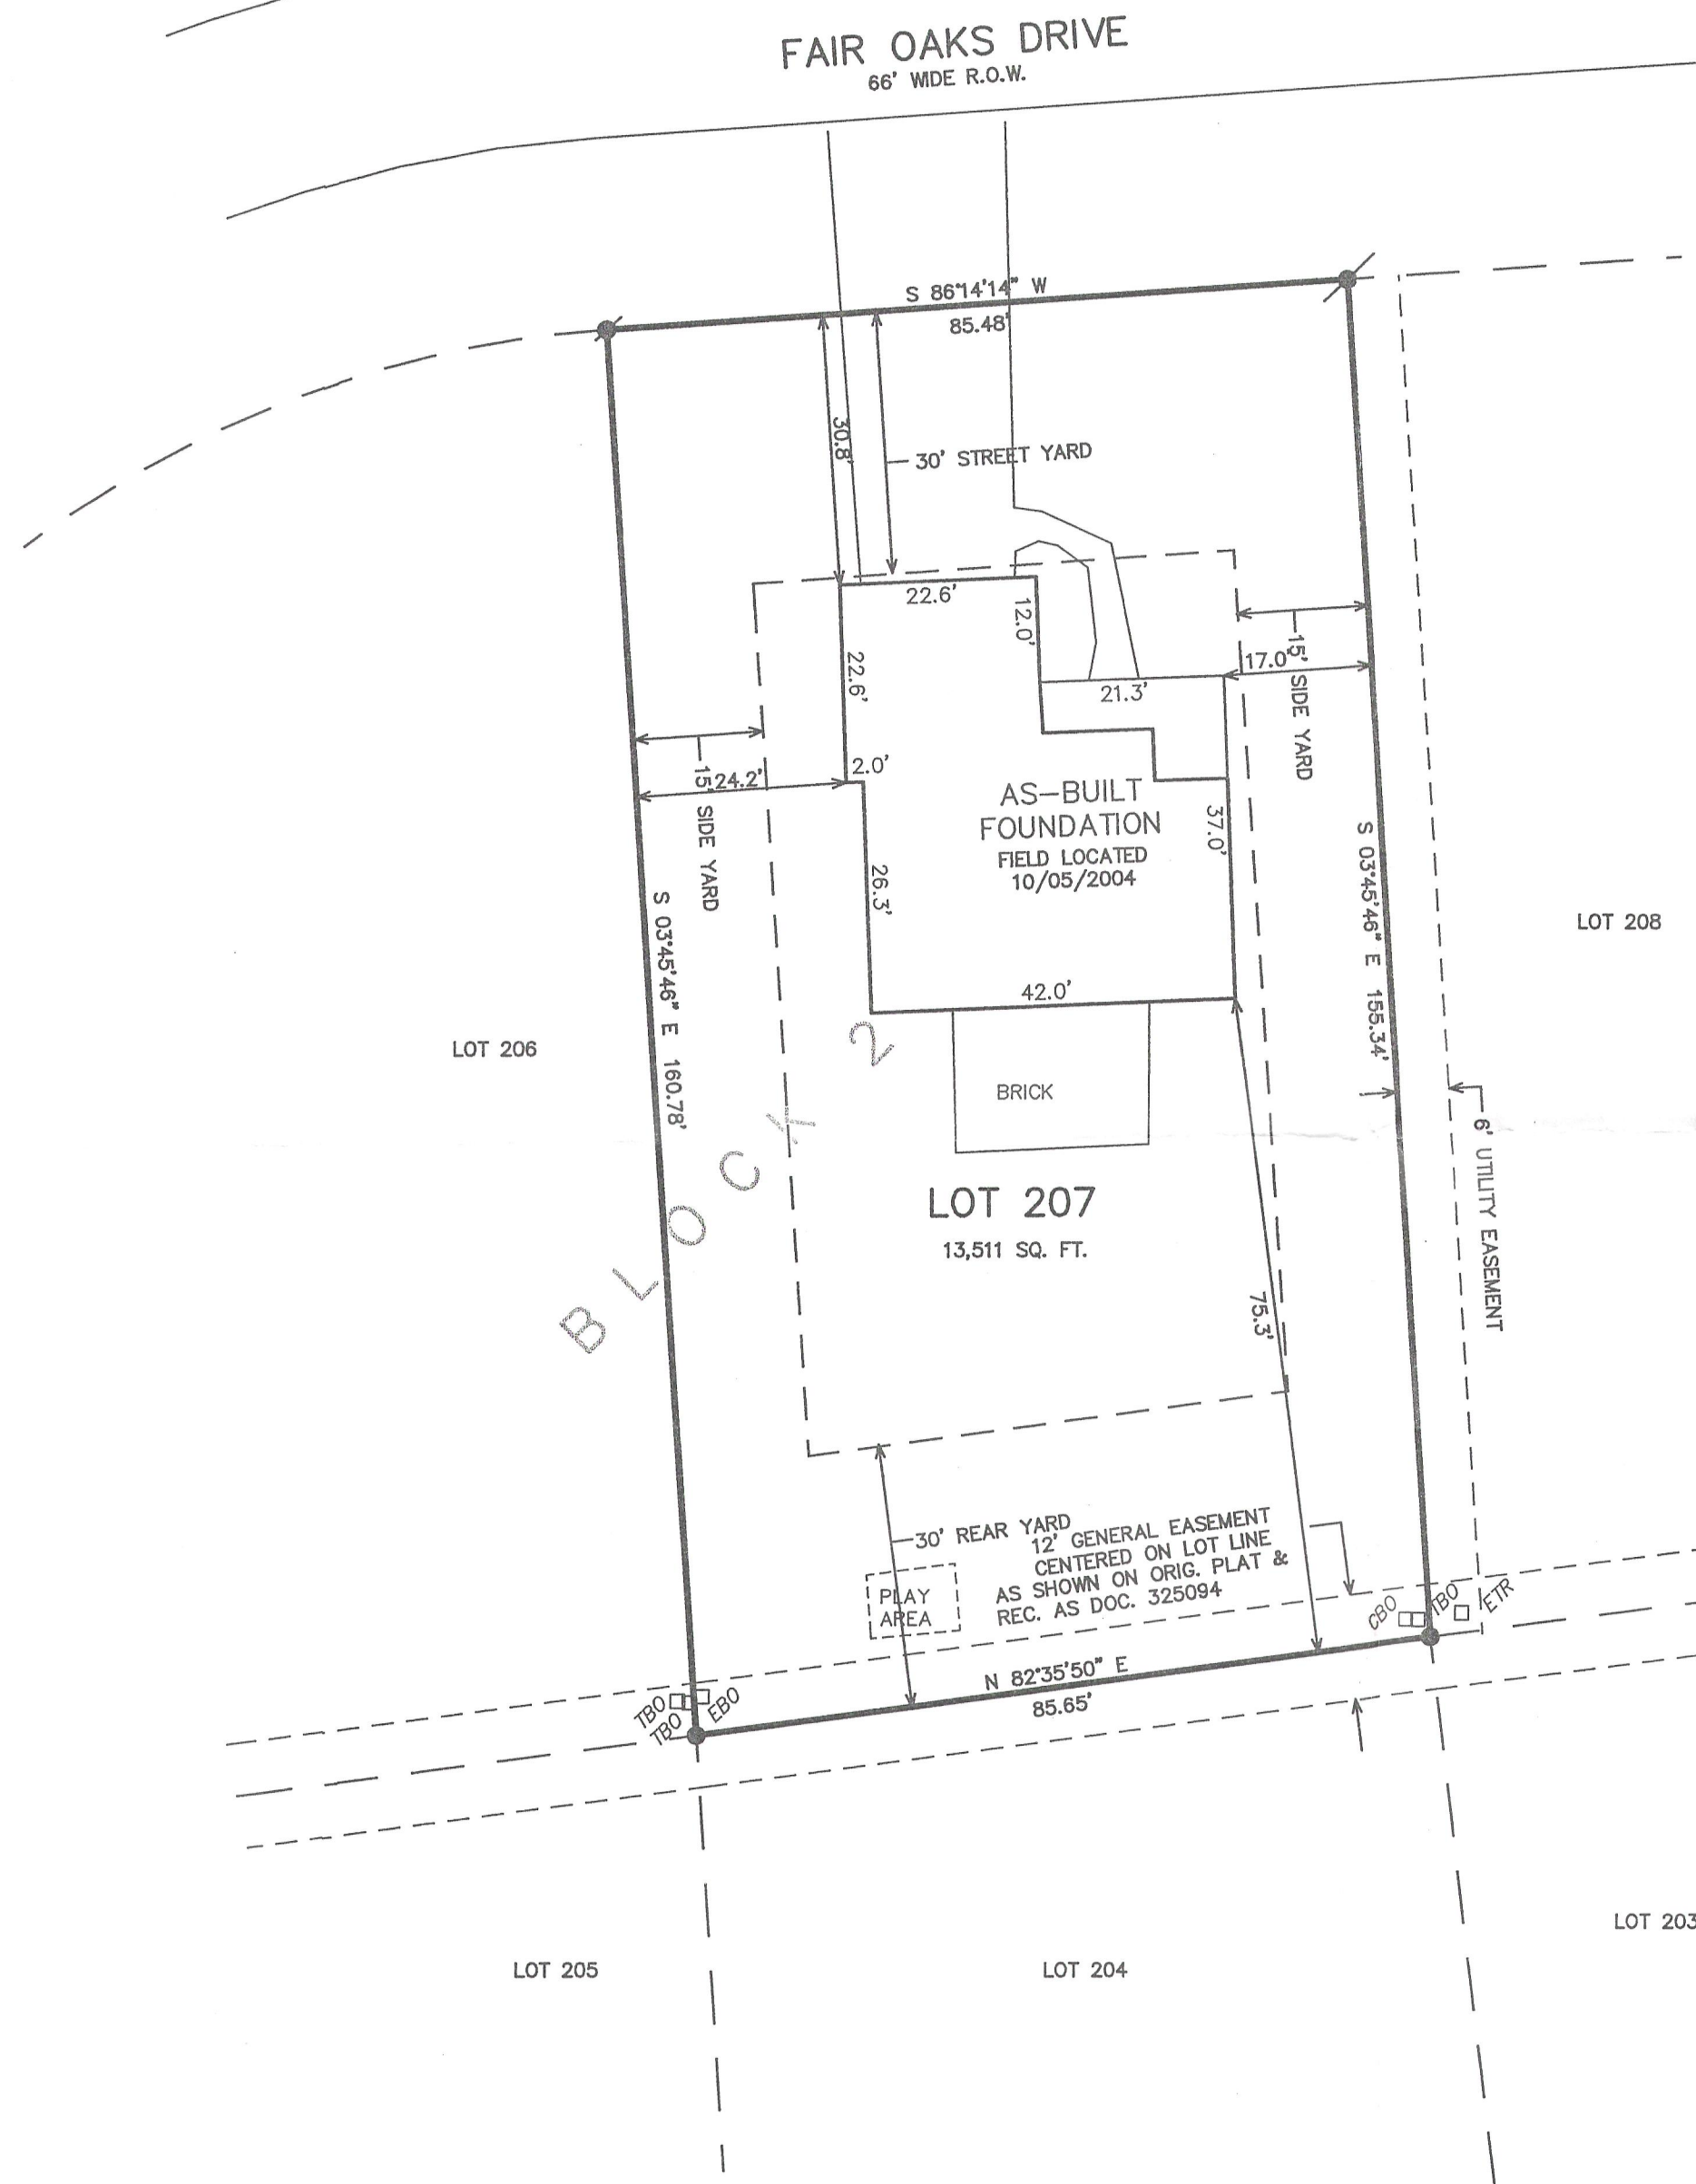

LEGEND

- = SET IRON REBAR STAKE
- = FOUND IRON REBAR STAKE

(XXX) = RECORDED AS

CBO = CABLE CONTROL BOX
TBO = TELEPHONE CONTROL BOX
ETR = ELECTRIC TRANSFORMER



NOTE: GENERAL EASEMENT IS A COMBINATION
OF UTILITY, DRAINAGE, AND WALKWAY EASEMENTS.

NOTE: COPIES OF THIS MAP TO WHICH THE FOLLOWING CERTIFICATE WILL APPLY SHOW SURVEYOR'S ORIGINAL
SEAL AND SIGNATURE IN RED INK. COPIES BY ANY OTHER MEANS MAY HAVE ALTERATIONS WHICH DO NOT
REPRESENT THE SURVEYOR'S WORK PRODUCT.

I HEREBY CERTIFY THAT THE ABOVE DESCRIBED PROPERTY HAS BEEN SURVEYED UNDER MY DIRECTION AND THAT
THE ABOVE MAP IS A TRUE REPRESENTATION THEREOF AND SHOWS THE SIZE AND LOCATION OF THE PROPERTY, ITS
EXTERIOR BOUNDARIES, THE LOCATION OF ALL VISIBLE STRUCTURES, AND DIMENSIONS OF ALL PRINCIPLE
BUILDINGS THEREON, BOUNDARY FENCES, APPARENT EASEMENTS, ROADWAYS, AND VISIBLE ENCROACHMENTS, IF
ANY. THIS SURVEY IS MADE FOR THE USE OF THE PRESENT OWNERS OF THE PROPERTY, AND ALSO THOSE WHO
PURCHASE, MORTGAGE, OR GUARANTEE THE TITLE THERETO WITHIN ONE YEAR FROM THE DATE HEREOF.

DATED: DECEMBER 21, 2009

PETER S. GORDON R.L.S. 2101

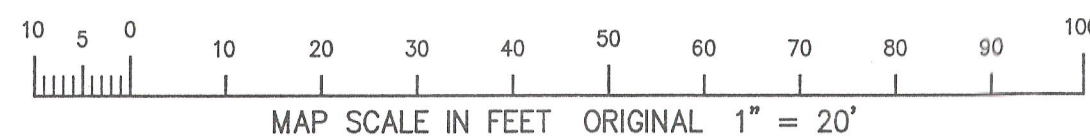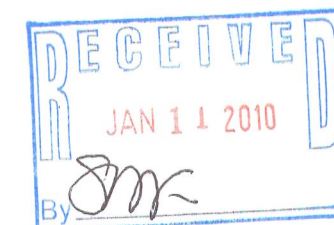

WLAKN-16

011-2299