


#92/72

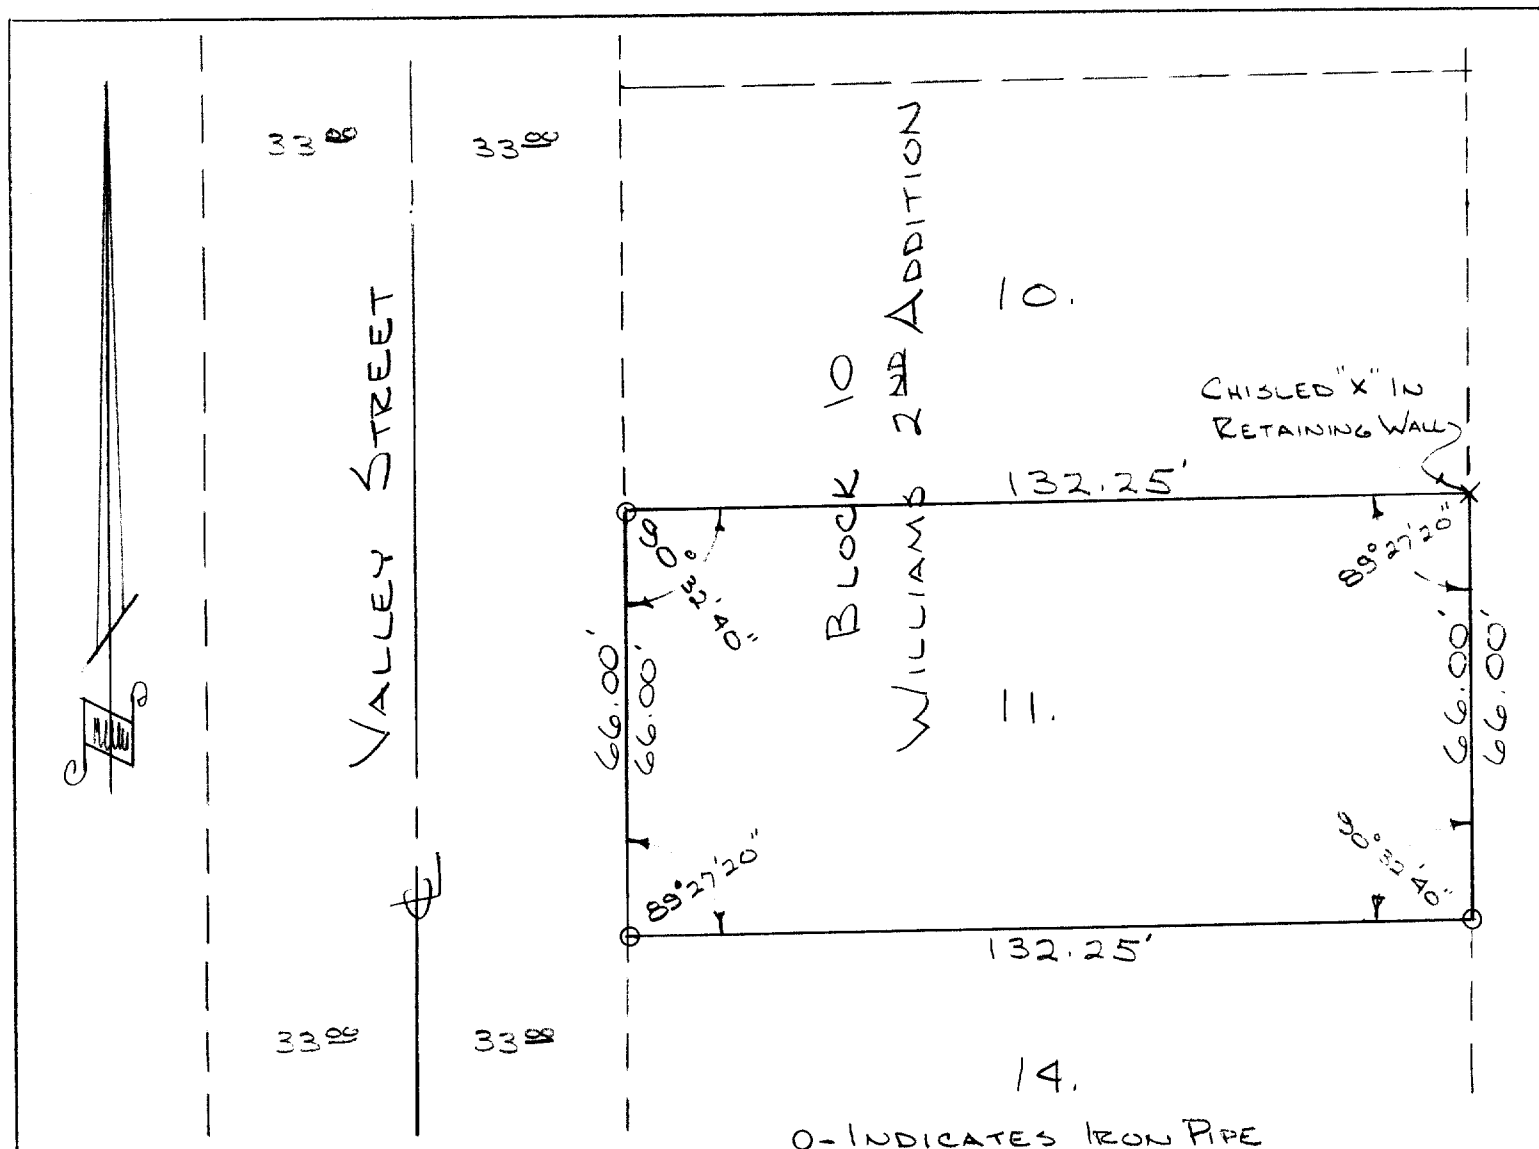

DESCRIPTION:


Lot number Eleven (11) of Block number Ten (10) of Williams 2nd Addition, Village of Williams Bay, Walworth County, Wisconsin.

CERTIFICATE:

I, James F. Biagi, surveyor, do hereby certify that I have surveyed the lands hereon described.

August 4, 1972

James F. Biagi
James F. Biagi RLS #272

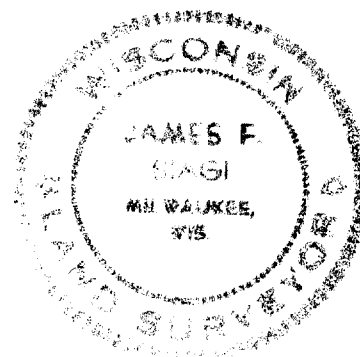

11-22B