
ENGINEERING - ARCHITECTURE - SURVEYING
7 RIDGWAY COURT - P.O. BOX 437 - ELKHORN, WISCONSIN 53121
PHONE: (262) 723-2098 FAX: (262) 723-5886

PLAT OF SURVEY

LOT 50 LACKEY BROTHERS SUBDIVISION
LOCATED IN THE SW 1/4 OF SECTION 6
TOWN 1 NORTH, RANGE 17 EAST
VILLAGE OF WILLIAMS BAY
WALWORTH COUNTY, WISCONSIN

WORK ORDERED BY –
 LYNN LANDGRAF
 851 PARK DRIVE
 LAKE GENEVA, W. 53147

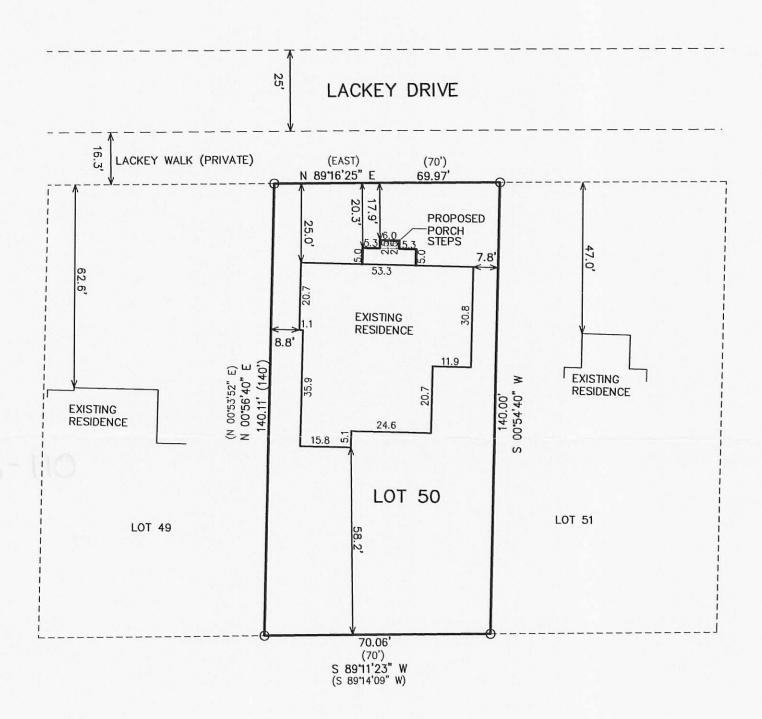

100 90 80 70 60 50 40 30 20 10 50 MAP SCALE IN FEET ORIGINAL 1" = 30'

LEGEND
O = FOUND IRON PIPE STAKE
(XXX) = RECORDED AS
AREA = 9,800 S.F. (0.23 AC.)

NOTE: COPIES OF THIS MAP TO WHICH THE FOLLOWING CERTIFICATE WILL APPLY SHOW SURVEYOR'S ORIGINAL SEAL AND SIGNATURE IN RED INK. COPIES BY ANY OTHER MEANS MAY HAVE ALTERATIONS WHICH DO NOT REPRESENT THE SURVEYOR'S WORK PRODUCT.

I HEREBY CERTIFY THAT THE ABOVE DESCRIBED PROPERTY HAS BEEN SURVEYED UNDER MY DIRECTION AND THAT THE ABOVE MAP IS A TRUE REPRESENTATION THEREOF AND SHOWS THE SIZE AND LOCATION OF THE PROPERTY AND ITS EXTERIOR BOUNDARIES. THIS SURVEY IS MADE FOR THE USE OF THE PRESENT OWNERS OF THE PROPERTY, AND ALSO THOSE WHO PURCHASE, MORTGAGE, OR GUARANTEE THE TITLE THERETO WITHIN ONE YEAR FROM THE DATE HEREOF

DATED: APRIL 14, 2010

PETER S. GORDON R.L.S. 2101

PETER S.
GORDON
S-2101
ELKHORN,
WI



PROJECT: 8110 DATE: 04-14-2010 SHEET 1 OF 1

WLB-49

50

EAST LINE LOT 00'54'40" W

ASSIGNED S C

011-2317

X: \Projects\8110\dcad\survey

4/14/2010 X: