PREPARED FOR: TRICIA FORBECK KEEFE REAL ESTATE, INC. 751 GENEVA PARKWAY LAKE GENEVA, WI 53147


PLAT OF SURVEY

-OF-

KROTT SURVEYING INC.
N3705 WILLOW BEND LANE

LAKE GENEVA WI. 53147 PHONE # (262)248-3697 FAX # (262)249-0639

LOT 14, BLOCK 8, LAKEWOOD TRAILS SUBDIVISION LOCATED IN THE NE 1/4 AND NW 1/4 OF THE NW 1/4 OF SECTION 1, T.1.N., R.16.E, VILLAGE OF WILLIAMS BAY, WALWORTH COUNTY, WISCONSIN.

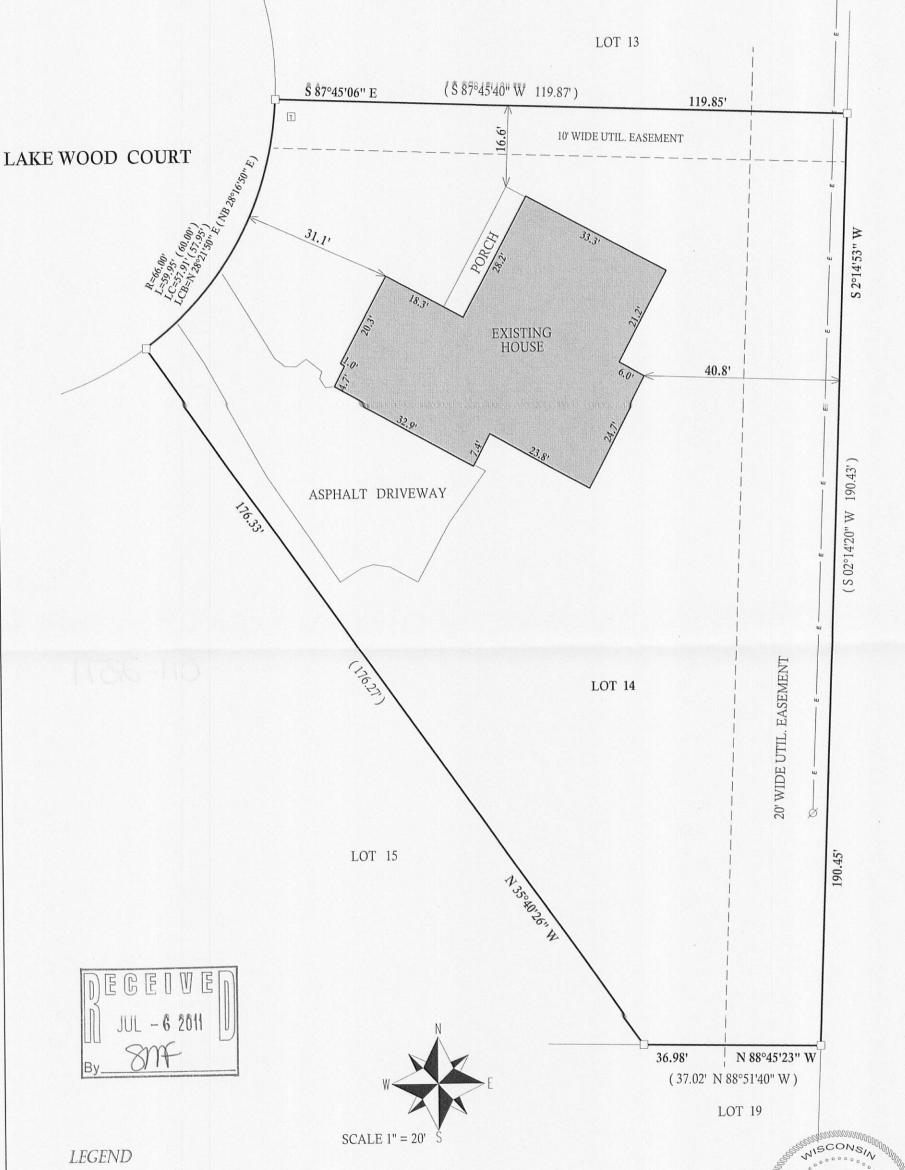

__€— OVER HEAD UTILITIES

Ø UTILITY POLE

TRANSFORMER

O FOUND IRON PIPE

☐ FOUND IRON BAR

■ SET IRON BAR

(XX) RECORDED AS

JOB # 11-091

TAX ID # WLAK 00128

BEARINGGS REFRENCED TO THE RECORD PLAT OF LAKEWOOD TRAILS

I have surveyed the above-described property and the above map is a true representation thereof and shows the size and location of the property, its exterior boundaries, the location and dimensions of all structures thereon, fences apparent easements and roadways and visible encroachments. if any.

This survey is made for the exclusive use of the present owners of the property, and also those who puchase, mortgage, or insure the title therto within one (1) year from date hereof; and as to them I warrant the accuracy of said survey map.



DATED THIS 14tH, DAY OF JUNE, 2011

JOHN KROTT S - 2258 Wisconsin Registered Land Surveyor (original if signed in red)

011-2371

-9911