

# Plat of Survey

of


## Lot 107 of Baywood Heights Addition No. 2,

a subdivision located in the Northwest 1/4 of Section 1, Town 1 North,  
Range 16 East, Village of Williams Bay, Walworth County, Wisconsin.



Surveyed for: **Keefe Real Estate, Inc.**  
P.O. Box 460  
Lake Geneva, Wisconsin. 53147

Survey Date: July 21, 2011.  
Revisions:

Scale in Feet  
1" = 20'  
0' 10' 20' 40'

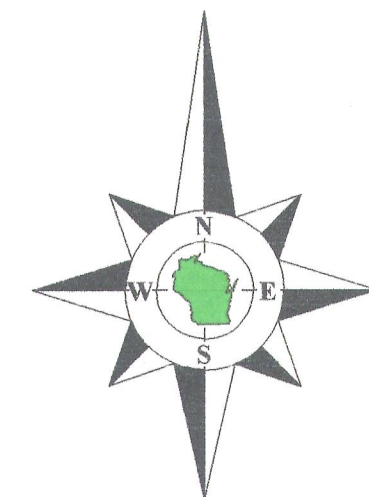

Bearings reference to the plat of  
Baywood Heights Addition No. 2.

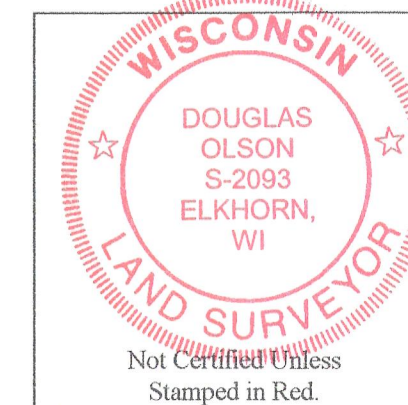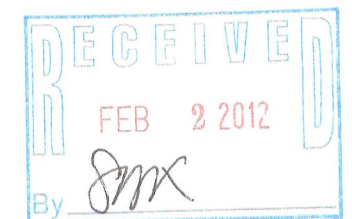

### Notes:

- 1) This survey plat is not certified unless signed and sealed in red ink.
- 2) This survey is subject to Wisconsin lien laws. This Plat of Survey is the notice of intent to file lien. Lien waiver required.

Copyright 2011 by Jensen & Olson Land Surveying, LLC.

All rights reserved. No part of this survey plat may be reproduced or transmitted in any form by any means - graphic, electronic, or mechanical, including photocopying, tracing, or information storage and retrieval systems - without permission in writing from Douglas G. Olson, Jensen & Olson Land Surveying, LLC.

I hereby certify that I have surveyed the above described property and the map hereon is correct to the best of my professional knowledge and belief and shows the size and location of the property, its exterior boundaries, the location and dimensions of all visible structures thereon, boundary fences, apparent easements and roadways and visible encroachments, if any.

This survey is made for the exclusive use of the present owners of the property, and also those who purchase, mortgage or guarantee title thereto, within one year from the date hereof.

Douglas G. Olson  
Wisconsin Registered Land Surveyor - 2093


**Jensen & Olson Land Surveying, LLC**

45 South Wisconsin Street \* P.O. Box 322 \* Elkhorn, Wisconsin. 53121  
Telephone: (262) 723-3434 \* Facsimile: (262) 723-8044  
Email: jensen.olson@elknet.net

**Legend**  
Found Iron Pipe  
Found Iron Rod  
Recorded Information  
Utility Box or Pedestal  
Water Valve  
Manhole  
Asphalt Surface  
Concrete Surface  
Pavers

Sheet 1 of 1 Sheets  
Drawing Name: 11116-201107-201107Plat.sj  
Job Reference Number  
2011.077

2011.077

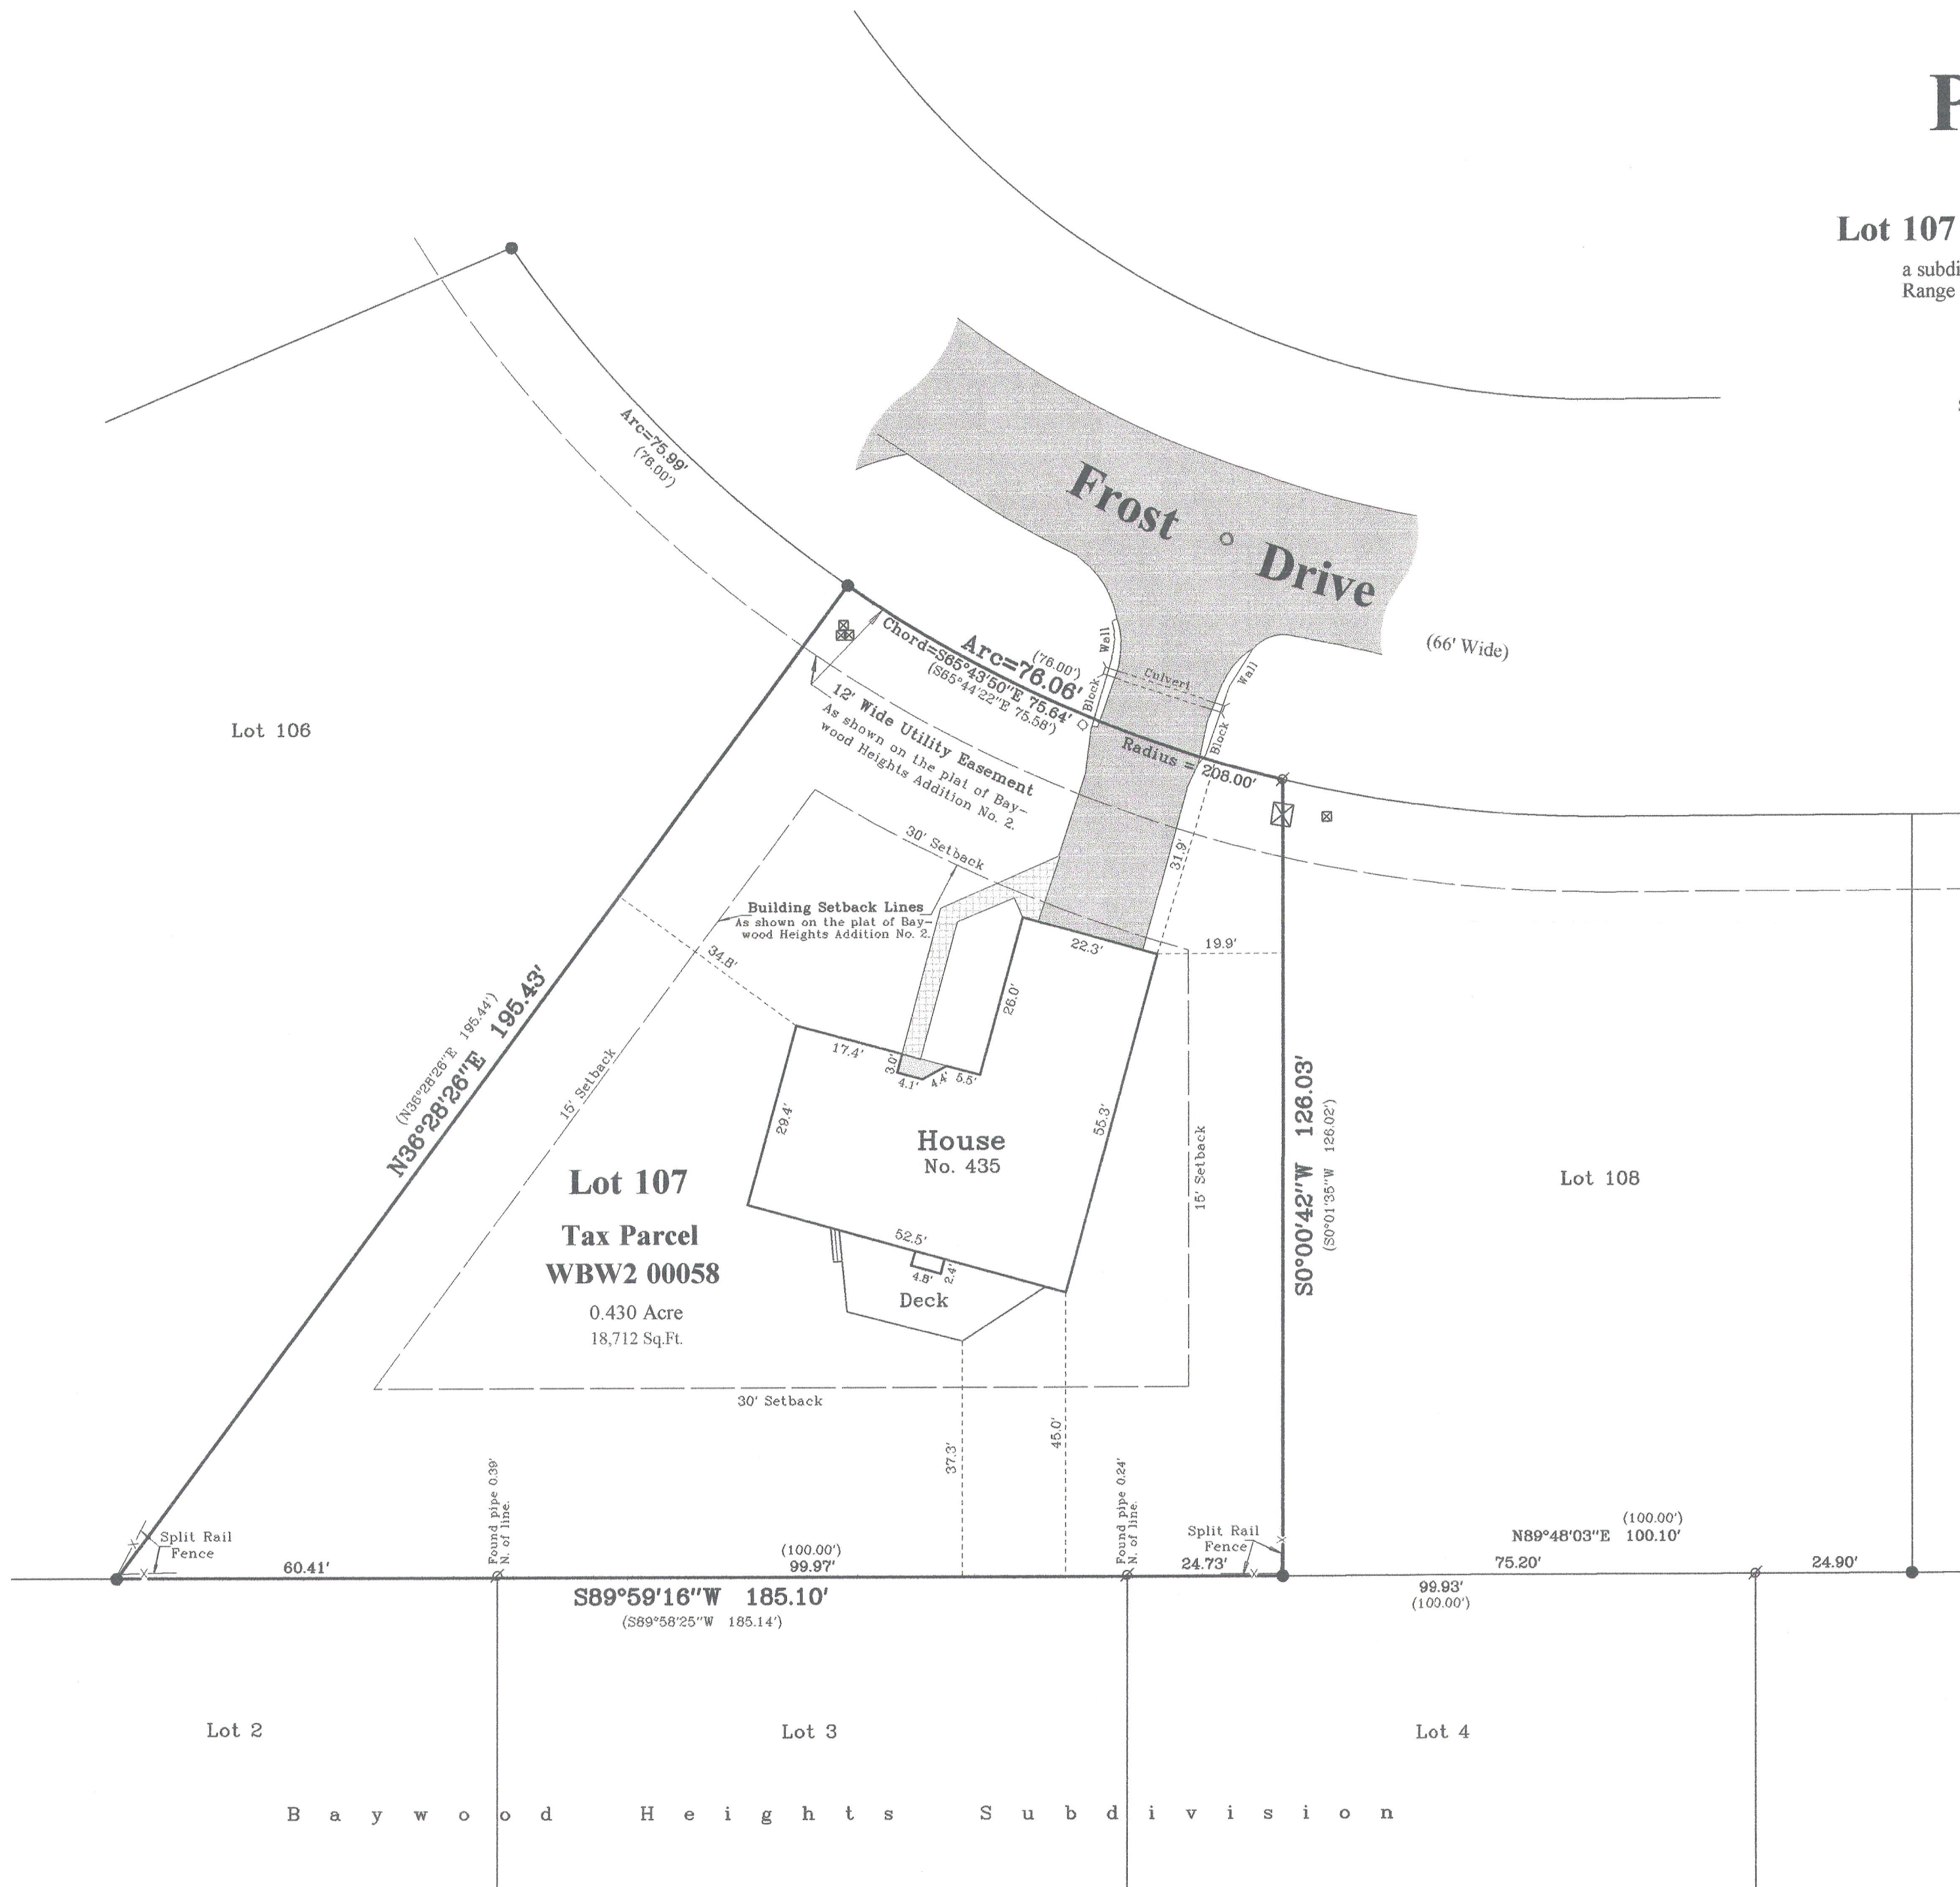

WBW2-58

011-2401