



FARRIS, HANSEN & ASSOCIATES, INC.
ENGINEERING - ARCHITECTURE - SURVEYING
7 RIDGWAY COURT P.O. BOX 437
ELKHORN, WISCONSIN 53121
OFFICE: (262) 723-2098 FAX: (262) 723-5886

REVISIONS

PROJECT NO.	8648
DATE	09-17-2012
SHEET NO.	1 OF 1

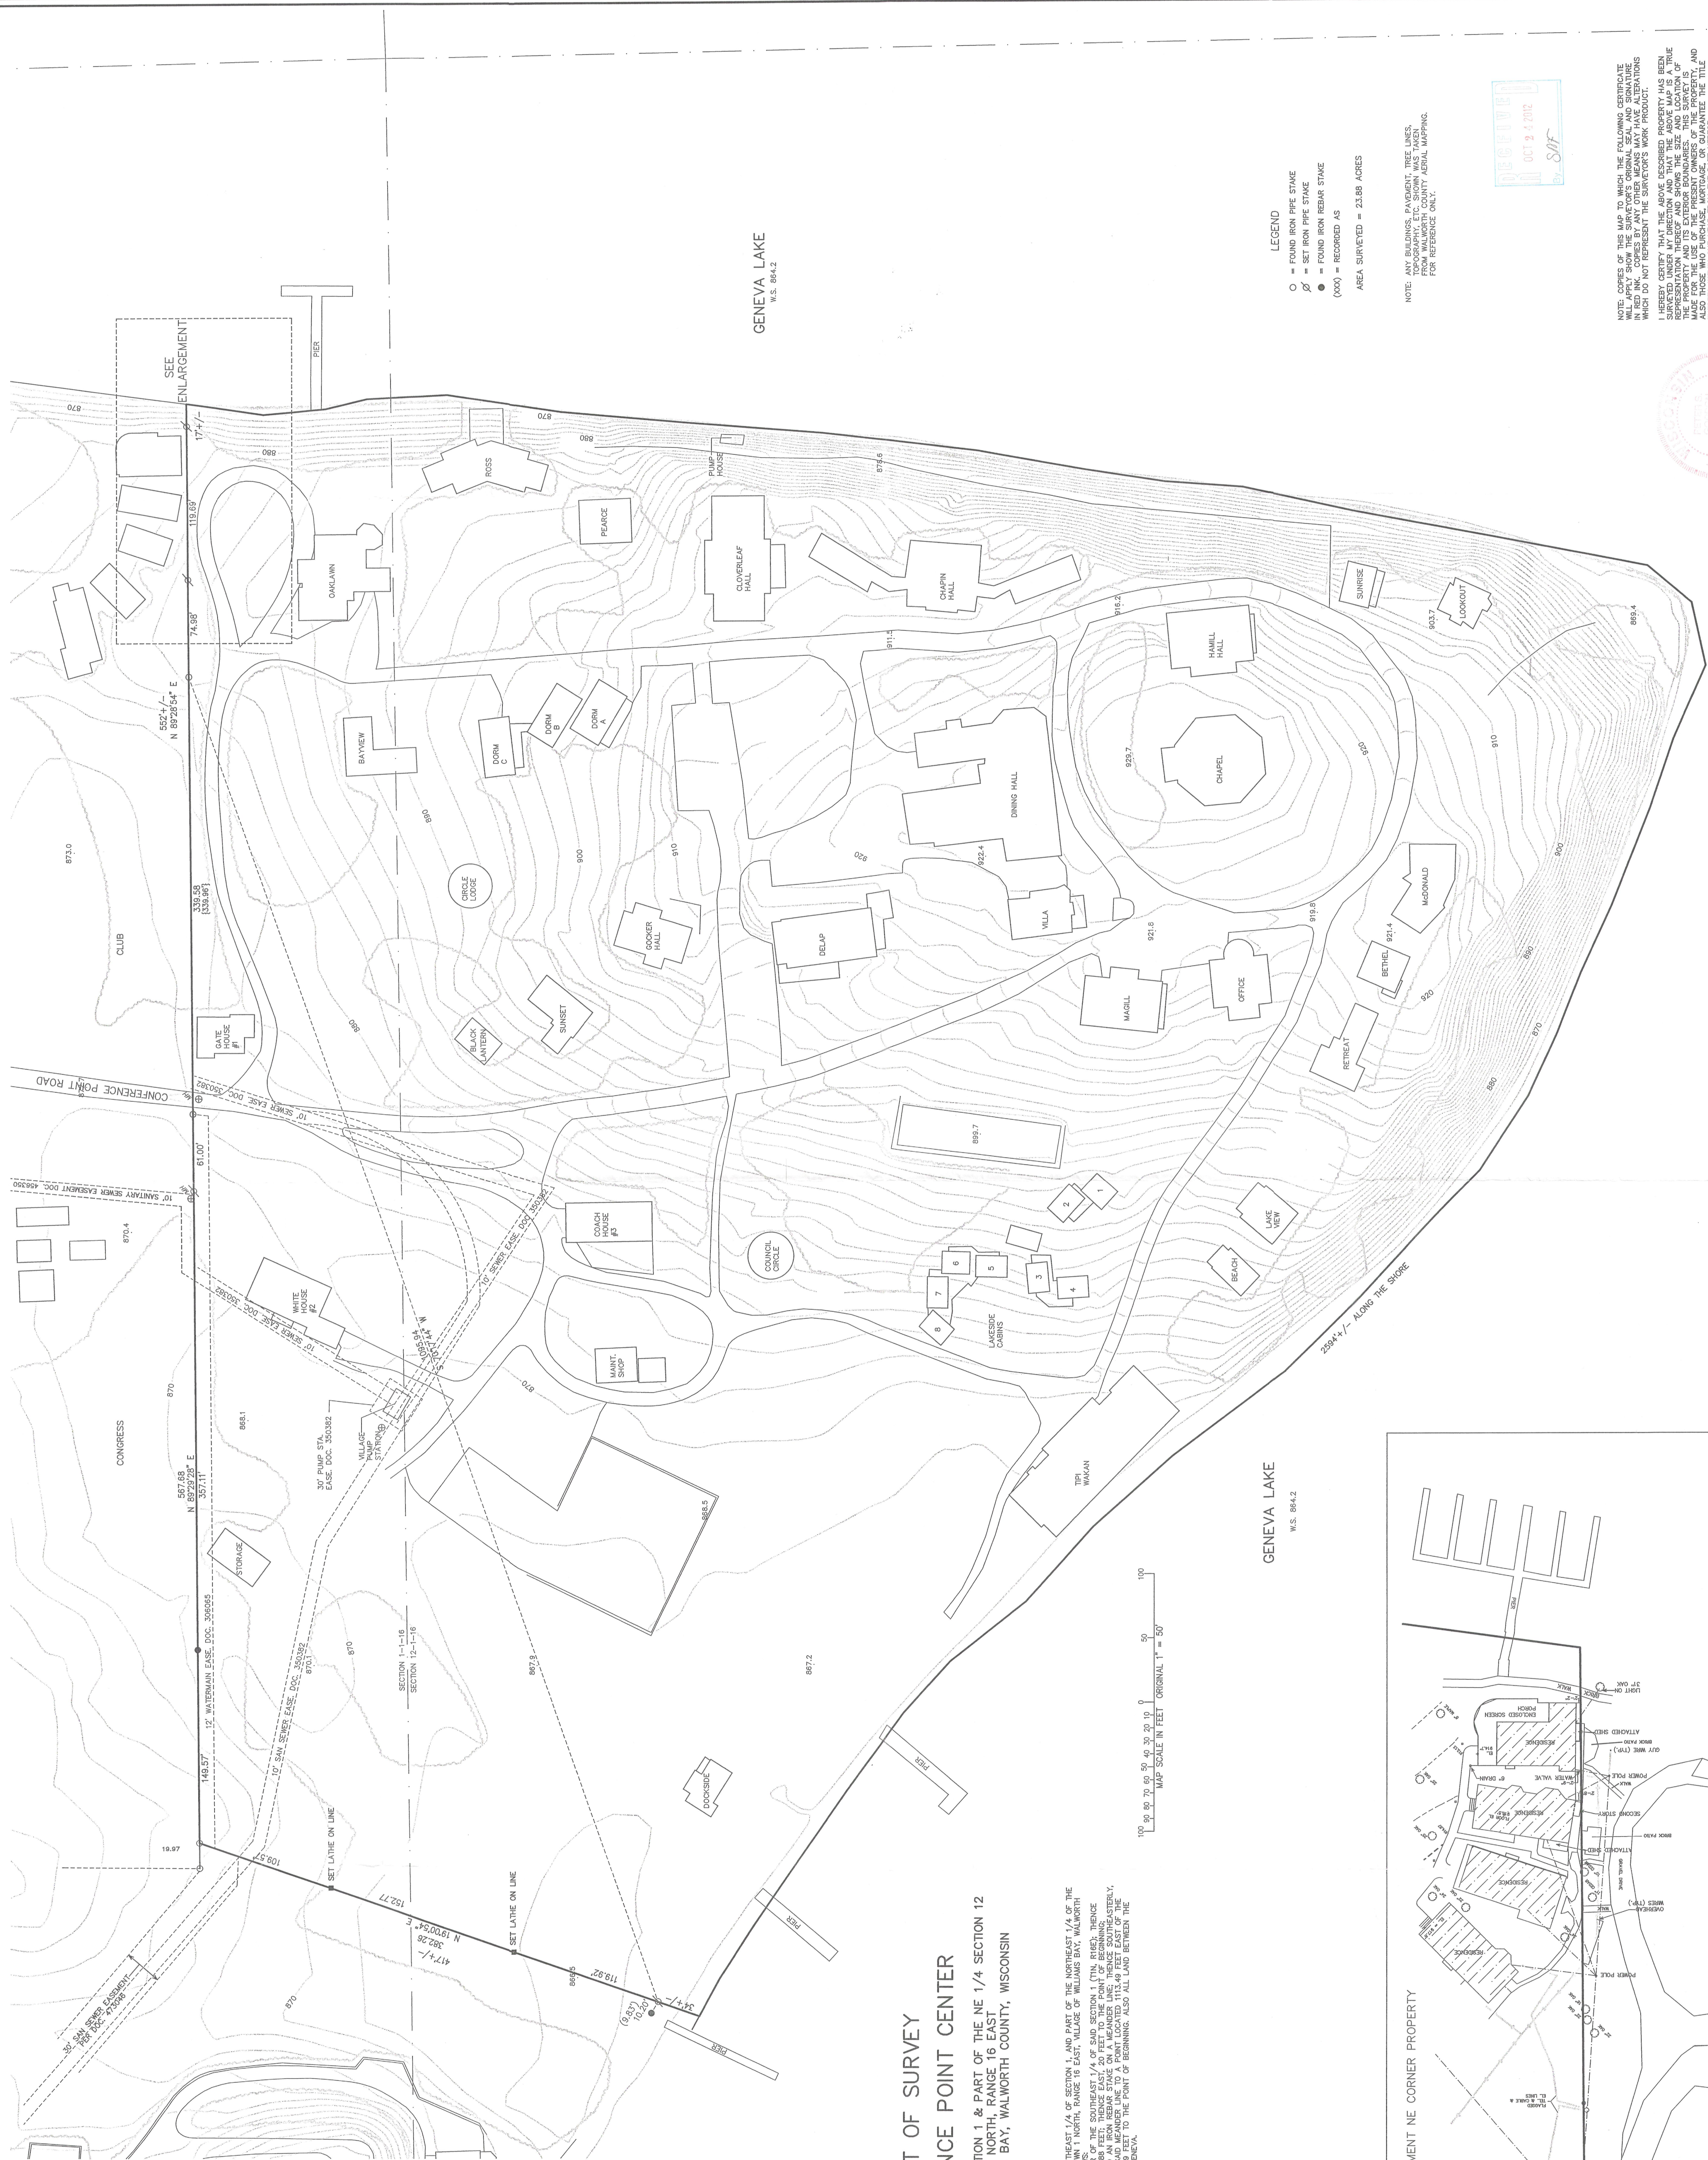

1"=30' ENLARGEMENT NE CORNER PROPERTY

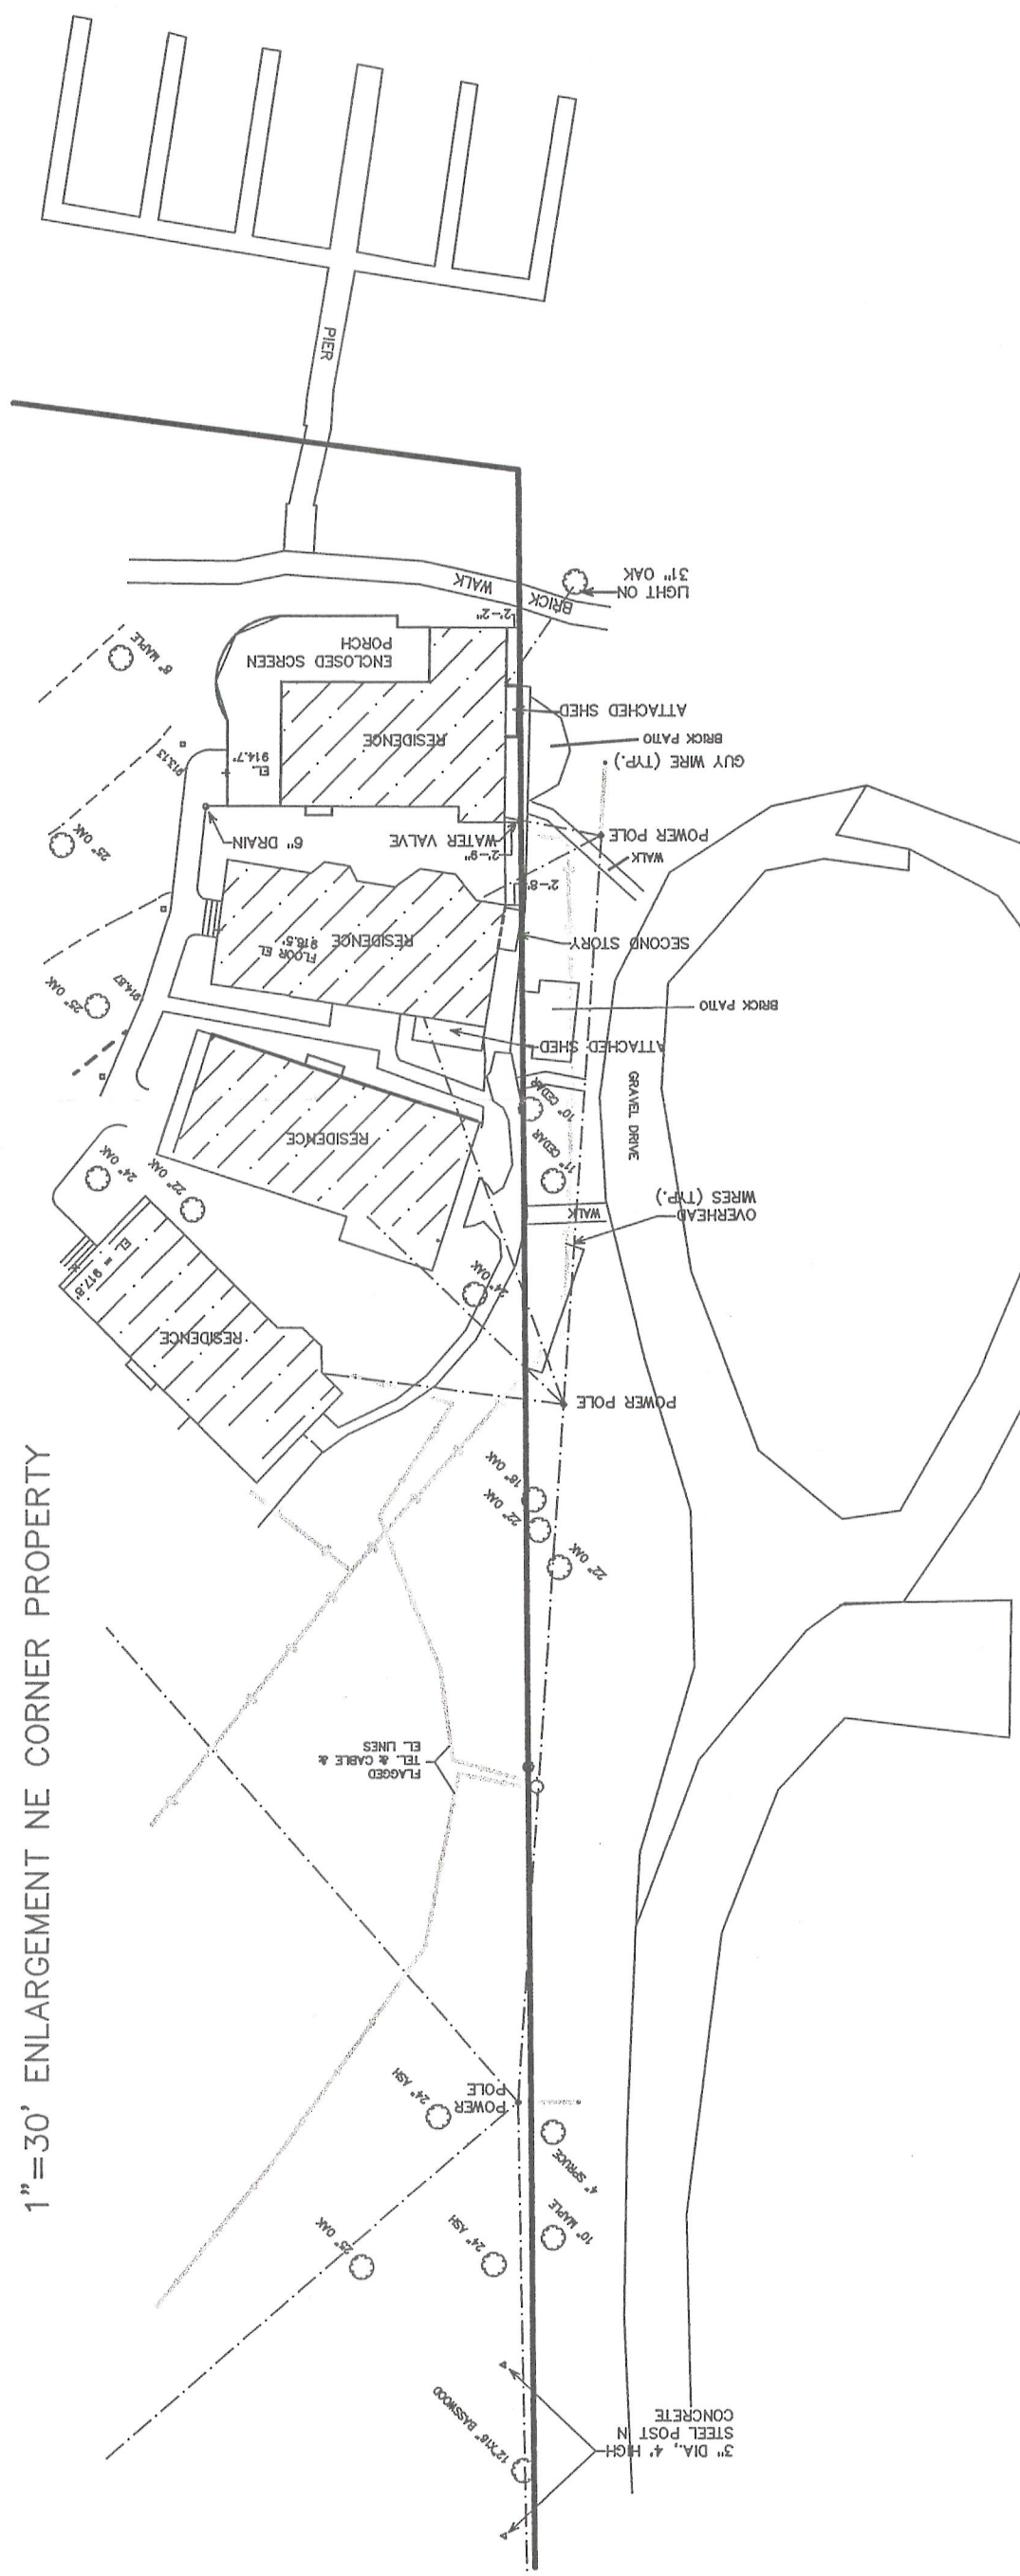

NOTE: COPIES OF THIS MAP TO WHICH THE FOLLOWING CERTIFICATE IS APPLIED SHALL APPLY SHOW THE SURVEYOR'S ORIGINAL SEAL AND SIGNATURE IN RED INK. COPIES BY ANY OTHER MEANS MAY HAVE ALTERATIONS WHICH DO NOT REPRESENT THE SURVEYOR'S WORK PRODUCT.

HEREBY CERTIFY THAT THE ABOVE DESCRIBED PROPERTY HAS BEEN SURVEYED UNDER MY DIRECTION AND THAT THE ABOVE MAP IS A TRUE REPRESENTATION THEREOF AND SHOWS THE SIZE AND LOCATION OF THE PROPERTY AND ITS EXTERIOR BOUNDARIES. THIS SURVEY IS MADE FOR THE PURPOSE OF THE GRANTING OF A MORTGAGE, LEASE, AND/OR OTHER INTEREST IN THE PROPERTY. I HAVE REVIEWED THE TITLE AND THE RECORDS WITHIN ONE YEAR FROM THE DATE HEREOF.

DATED: SEPTEMBER 17, 2012

PETER S. GORDON R.L.S. 2101

WUP-78

155-10