



DOROTHY HIGGINS GERBER  
SHOREWEST REALTORS  
623 MAIN ST.  
LAKE GENEVA, WI 53147

PLAT OF SURVEY

-OF-

KROTT SURVEYING INC.  
N3705 WILLOW BEND LANE  
LAKE GENEVA WI. 53147  
PHONE # (262)248-3697  
FAX # (262)249-0639

LOT 131 AND THE EAST 1/2 OF LOT 132 OF THE SECOND  
ADDITION TO CEDAR POINT PARK, BEING A SUBDIVISION  
LOCATED IN THE VILLAGE OF WILLIAMS BAY, WALWORTH  
COUNTY, WISCONSIN, ACCORDING TO A PLAT THEREOF OF  
RECORD.

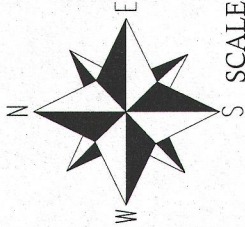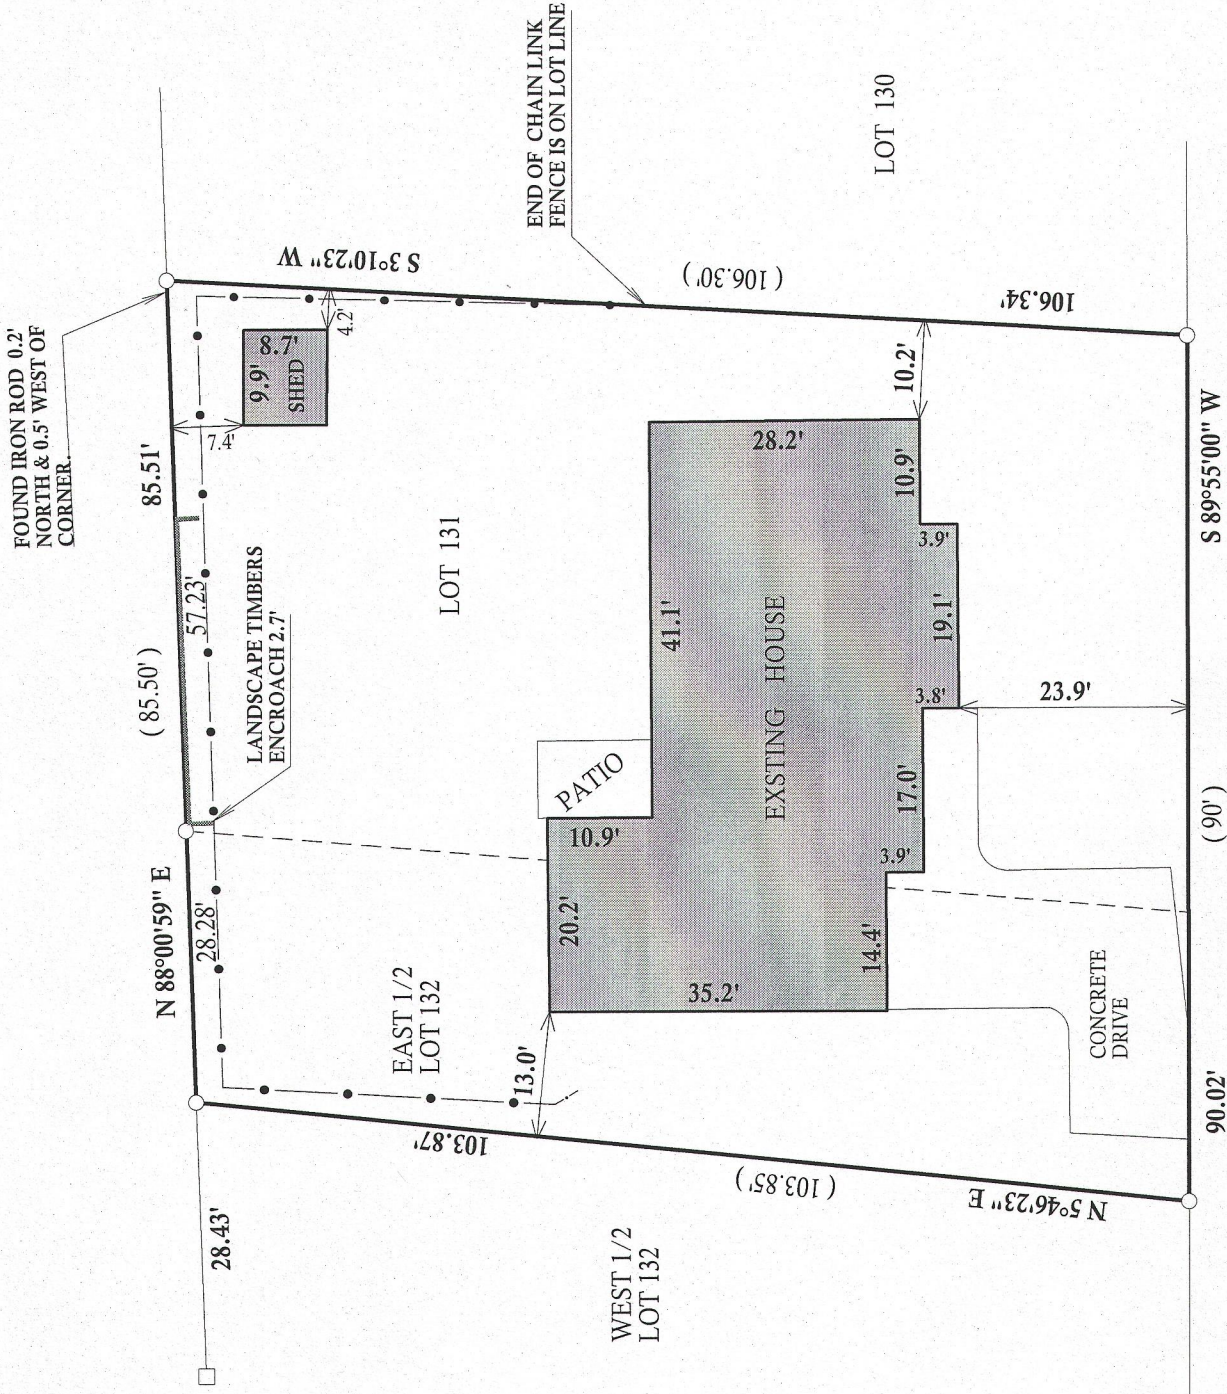

SCALE 1" = 20'

LEGEND


- FOUND IRON PIPE
- (xx) RECORDED AS
- FENCE

I have surveyed the above-described property and the above map is a true representation thereof and shows the size and location of the property, its exterior boundaries, the location and dimensions of all structures thereon, fences apparent easements and roadways and visible encroachments, if any.

This survey is made for the exclusive use of the present owners of the property, and also those who purchase, mortgage, or insure the title thereto within one (1) year from date hereof; and as to them I warrant the accuracy of said survey map.

JOB # 13-057 TAX ID # WCP200029&31

JOHN KROTT S - 2258  
Wisconsin Registered Land Surveyor  
(original if signed in red)

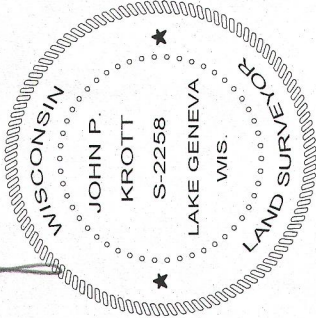

DATED THIS 27th, DAY OF APRIL, 2013

011-2469