


PREPARED FOR
RICK VAN EGEREN
304 S. BELMONT
ARLINGTON HEIGHTS IL 60005

PLAT OF SURVEY OF

LOT 194 ORIGINAL CEDAR POINT PARK SUBDIVISION, BEING
A SUBDIVISION IN THE VILLAGE OF WILLIAMS BAY, WALWORTH
COUNTY, WISCONSIN.


KROTT SURVEYING INC.
(262) 248-3697
N 3705 WILLOW BEND LANE
LAKE GENEVA WI 53147

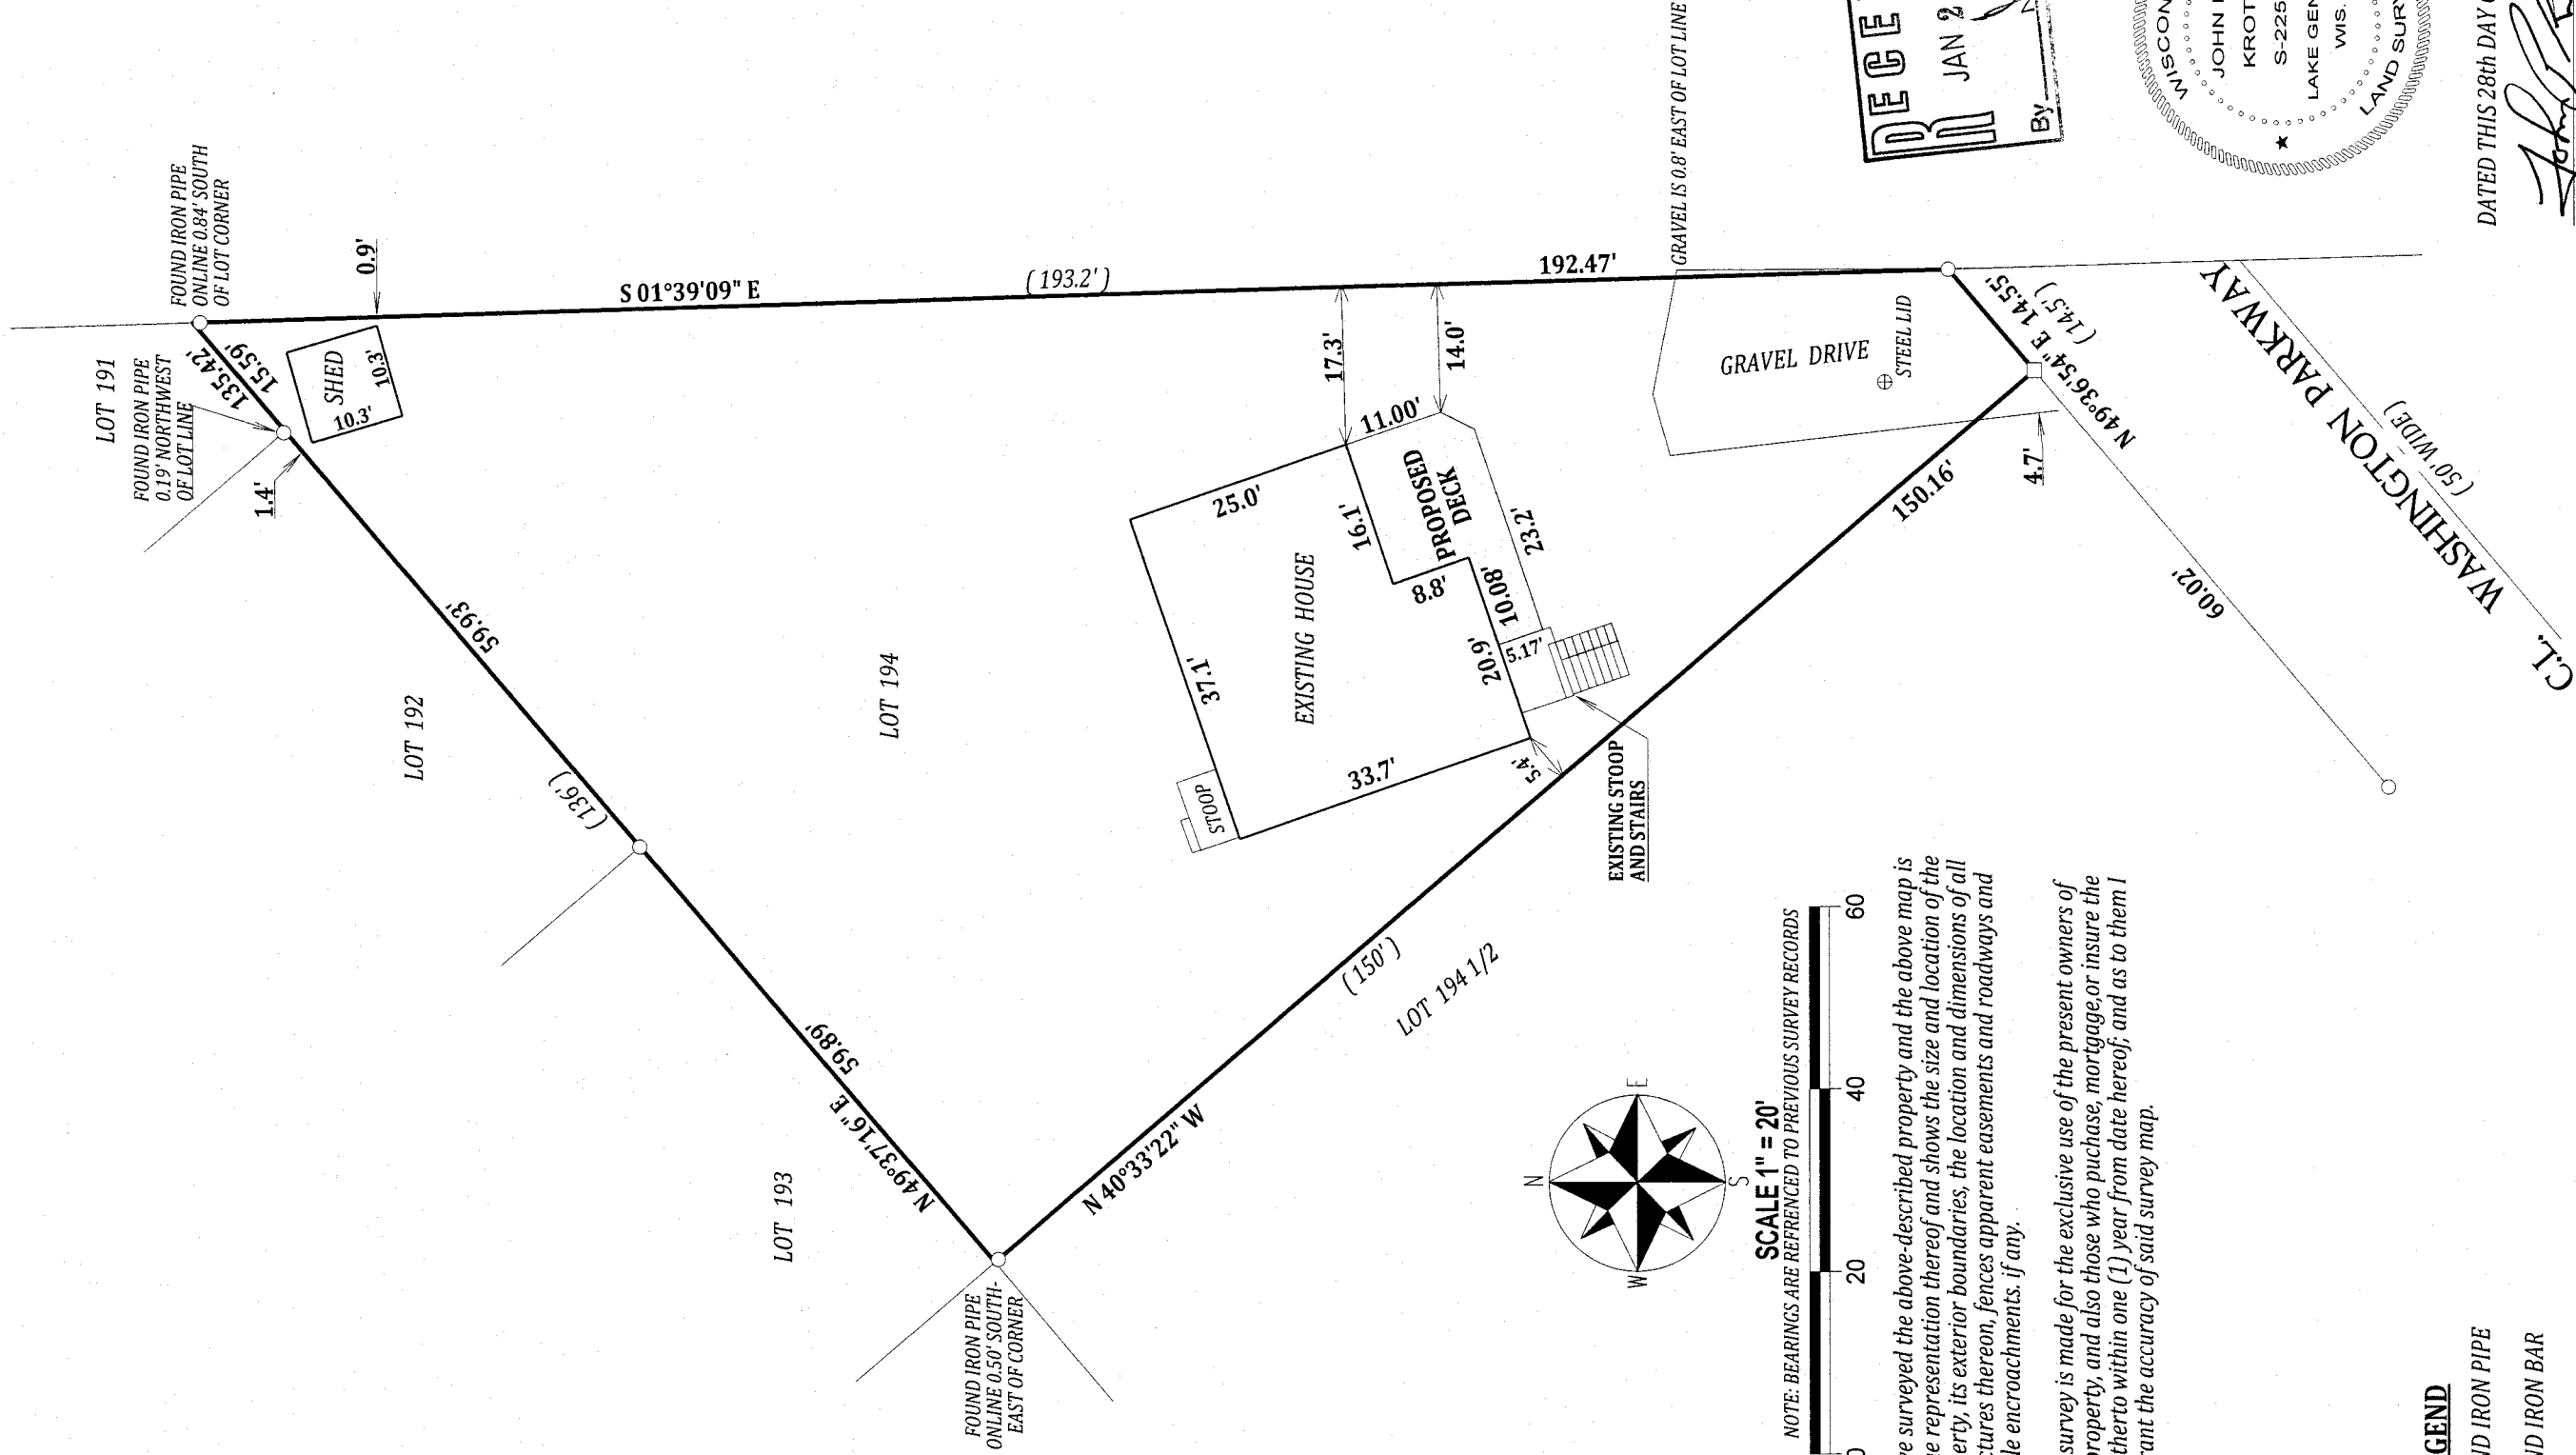

I have surveyed the above-described property and the above map is a true representation thereof and shows the size and location of the property, its exterior boundaries, the location and dimensions of all structures thereon, fences apparent easements and roadways and visible encroachments, if any.

This survey is made for the exclusive use of the present owners of the property, and also those who purchase, mortgage, or insure the title thereto within one (1) year from date hereof, and as to them I warrant the accuracy of said survey map.

RECEIVED
JAN 21 2014
BY

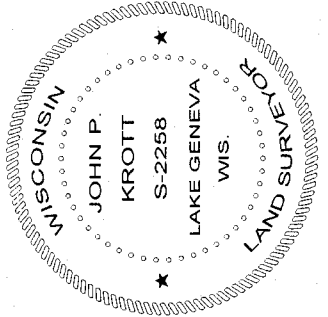

DATED THIS 28th DAY OF OCTOBER 2013

JOHN P. KROTT S-2258
WISCONSIN REGISTERED LAND SURVEYOR
(NOTE: THIS IS NOT A CERTIFIED COPY
UNLESS SIGNED IN RED INK)

wcp-168 011-2516