



PREPARED FOR
MARTHA CUCCO
KEEFE REAL ESTATE
751 GENEVA PARKWAY
LAKE GENEVA WI 53147

PLAT OF SURVEY OF

LOT 1, OF THE PLAT OF THE FIRST ADDITION TO CEDAR POINT PARK, IN THE
VILLAGE OF WILLIAMS BAY, COUNTY OF WALWORTH, STATE OF WISCONSIN.

KROTT SURVEYING INC.
(262) 248-3697
N 3705 WILLOW BEND LANE
LAKE GENEVA WI 53147

OAK GROVE
PARK

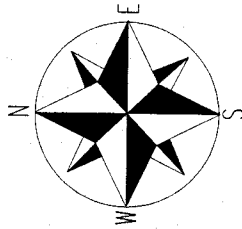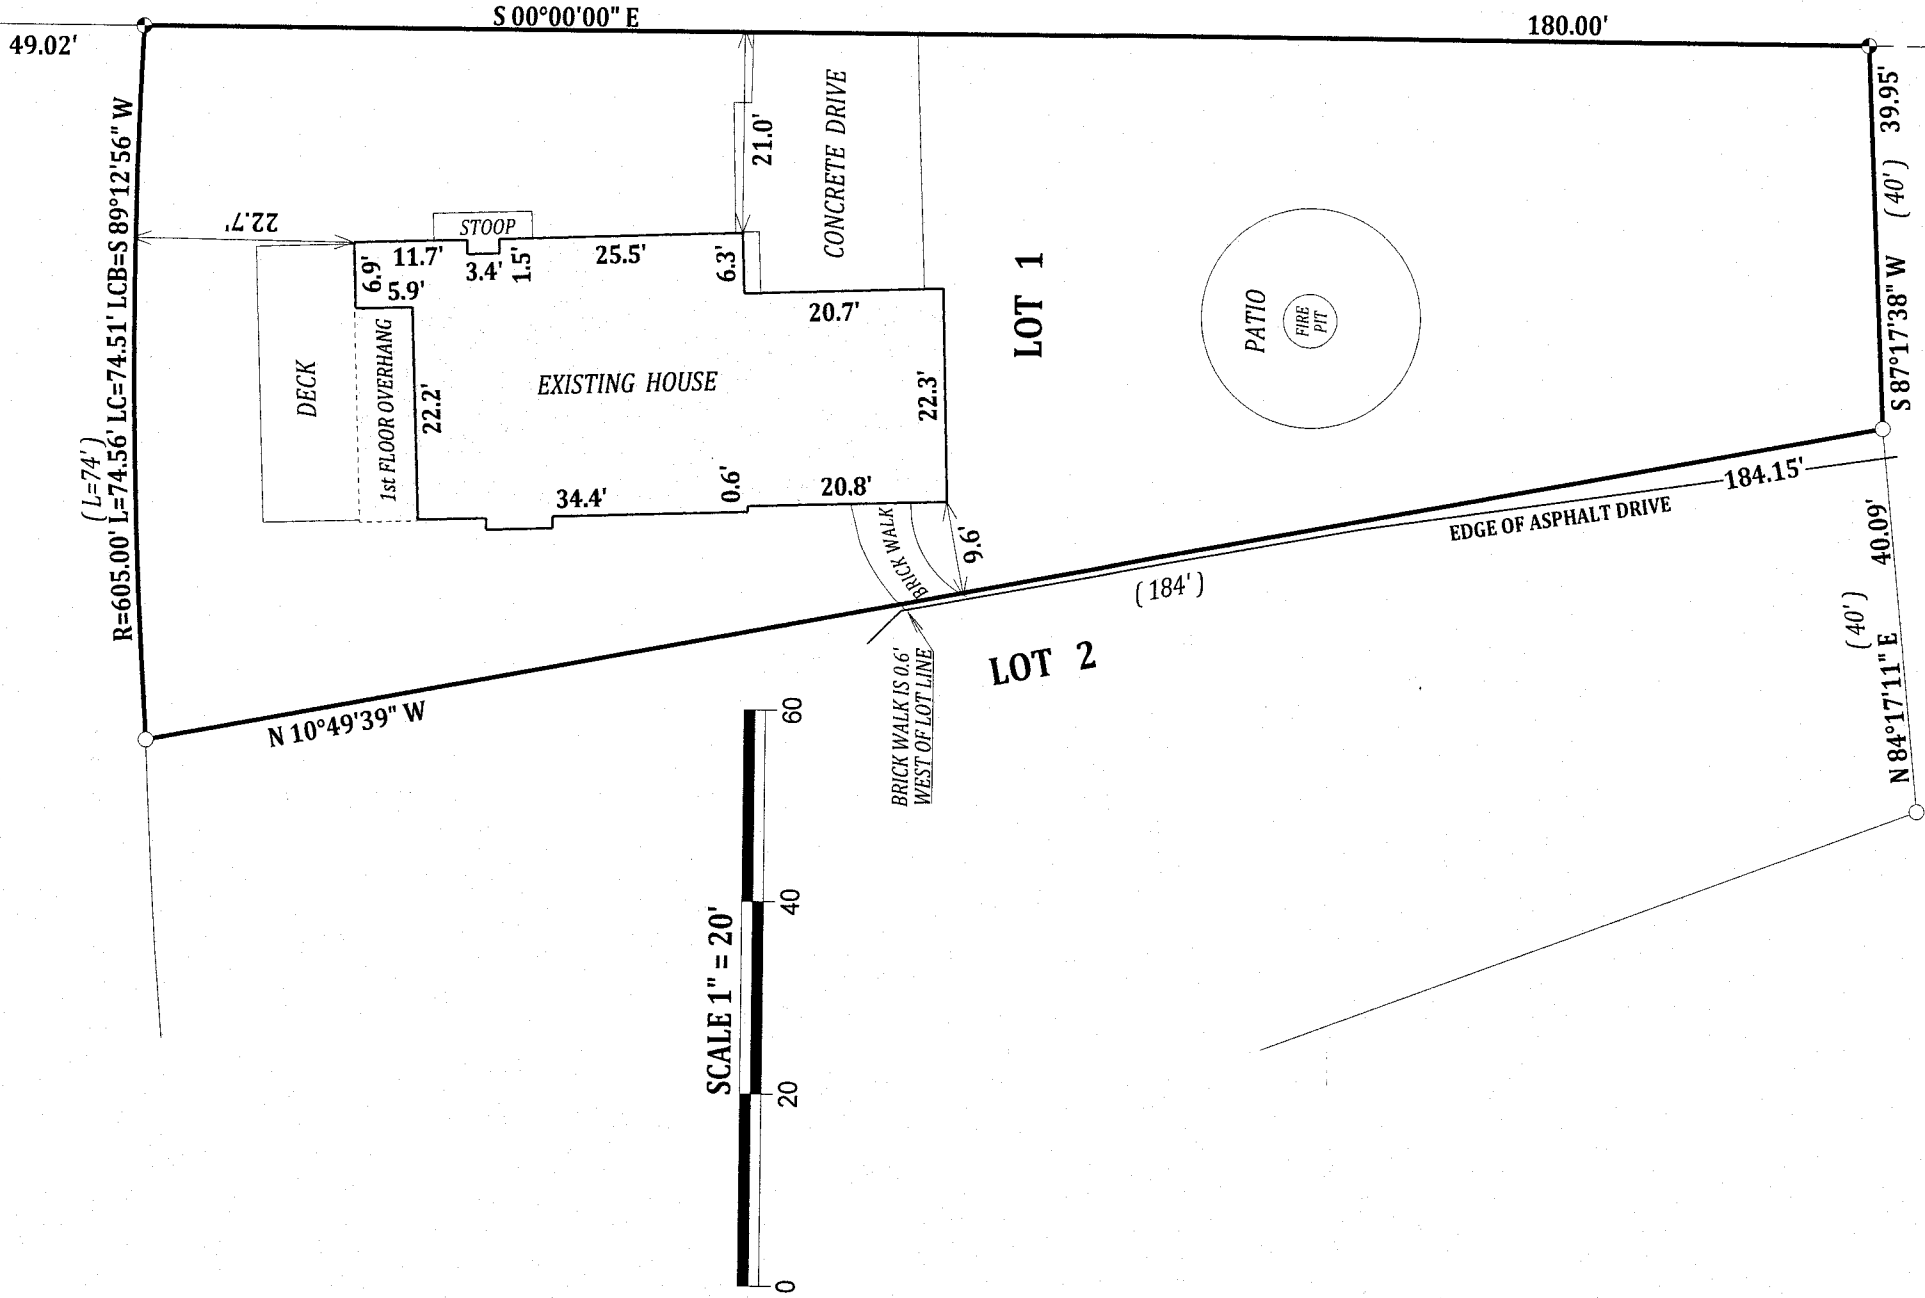

NOTE: BEARINGS ARE REFERENCED TO THE RECORD PLAT.

LEGEND

- FOUND IRON PIPE
- FOUND CONCRETE MONUMENT
- (XX) RECORDED AS

TAX ID # WCP100001



JOB # 13-173

LOT 19

I have surveyed the above-described property and the above map is a true representation thereof and shows the size and location of the property, its exterior boundaries, the location and dimensions of all structures thereon, fences apparent easements and roadways and visible encroachments, if any.

This survey is made for the exclusive use of the present owners of the property, and also those who purchase, mortgage, or insure the title thereto within one (1) year from date hereof; and as to them I warrant the accuracy of said survey map.

C.L. CEDAR POINT DRIVE
(50' WIDE)

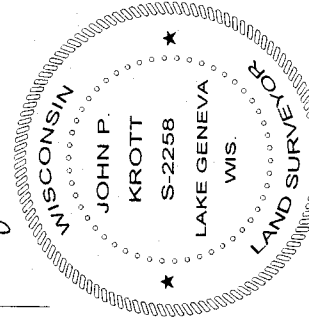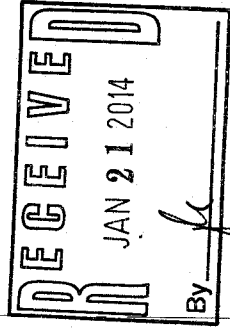

DATED THIS 15th DAY OF NOVEMBER 2013

John P. Krott

JOHN P. KROTT S-2258
WISCONSIN REGISTERED LAND SURVEYOR
(NOTE: THIS IS NOT A CERTIFIED COPY
UNLESS SIGNED IN RED INK)