


PREPARED FOR
JEREMY OWEN
702 S. MADISON ST.
HINSDALE IL. 60521

KROTT SURVEYING INC.
(262) 248-3697
N 3705 WILLOW BEND LANE
LAKE GENEVA WI. 53147

PLAT OF SURVEY OF

LOTS 70 AND 71 OF CEDAR POINT PARK
IN THE VILLAGE OF WILLIAMS
BAY, WALWORTH COUNTY, WISCONSIN.

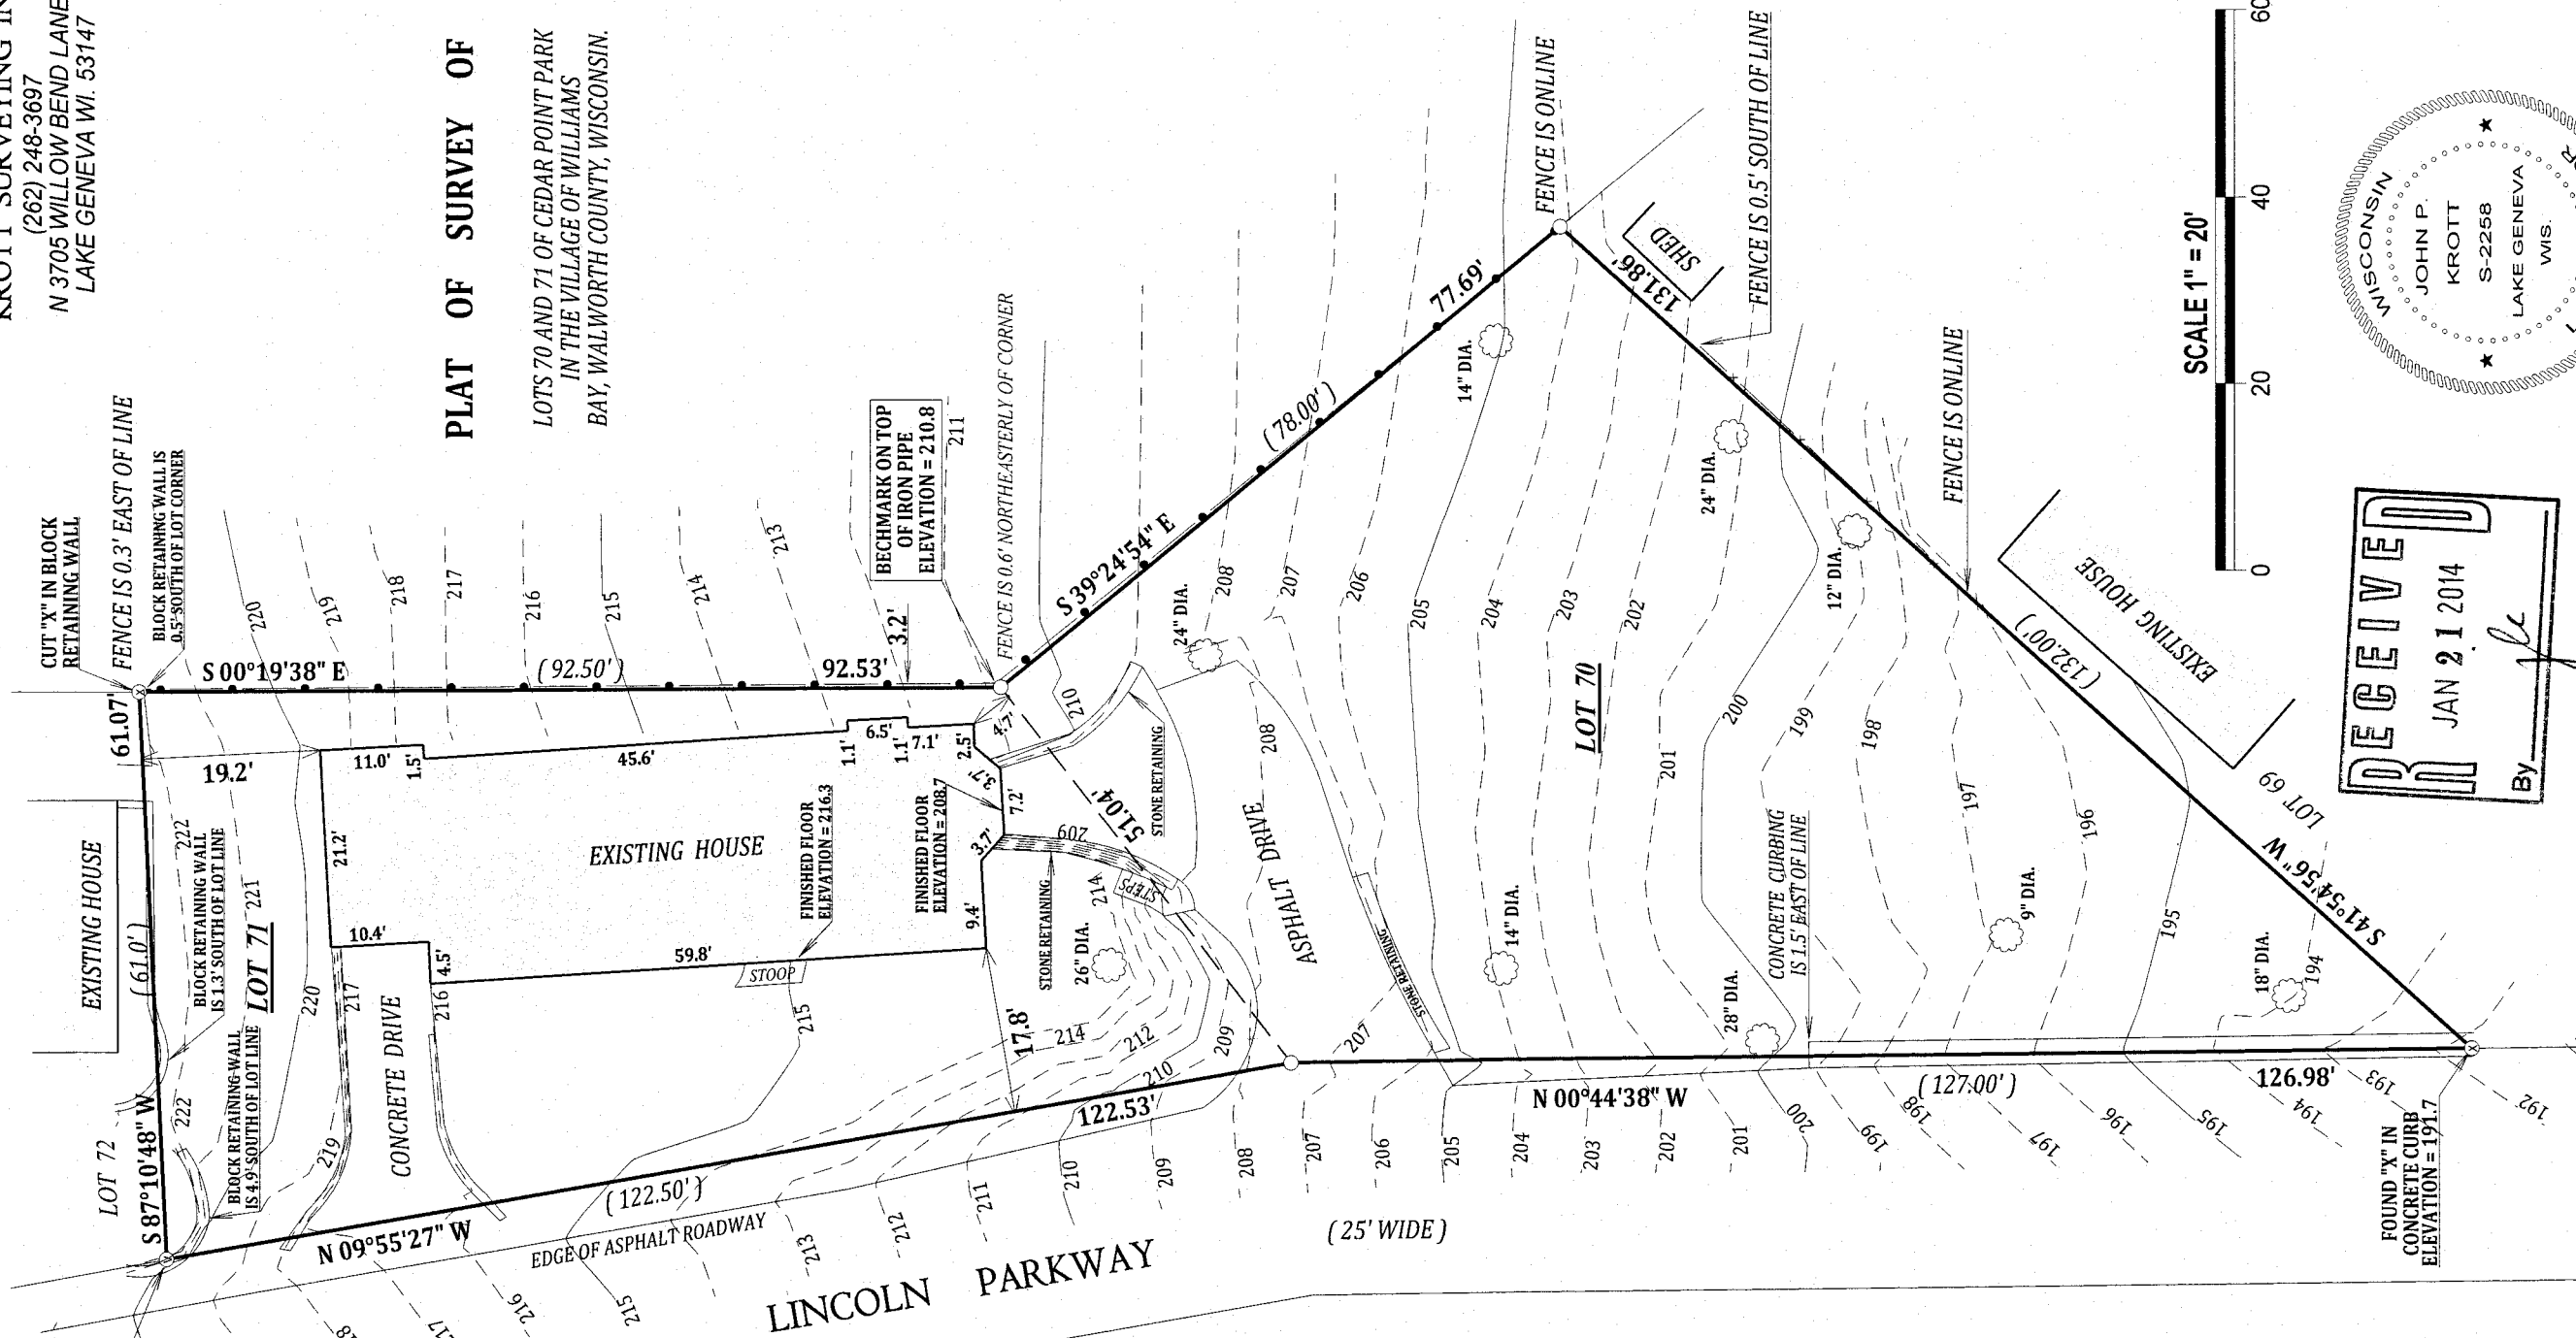

LEGEND

- FOUND IRON PIPE
- DECIDUOUS TREE
- CHAINLINK FENCE
- WIRE FENCE
- (XX) RECORDED AS

TAX ID # WCP00055

JOB # 06-536TP



I have surveyed the above-described property and the above map is a true representation thereof and shows the size and location of the property, its exterior boundaries, the location and dimensions of all structures thereon, fences apparent easements and roadways and visible encroachments, if any.

This survey is made for the exclusive use of the present owners of the property, and also those who purchase, mortgage, or insure the title thereto within one (1) year from date hereof; and as to them I warrant the accuracy of said survey map.

DATED THIS 11th DAY OF DECEMBER 2013

John P. Krott

JOHN P. KROTT S-2258
WISCONSIN REGISTERED LAND SURVEYOR
(NOTE: THIS IS NOT A CERTIFIED COPY
UNLESS SIGNED IN RED INK)

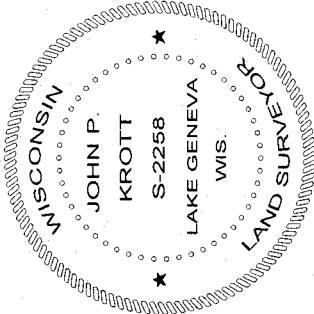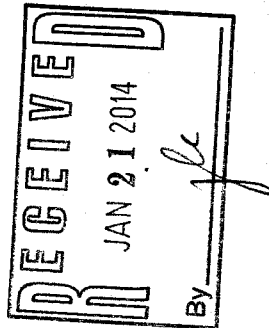

SCALE 1" = 20'

WCP-55

011-2519