



PREPARED FOR:
LINDA TONGE
KEEFE REAL ESTATE
LAKE GENEVA, WI

PLAT OF SURVEY

-OF-

PATHFINDER SURVEYING INC.
(formerly)
J.K. SURVEYING INC.
P.O BOX 322
LAKE GENEVA, WI. 53147
WWW.PATHFINDERSURVEYING.NET
262-248-8303

LOT 6, BLOCK 6 OF THE ORIGINAL PLAT OF THE VILLAGE OF WILLIAMS
BAY, ACCORDING TO THE RECORD PLAT IN VOLUME 4 OF PLATS,
ON PAGE 31.

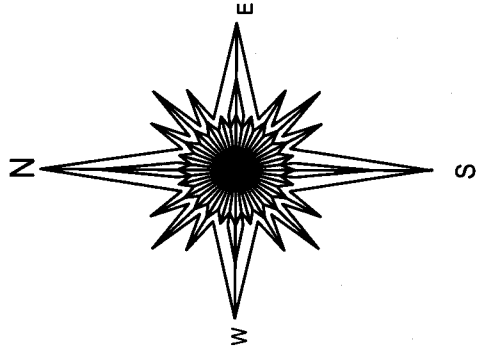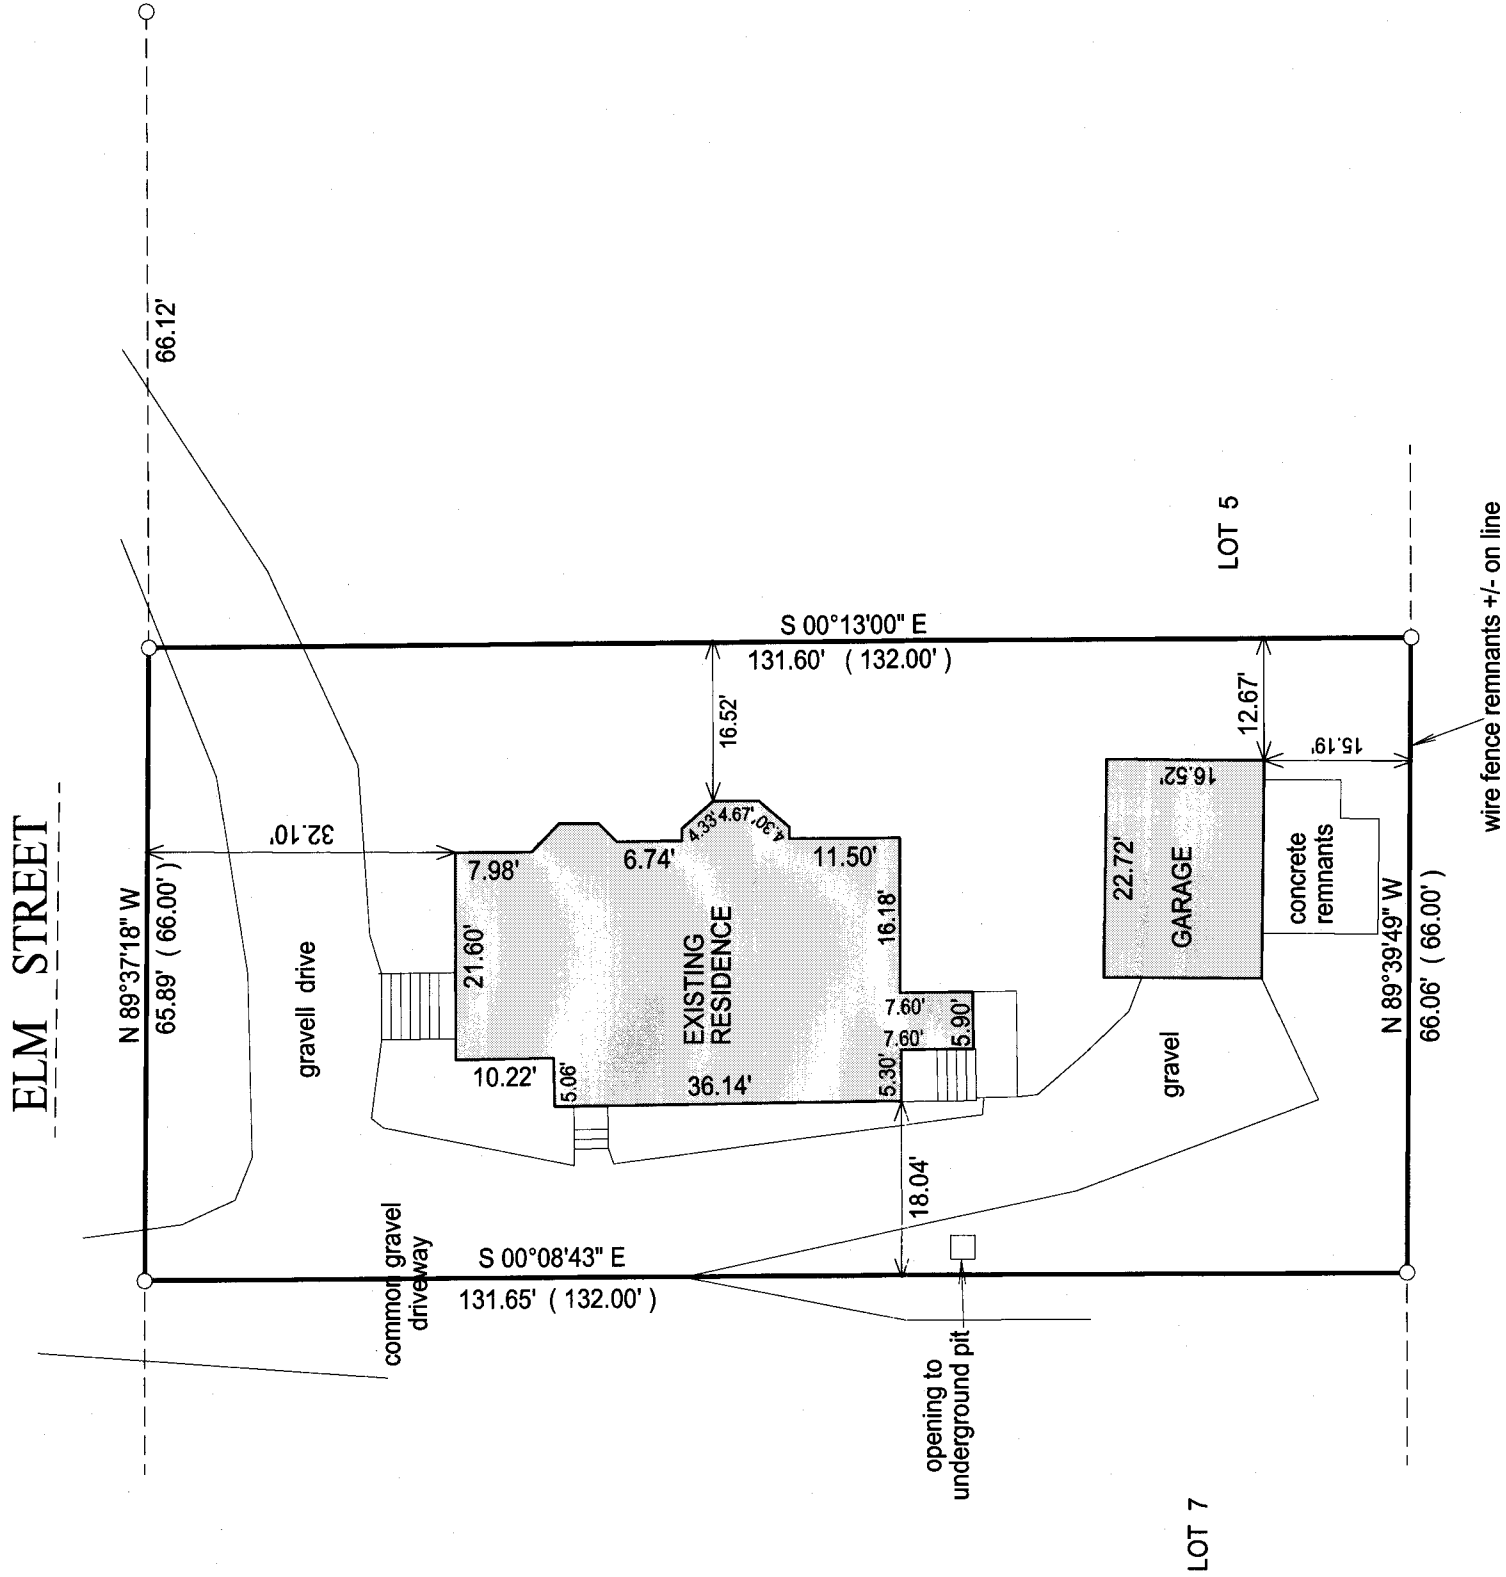


- () = RECORDED AS
- = FOUND IRON BAR
 - = FOUND IRON PIPE
 - = SET IRON PIPE
 - = SET IRON BAR

SCALE: 1" = 20'



JOB #: 14-54

TAX ID #: WOP00076A

BASIS OF BEARING OF THIS PLAT: THE SOUTH LINE OF ELM STREET
WAS ASSUMED TO BEAR N 89°37'18" W.

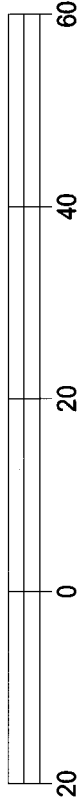

"I hereby certify that the above described property was surveyed under my supervision and that the above map, to the best of my knowledge and belief, is a true representation thereof and shows the size and location of all visible structures, apparent easements and encroachments if any."
This survey is made for the present owners of the property, and those who purchase, mortgage, or guarantee the title thereto, within one year from the date hereof.

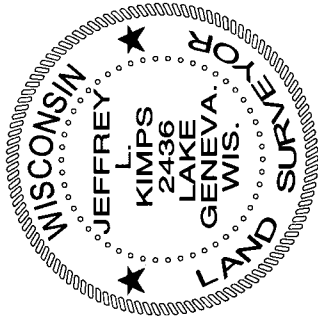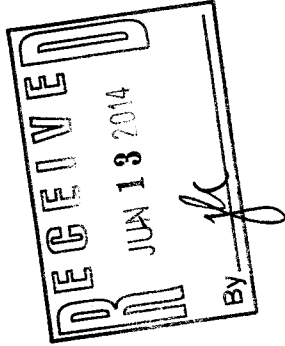

JEFFREY L. KIMPS, S-2436
Wisconsin Registered Land Surveyor
(original if signed in red)

DATED THIS 15TH DAY OF APRIL, 2014.

WOP-76A 011-2527