
PREPARED FOR **CHRISTINE FOX** SHOREWEST REALTY 830 E GENEVA ST DELAVAN, WI 53115

PLAT OF SURVEY

- OF -

PATHFINDER SURVEYING INC. (formerly) J.K. SURVEYING INC. P.O BOX 322 LAKE GENEVA, WI. 53147 WWW.PATHFINDERSURVEYING.NET 262-248-8303

LOT 17, BLOCK 8 OF LAKEWOOD TRAILS SUBDIVISION, LOCATED IN THE NE 1/4 AND NW 1/4 OF THE NW 1/4 OF SECTION 1, TOWN 1 NORTH, RANGE 16 EAST, VILLAGE OF WILLIAMS BAY, COUNTY OF WALWORTH AND STATE ODF WISCONSIN.

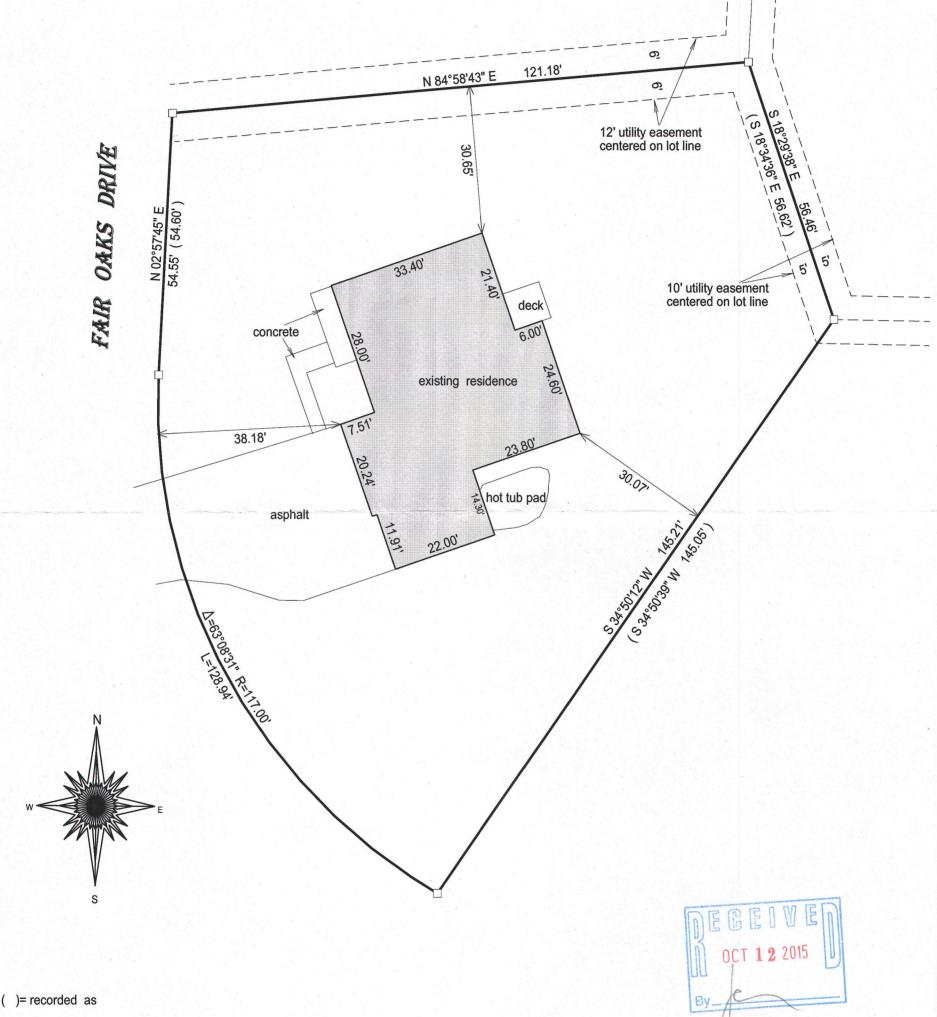

= found iron bar

= found iron pipe


= set iron pipe

= set iron bar

SCALE 1" = 20'

JOB # 15-228

TAX ID # WLAK 131

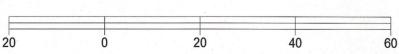


BASIS OF BEARING OF THIS PLAT: THE SUBDIVISION PLAT OF RECORD.

I hereby certify that I have surveyed the above- described property and the above map is a is a true representation thereof and shows the size and location of the property, its exterior boundaries, the location and dimensions of all structures thereon, fences, apparant easements and roadways and visible encroachments if any.

This survey is made for the present owners of the property, and those who purchase, mortgage, or guarantee the title thereto, within one year from the date hereof.

DATED THIS 15TH DAY OF JULY, 2015.

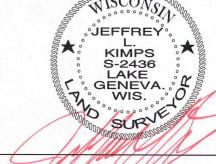

JEFFREY L KIMPS S - 2436 Wisconsin Professional Land Surveyor (original if signed in red)