


**Wisconsin Professional Land Surveyor S-2582**

**N9330 Knuteson Drive  
Whitewater, WI 53190  
Phone: (262) 495-3284  
MARKMIRITZ@  
LAND-MARKSURVEYING.COM**

**LOT 11 IN BLOCK 6 IN LAKEWOOD TRAILS SUBDIVISION,  
LOCATED IN THE NORTHEAST 1/4 AND NORTHWEST 1/4  
OF THE NORTHWEST 1/4 OF SECTION 1, IN TOWNSHIP 1  
NORTH, RANGE 16 EAST, IN THE VILLAGE OF WILLIAMS  
BAY, COUNTY OF WALWORTH, STATE OF WISCONSIN.**

**ORDERED BY: STACEY SCHULTZ  
KEEFE REAL ESTATE  
751 GENEVA PARKWAY  
LAKE GENEVA, WI 53147**

**(66' WIDE)**

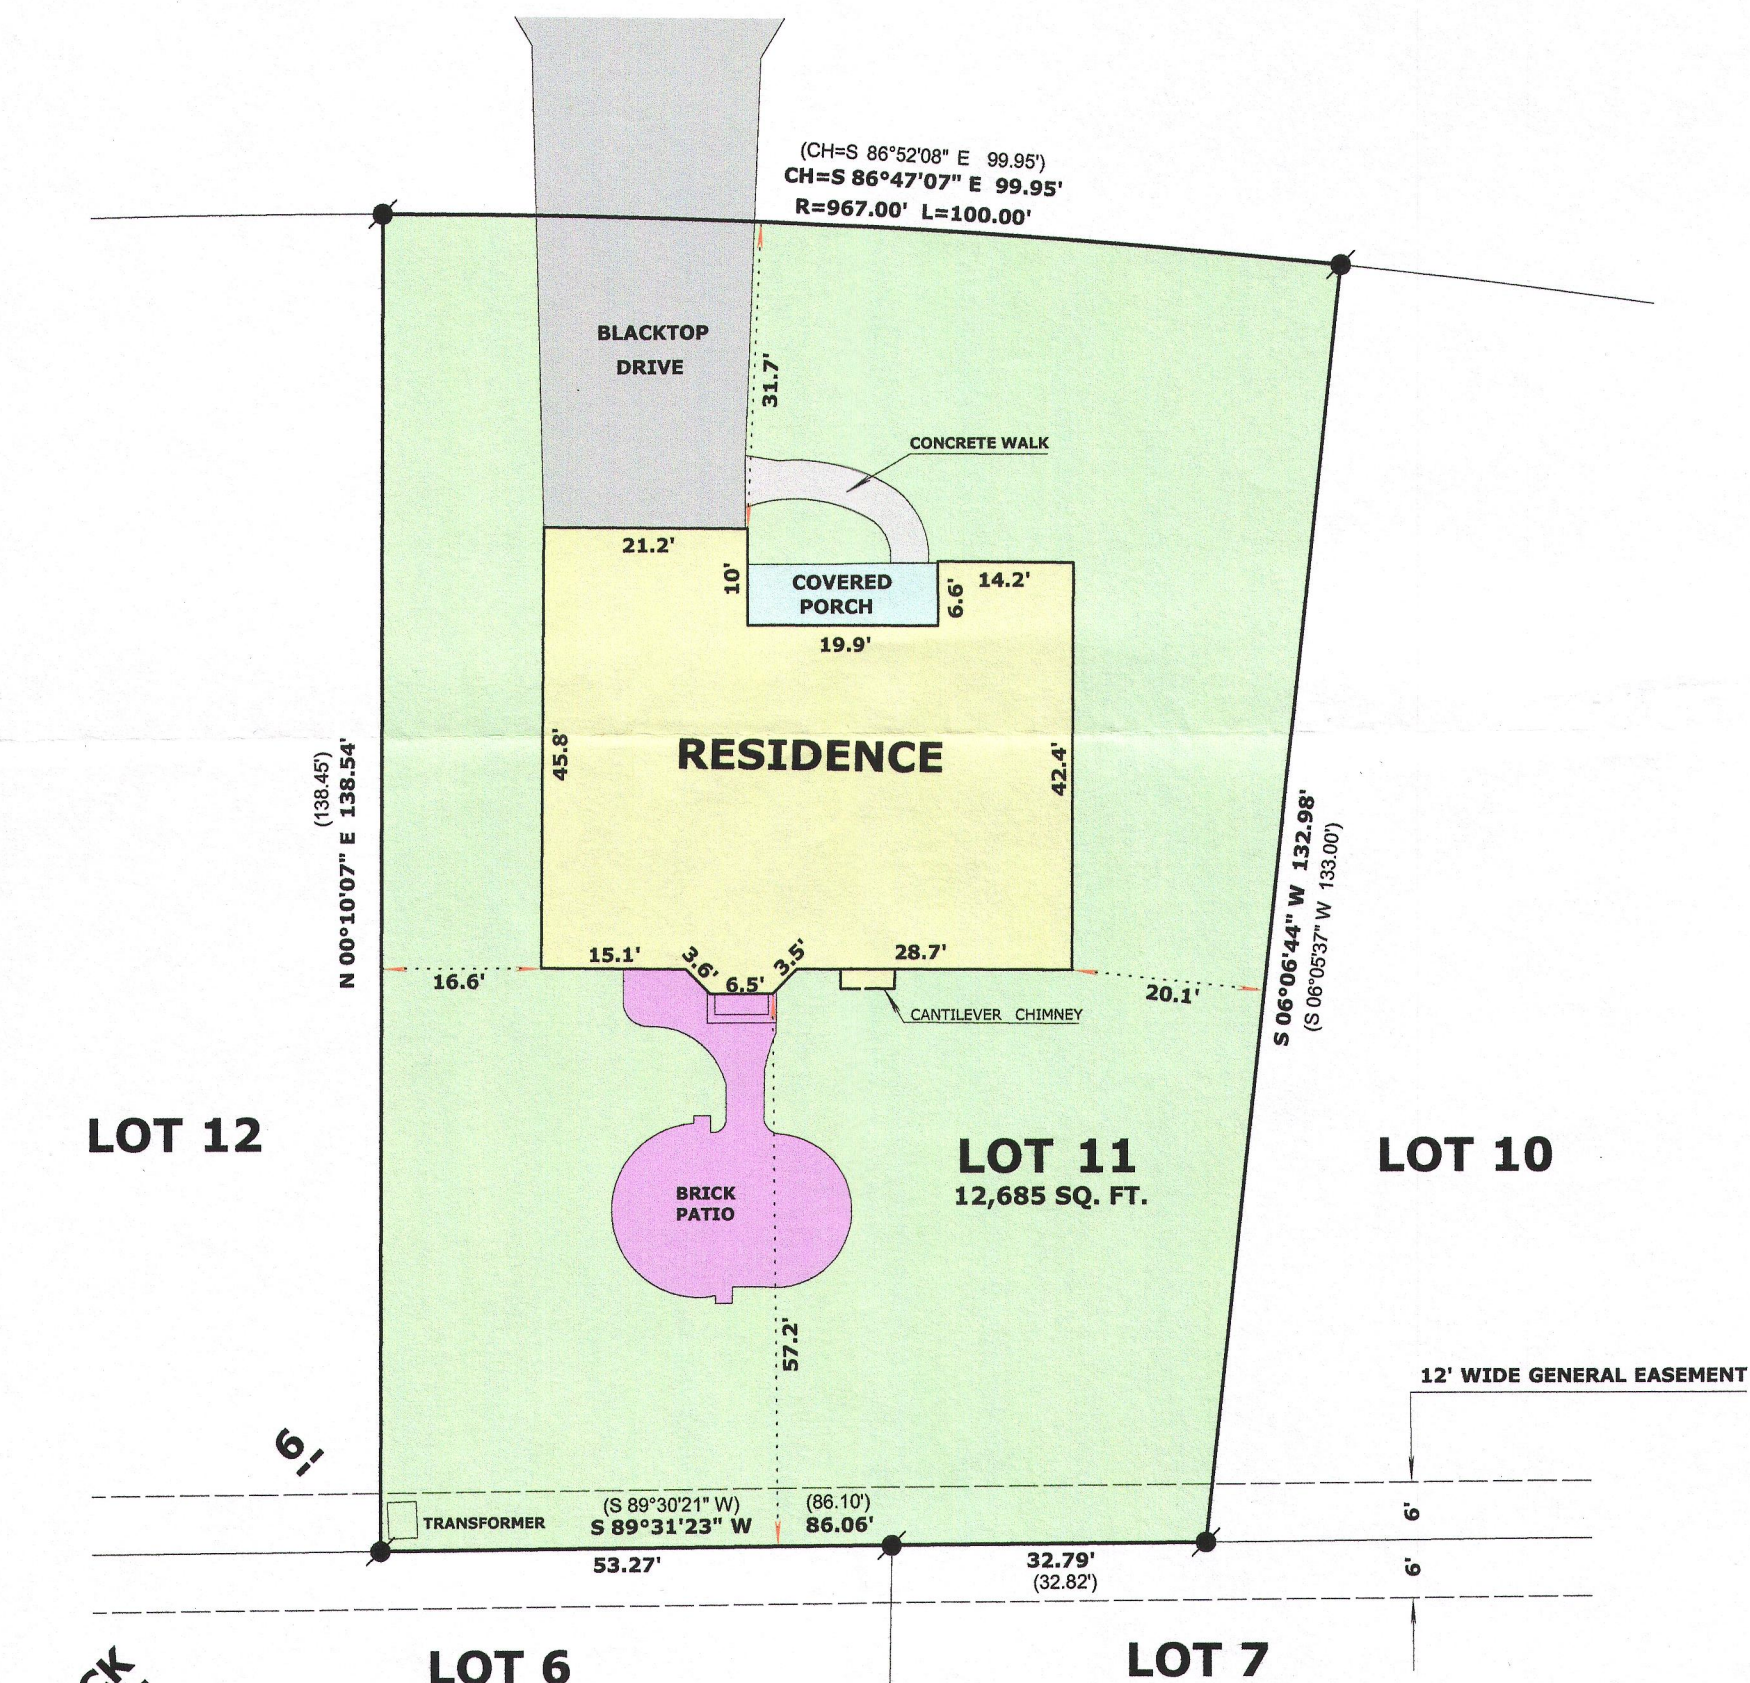


**BLOCK**




## LEGEND

**FOUND IRON ROD 3/4"**

( x x ) RECORDED AS DIMENSION

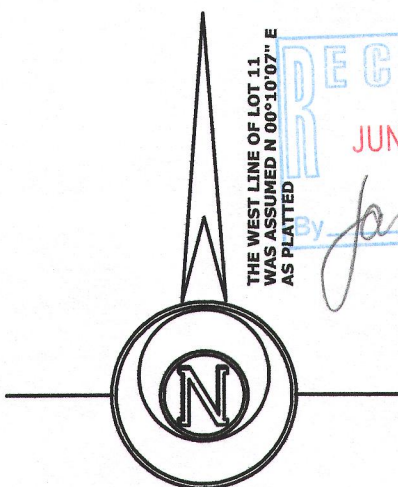

THE WEST LINE OF LOT 11  
WAS ASSUMED N 00°10'07" E  
AS PLATTED

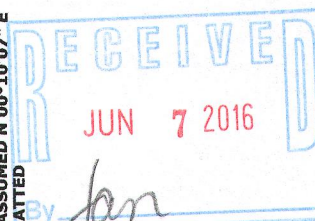

**SCALE: 1 INCH = 20 FEET**

"I hereby certify that the above described property has been surveyed by me or under my direction and that the above map is a true representation thereof and shows the size and location of the property, its exterior boundaries, the location of all visible structures and dimensions of all principal buildings thereon, boundary fences, apparent easements, roadways and visible encroachments, if any."

"This survey is made for the use of the present owners of the property, and also those who purchase, mortgage, or guarantee the title thereto within one year from date hereof."

*Mark L. Miritz*  
**MARK L. MIRITZ**  
**WISCONSIN PROFESSIONAL**  
**LAND SURVEYOR S-2582**