

- ◎ FOUND CONCRETE MONUMENT (AXLERED IN CONCRETE)
- FOUND IRON PIPE
- ♂ FOUND IRON ROD
- SET IRON ROD
- ▣ UTILITY BOX
- ( ) RECORDED AS

*LOT 3*

*LOT 4*

LOT 6

*LOT 5*

LOT 7

*LOT 8*

BLOCK 8

0.47 total acres



PLAT OF SURVEY  
-OF-

LOTS 5 AND 8 IN BLOCK 8 OF ADDITION NO. 1 TO THE VILLAGE OF WILLIAMS BAY,  
ACCORDING TO THE RECORDED PLAT THEREOF. SAID LAND BEING IN THE VILLAGE OF  
WILLIAMS BAY, COUNTY OF WALWORTH AND STATE OF WISCONSIN.

SURVEY FOR: KAREN OSTERMEIER OF KEEFE REAL ESTATE  
SURVEY ADDRESS: 134 ELMHURST STREET, WILLIAMS BAY, WI 53191

0 15' 30' 60

SCALE: 1" = 30'

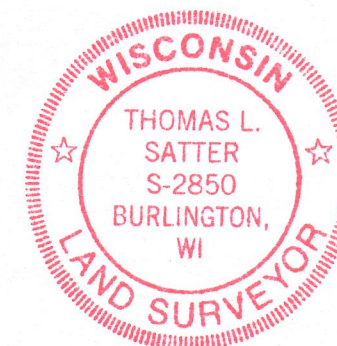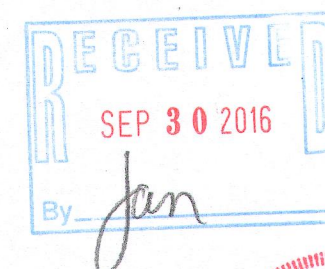

THIS IS NOT AN ORIGINAL PRINT  
UNLESS THIS SEAL IS RED.

Thomas L. Satter

SEPTEMBER 14, 2016  
DATE

091604  
JOB NUMBER

"I HEREBY CERTIFY THAT I HAVE SURVEYED THE ABOVE DESCRIBED PROPERTY AND THAT THE ABOVE MAP IS A CORRECT REPRESENTATION THEREOF AND SHOWS THE SIZE AND LOCATION OF THE PROPERTY, ITS EXTERIOR BOUNDARIES, THE LOCATION OF ALL VISIBLE STRUCTURES AND DIMENSIONS OF ALL PRINCIPAL BUILDINGS THEREON, BOUNDARY FENCES, APPARENT EASEMENTS, ROADWAYS AND ENCROACHMENTS, IF ANY."

"THIS SURVEY IS MADE FOR THE USE OF THE PRESENT OWNERS OF THE PROPERTY, AND THOSE WHO PURCHASE, MORTGAGE, OR GUARANTEE THE TITLE THERETO WITHIN ONE YEAR FROM DATE HEREOF."

***SATTER SURVEYING, LLC***  
LAND SURVEYS, MAPPING AND PLANNING  
272 ORIGIN STREET  
BURLINGTON, WI 53105  
262-661-4239

WOP-111 011-2676