


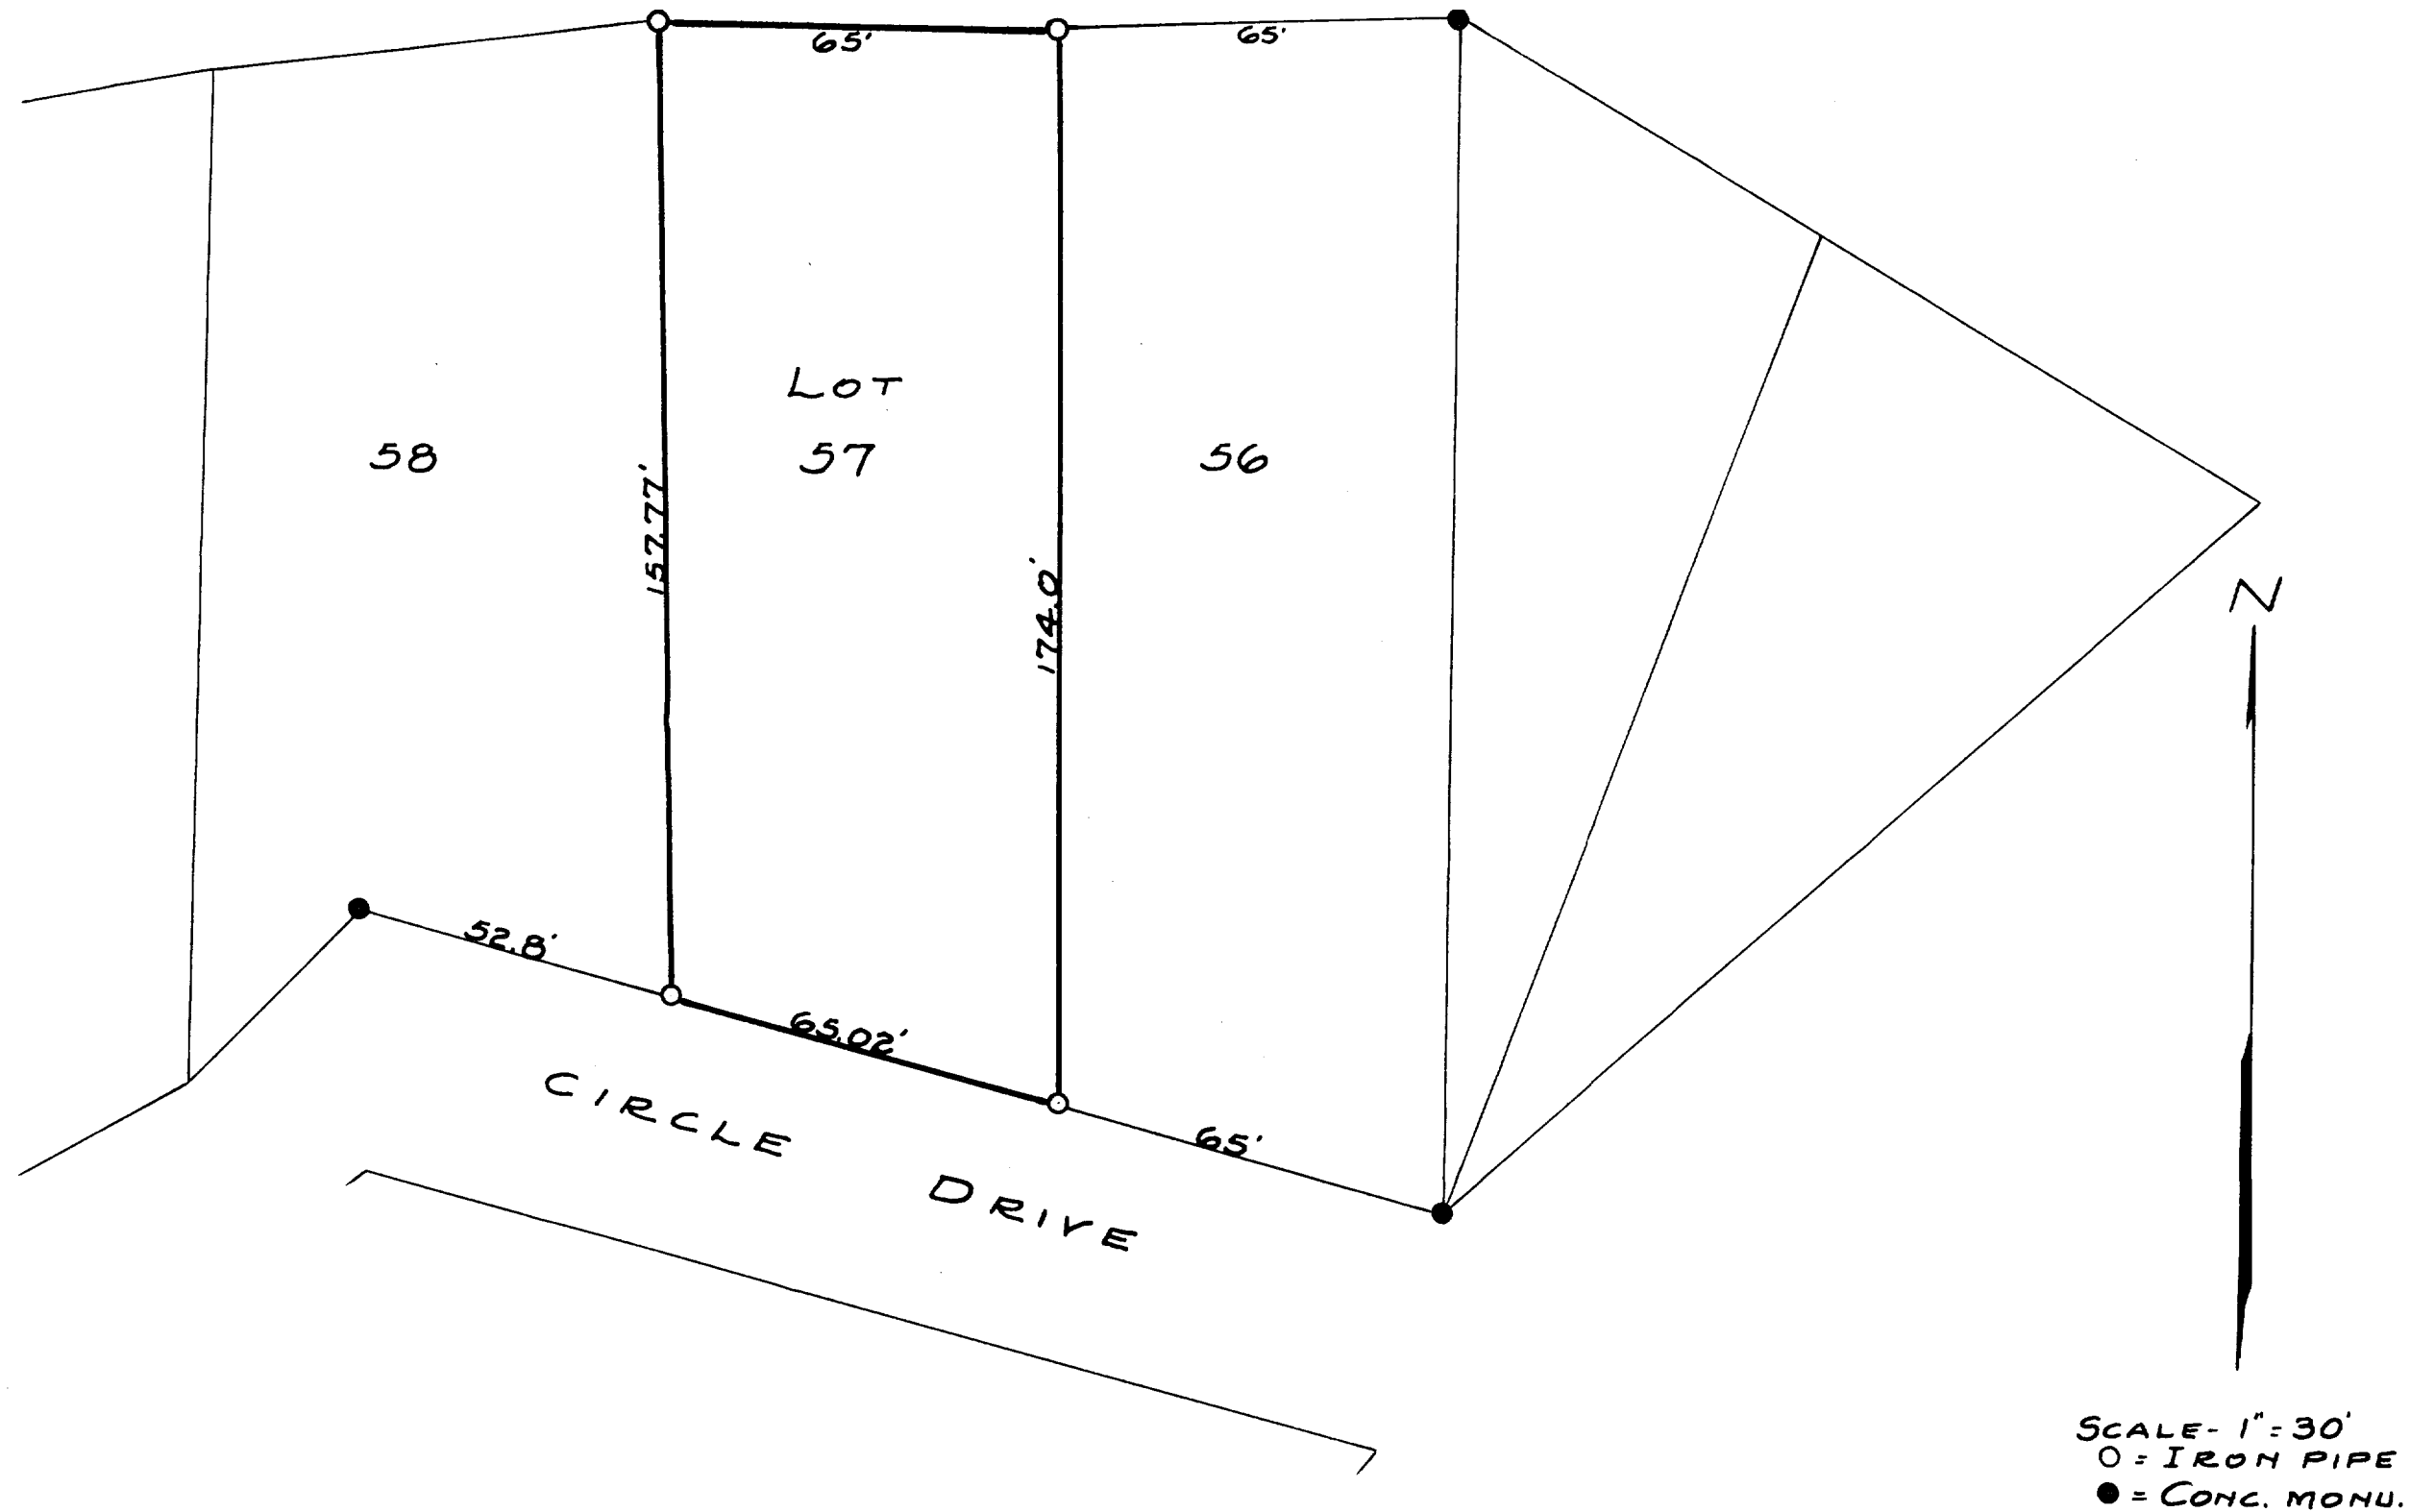

PLAT OF SURVEY OF LOT 57 OF THE 1ST. ADDITION TO CEDAR POINT
 PARK SUDD. LOCATED IN THE VILLAGE OF WILLIAMS BAY,
 WALWORTH COUNTY WISCONSIN.

Lloyd L. Jensen
 COUNTY SURVEYOR

11-26 J