

Plat of Survey

of

Lot 9 in Block 2 of University Heights,

a subdivision located in the Northwest 1/4 of the Southeast 1/4 of Section 1, Town 1 North, Range 16 East, Village of Williams Bay, Walworth County, Wisconsin.


Surveyed for: **Jeff Wolski**
72 Stam Street
Williams Bay, Wisconsin. 53191

Lot 9
Tax Parcel
WUH 00012
0.692 Acre
30,150 Sq.Ft.



House
No. 72

Approx. floor
Elev.=98.1.

Stam Street
(49.5' Wide)

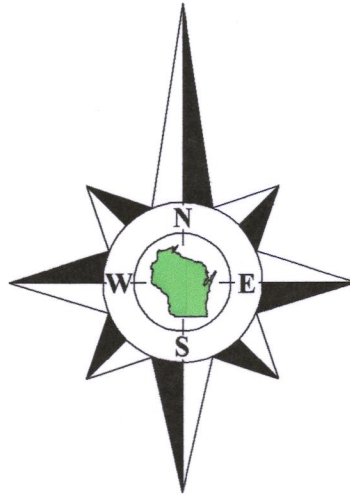

Bearings referenced to the West line of Stam Street,
recorded as (N0°46'W) on the plat of University Heights.

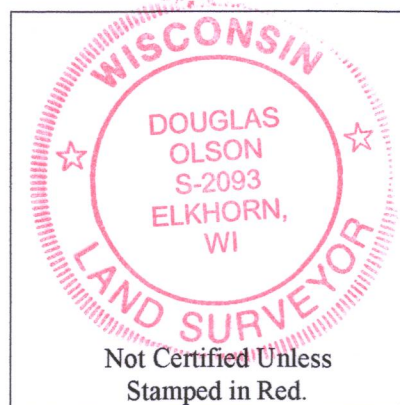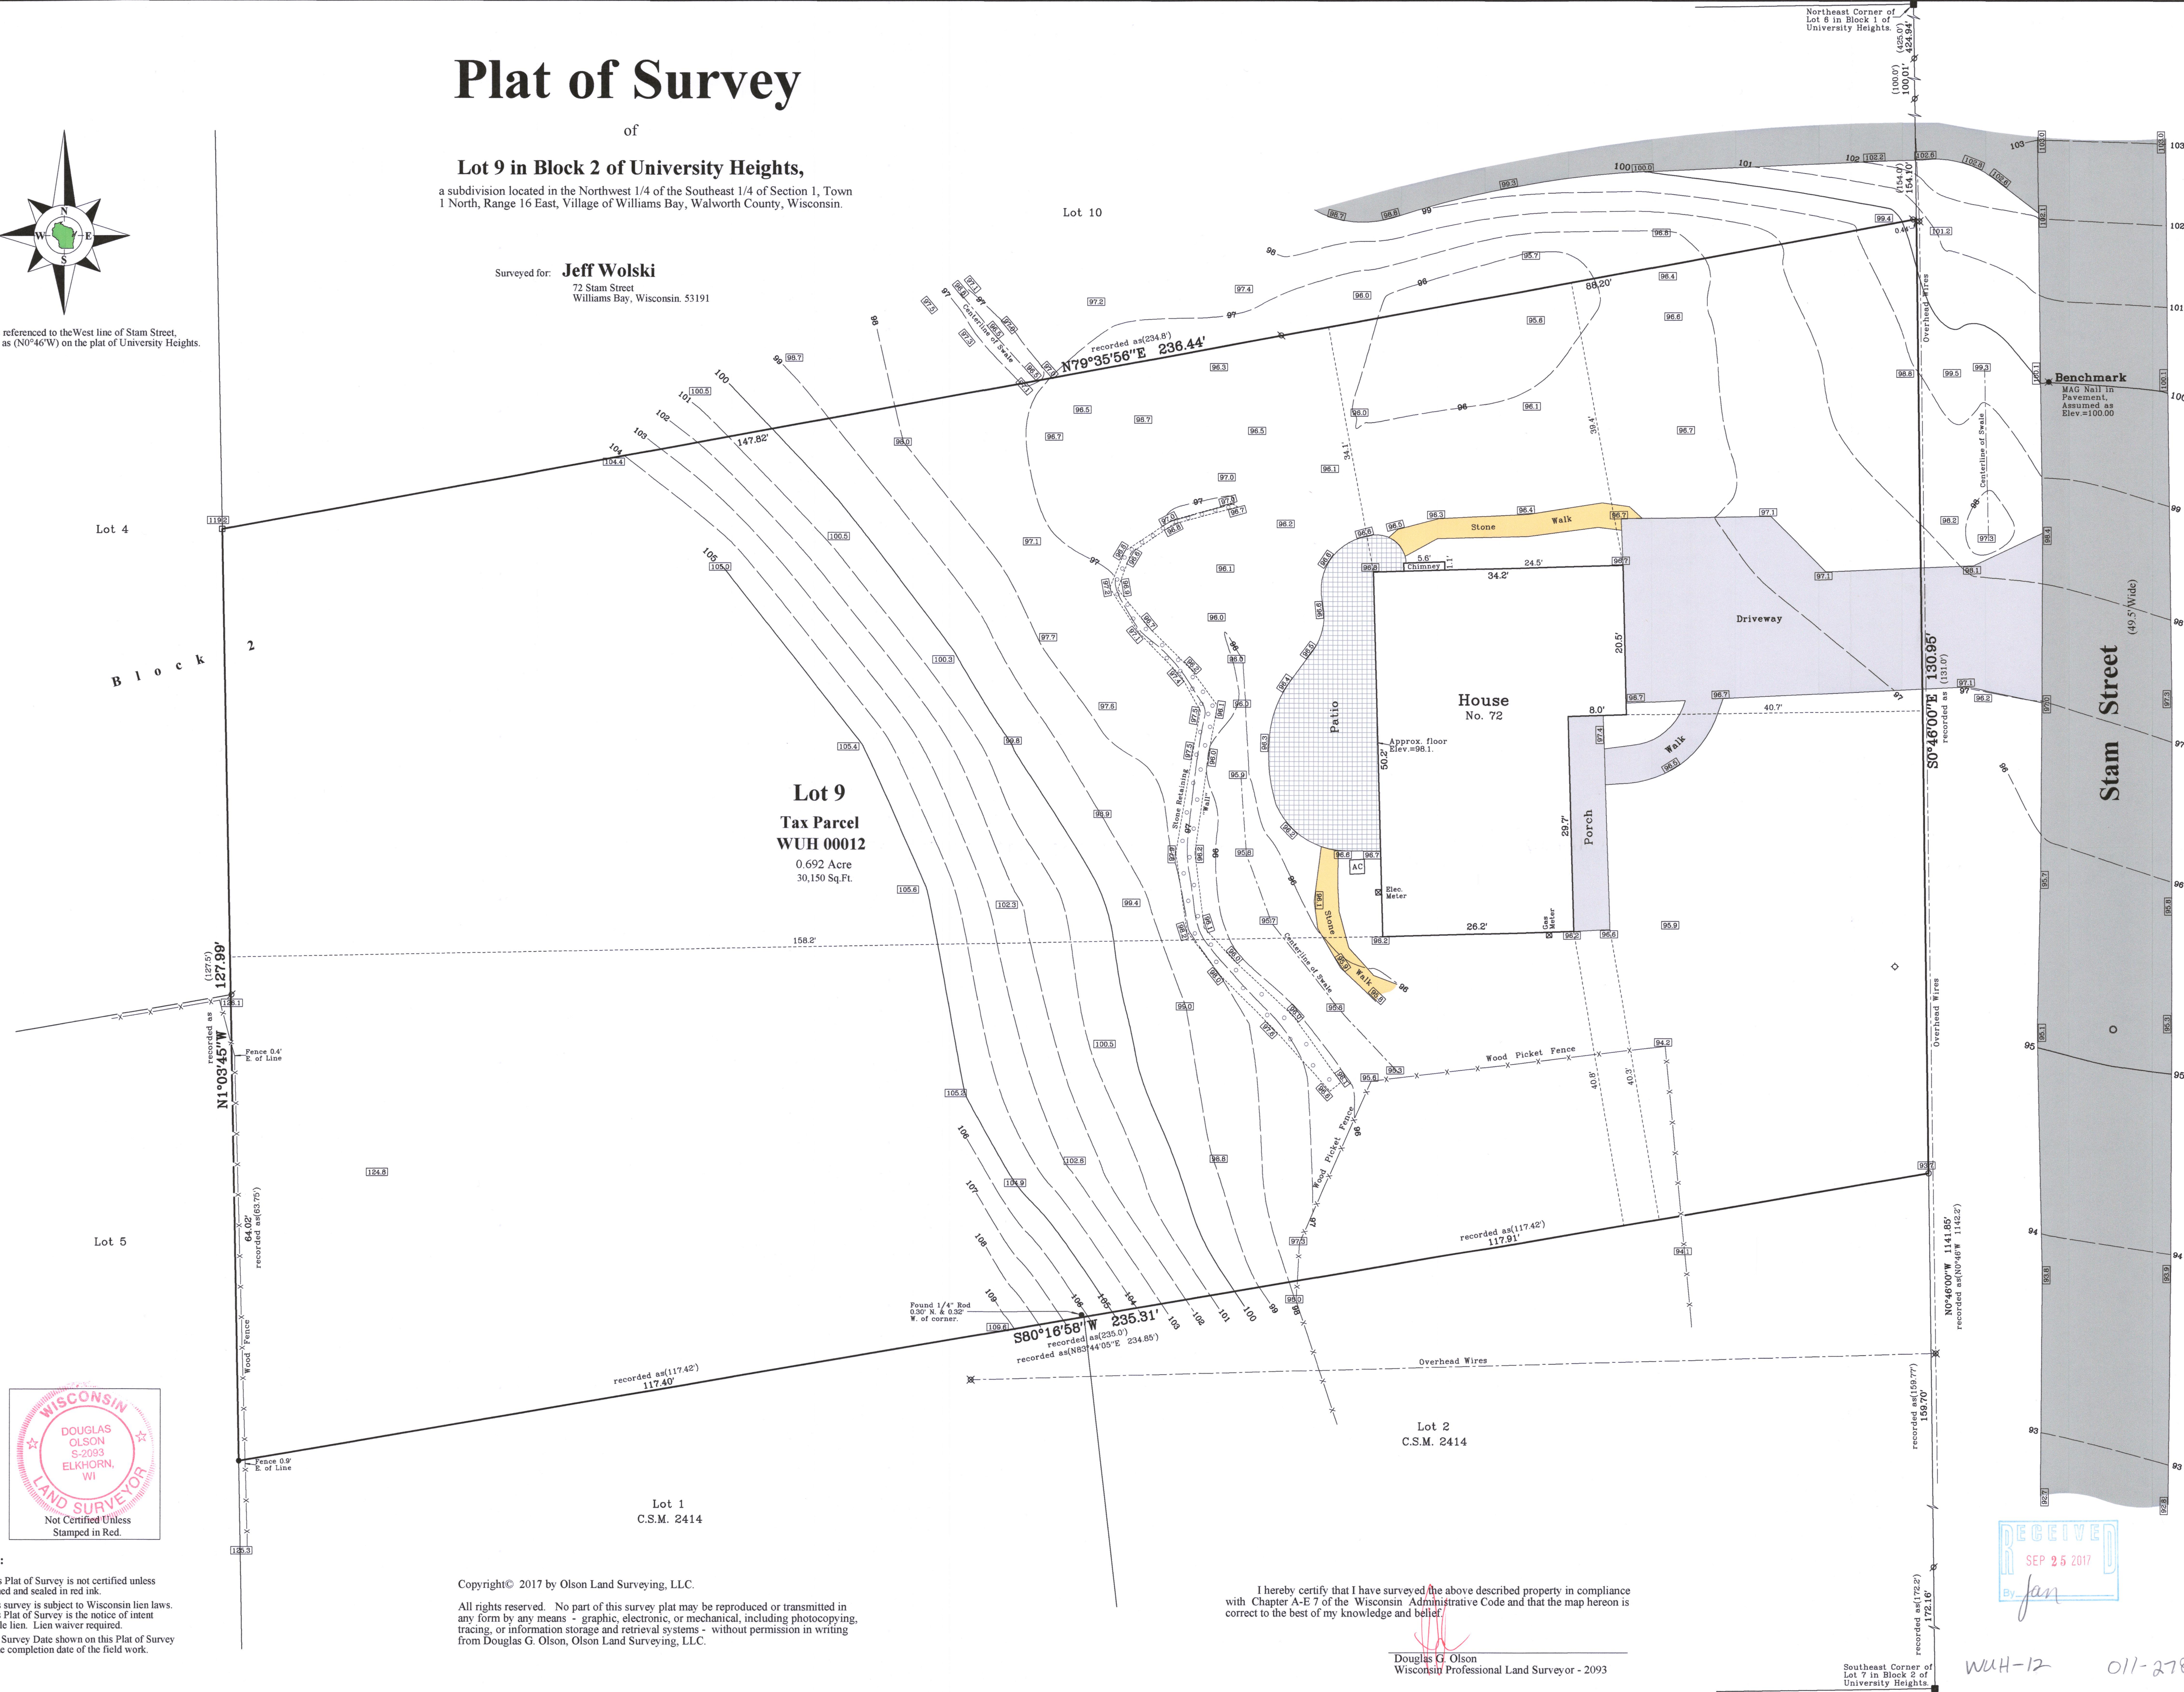

Notes:

- 1) This Plat of Survey is not certified unless signed and sealed in red ink.
- 2) This survey is subject to Wisconsin lien laws. This Plat of Survey is the notice of intent to file lien. Lien waiver required.
- 3) The Survey Date shown on this Plat of Survey is the completion date of the field work.

Copyright© 2017 by Olson Land Surveying, LLC.

All rights reserved. No part of this survey plat may be reproduced or transmitted in any form by any means - graphic, electronic, or mechanical, including photocopying, tracing, or information storage and retrieval systems - without permission in writing from Douglas G. Olson, Olson Land Surveying, LLC.

I hereby certify that I have surveyed the above described property in compliance with Chapter A-E 7 of the Wisconsin Administrative Code and that the map hereon is correct to the best of my knowledge and belief.

Douglas G. Olson
Wisconsin Professional Land Surveyor - 093



WUH-12 011-2782

Survey date: March 20, 2017.

Revisions:

Scale in Feet
1" = 10'



45 South Wisconsin Street | P.O. Box 322
Elkhorn, Wisconsin. 53121
Telephone: (262) 723-3434
Facsimile: (262) 723-8044
Email: doug@olsonsurveying.com
Website: www.olsonsurveying.com

OLSON
LAND SURVEYING, LLC
Rural | Residential | Commercial

Legend of Symbols & Abbreviations
Found Concrete Monument
Found Iron Pin in Concrete
Found Iron Rod, 1/4" dia.
Found Iron Rod, 1/2" dia.
Recorded Information
Utility Pole
Marble
Asphalt Surface
Concrete Surface
Stone Wall
Brick Pavement

Sheet 1 of 1 Sheets

Job Reference Number
2017.017

2017.017